

0376_805

RENISON LIMITED

Sligo 3 Lift 4

MASTER PLAN

SCALE 1: 500


DATE 21-NOV-95

LEVEL 38

209: 004/01

WEST COAST SURVEYS PTY LTD


Uppers were fired to complete this lift. No fill was placed. Voids were broken into and could only be surveyed by remote.

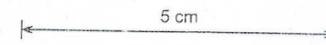

0376_805

E 43600

Voids filled into

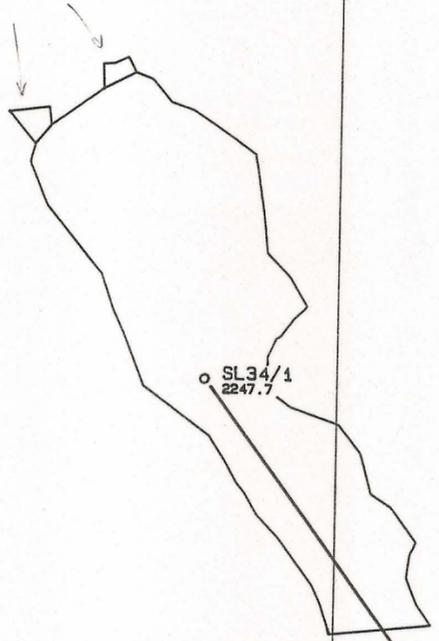

SL34/1
2247.7

A3296
2241.9

A3009
2244.0

N 66300

NValk