

0376_807

HENISON LIMITED

ELDON 2, LIFT 4.
MASTER PLAN


SCALE 1: 500

DATE 15-NOV-95

LEVEL

211: 004/01


WEST COAST SURVEYS PTY LTD

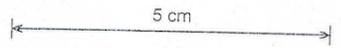

0376_807

0080

13900

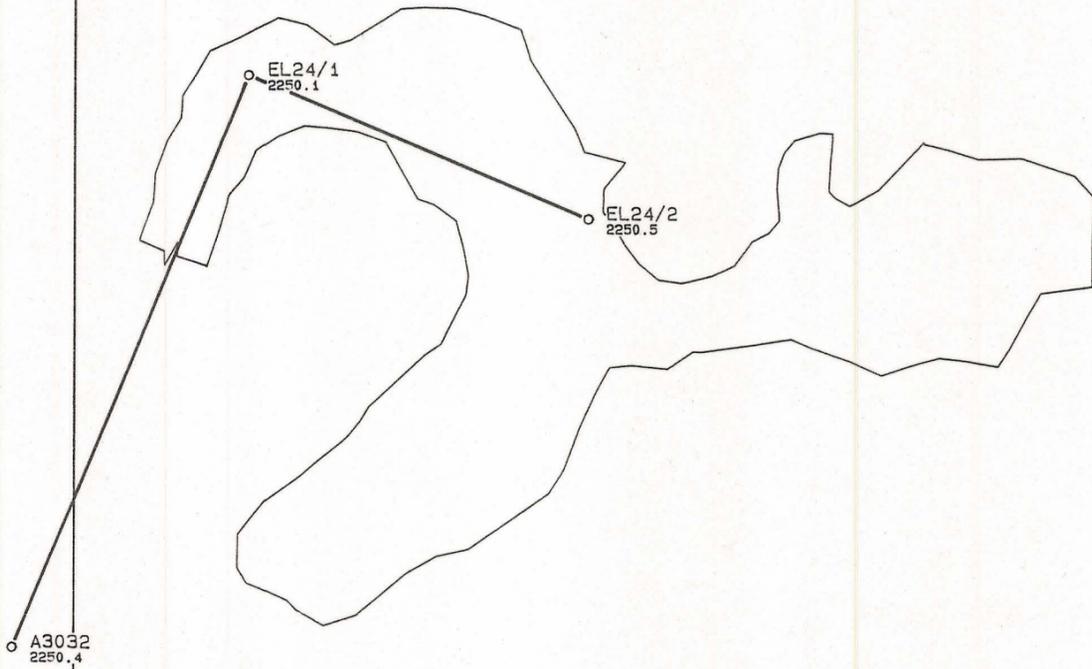

N Valk