

0376\_808

43800

RENISON LIMITED


Eldon 2 Lift 5

MASTER PLAN

SCALE	1: 500	211: 005/01
DATE	5-JAN-96	
LEVEL		

WEST COAST SURVEYS PTY LTD

Flatbacking Stope with uppers  
fired at end of stope. Heights  
in this area are estimates only.

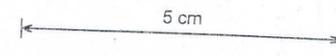

0376\_808

*[Signature]* N Valk

