

0376_809

E 44200

RENISON UNLIMITED

Dreadnought 2060 Lift 3
MASTER PLAN

SCALE 1: 500

DATE 16-MAR-95

LEVEL 205


139: 003/

WEST COAST SURVEYS PTY LTD

Lift 3 of this stope follows c
from Dreadnought S45 Lift 2. I
is the first to be called DNT2

5 cm

0376_809

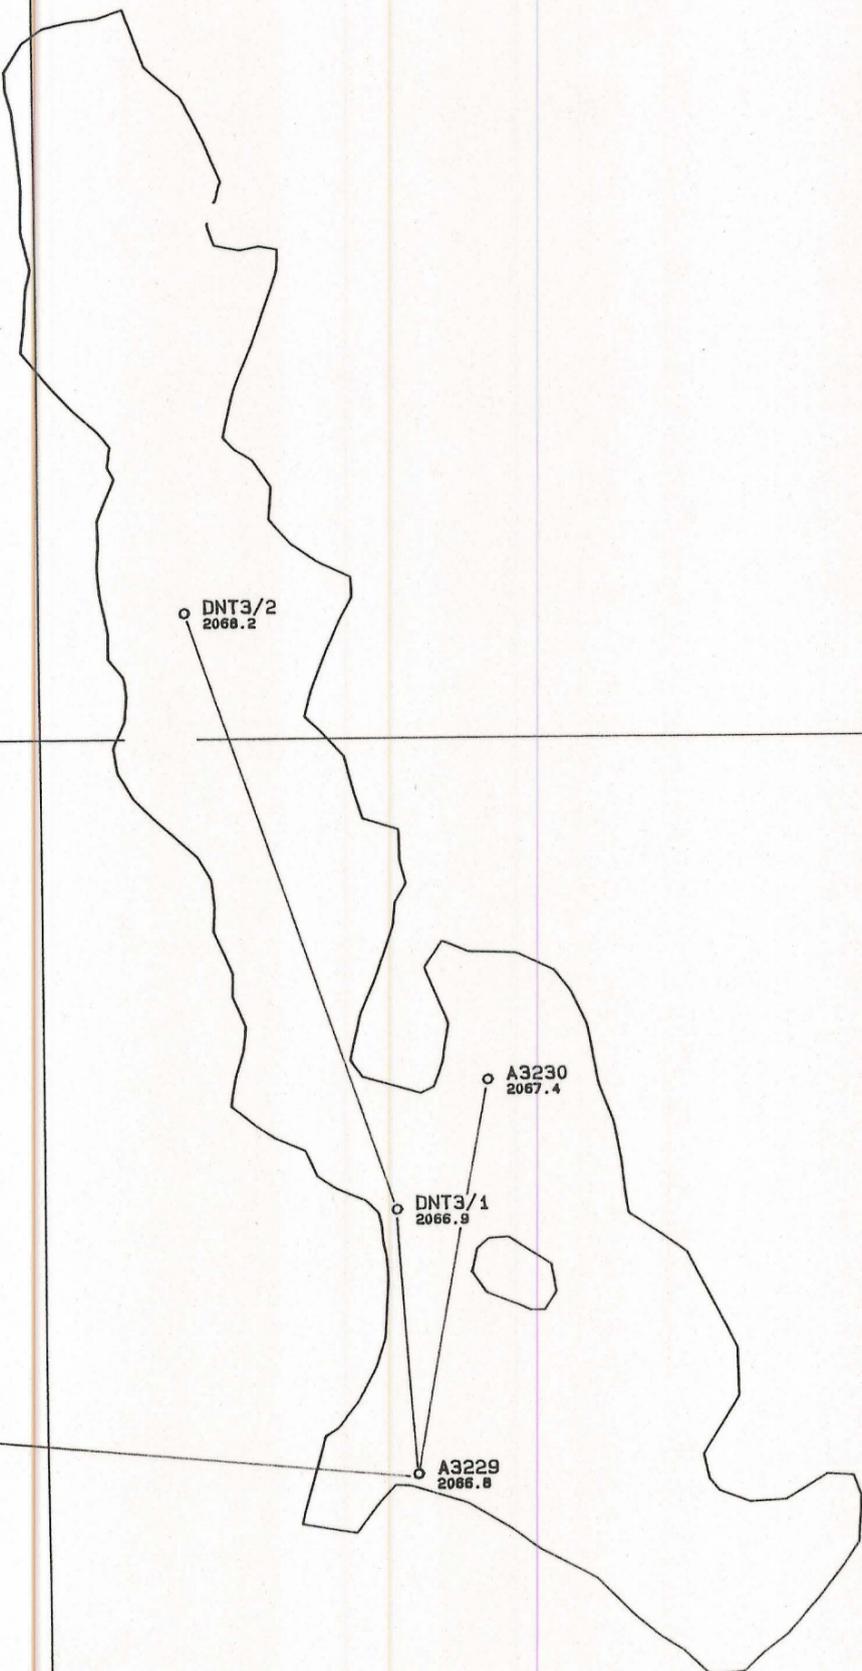

[Handwritten signature]
N Volk