


0376_810

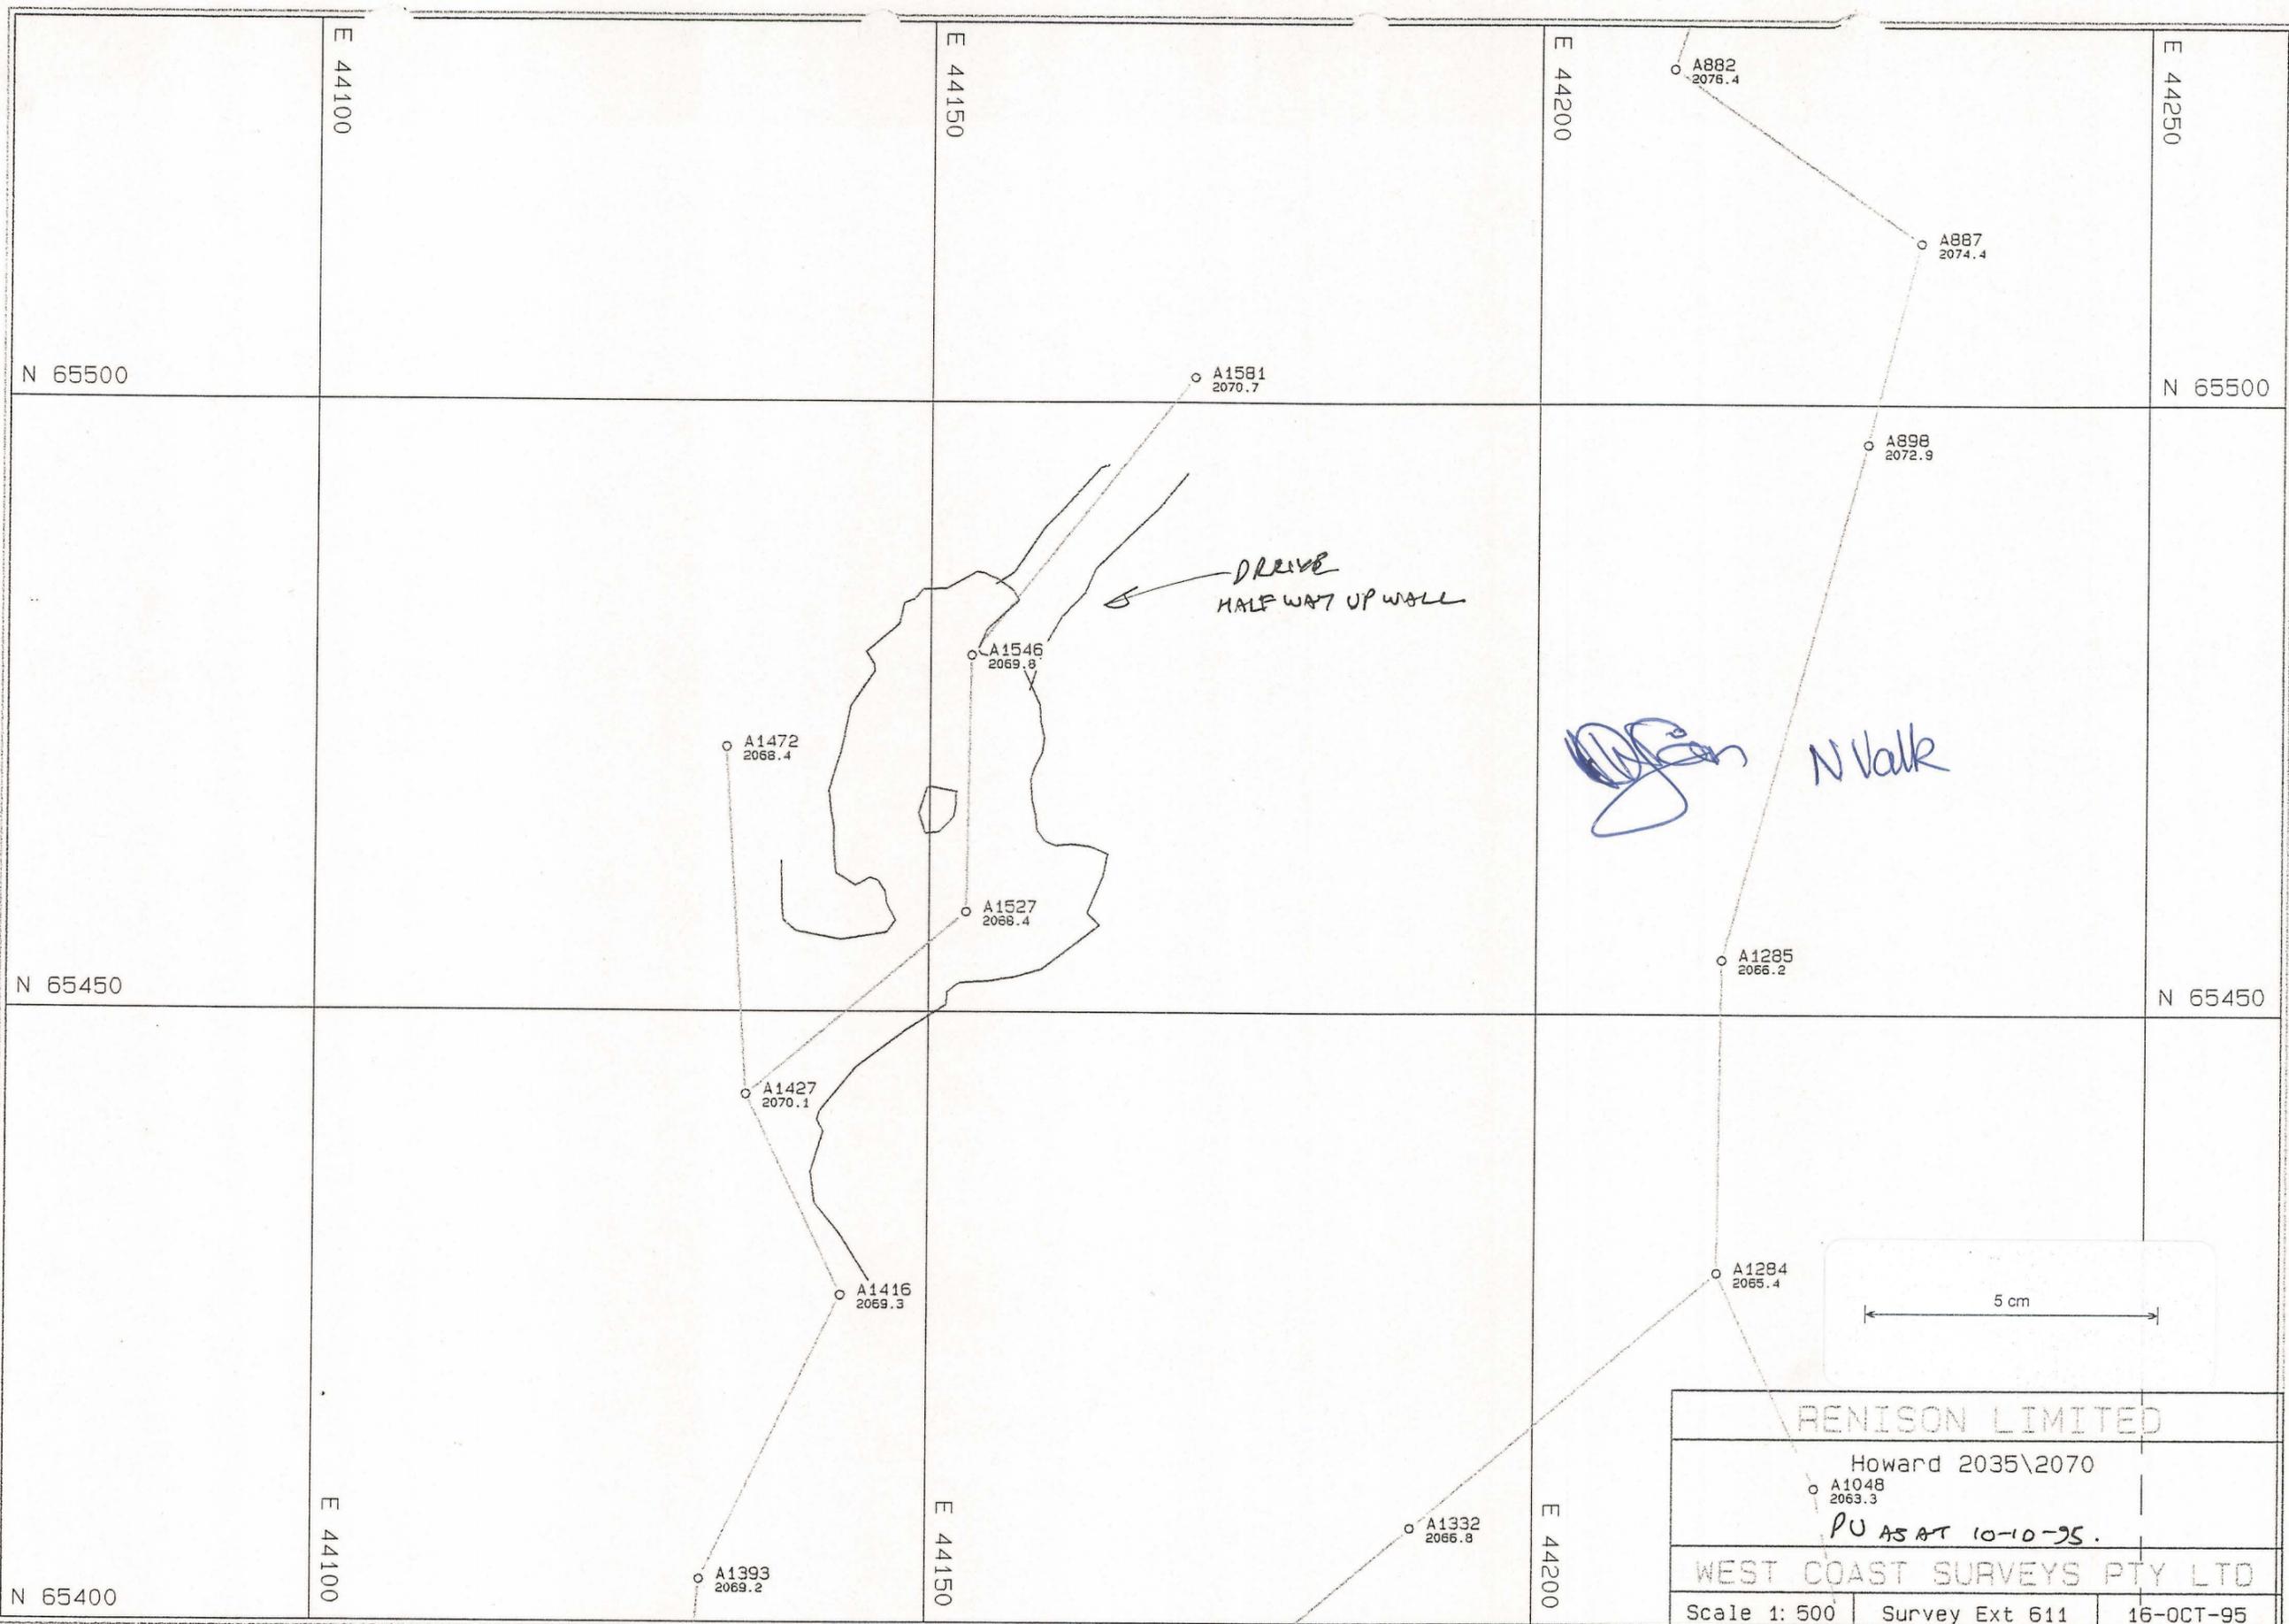

HOWARB.PF

0376_810