


0376_811

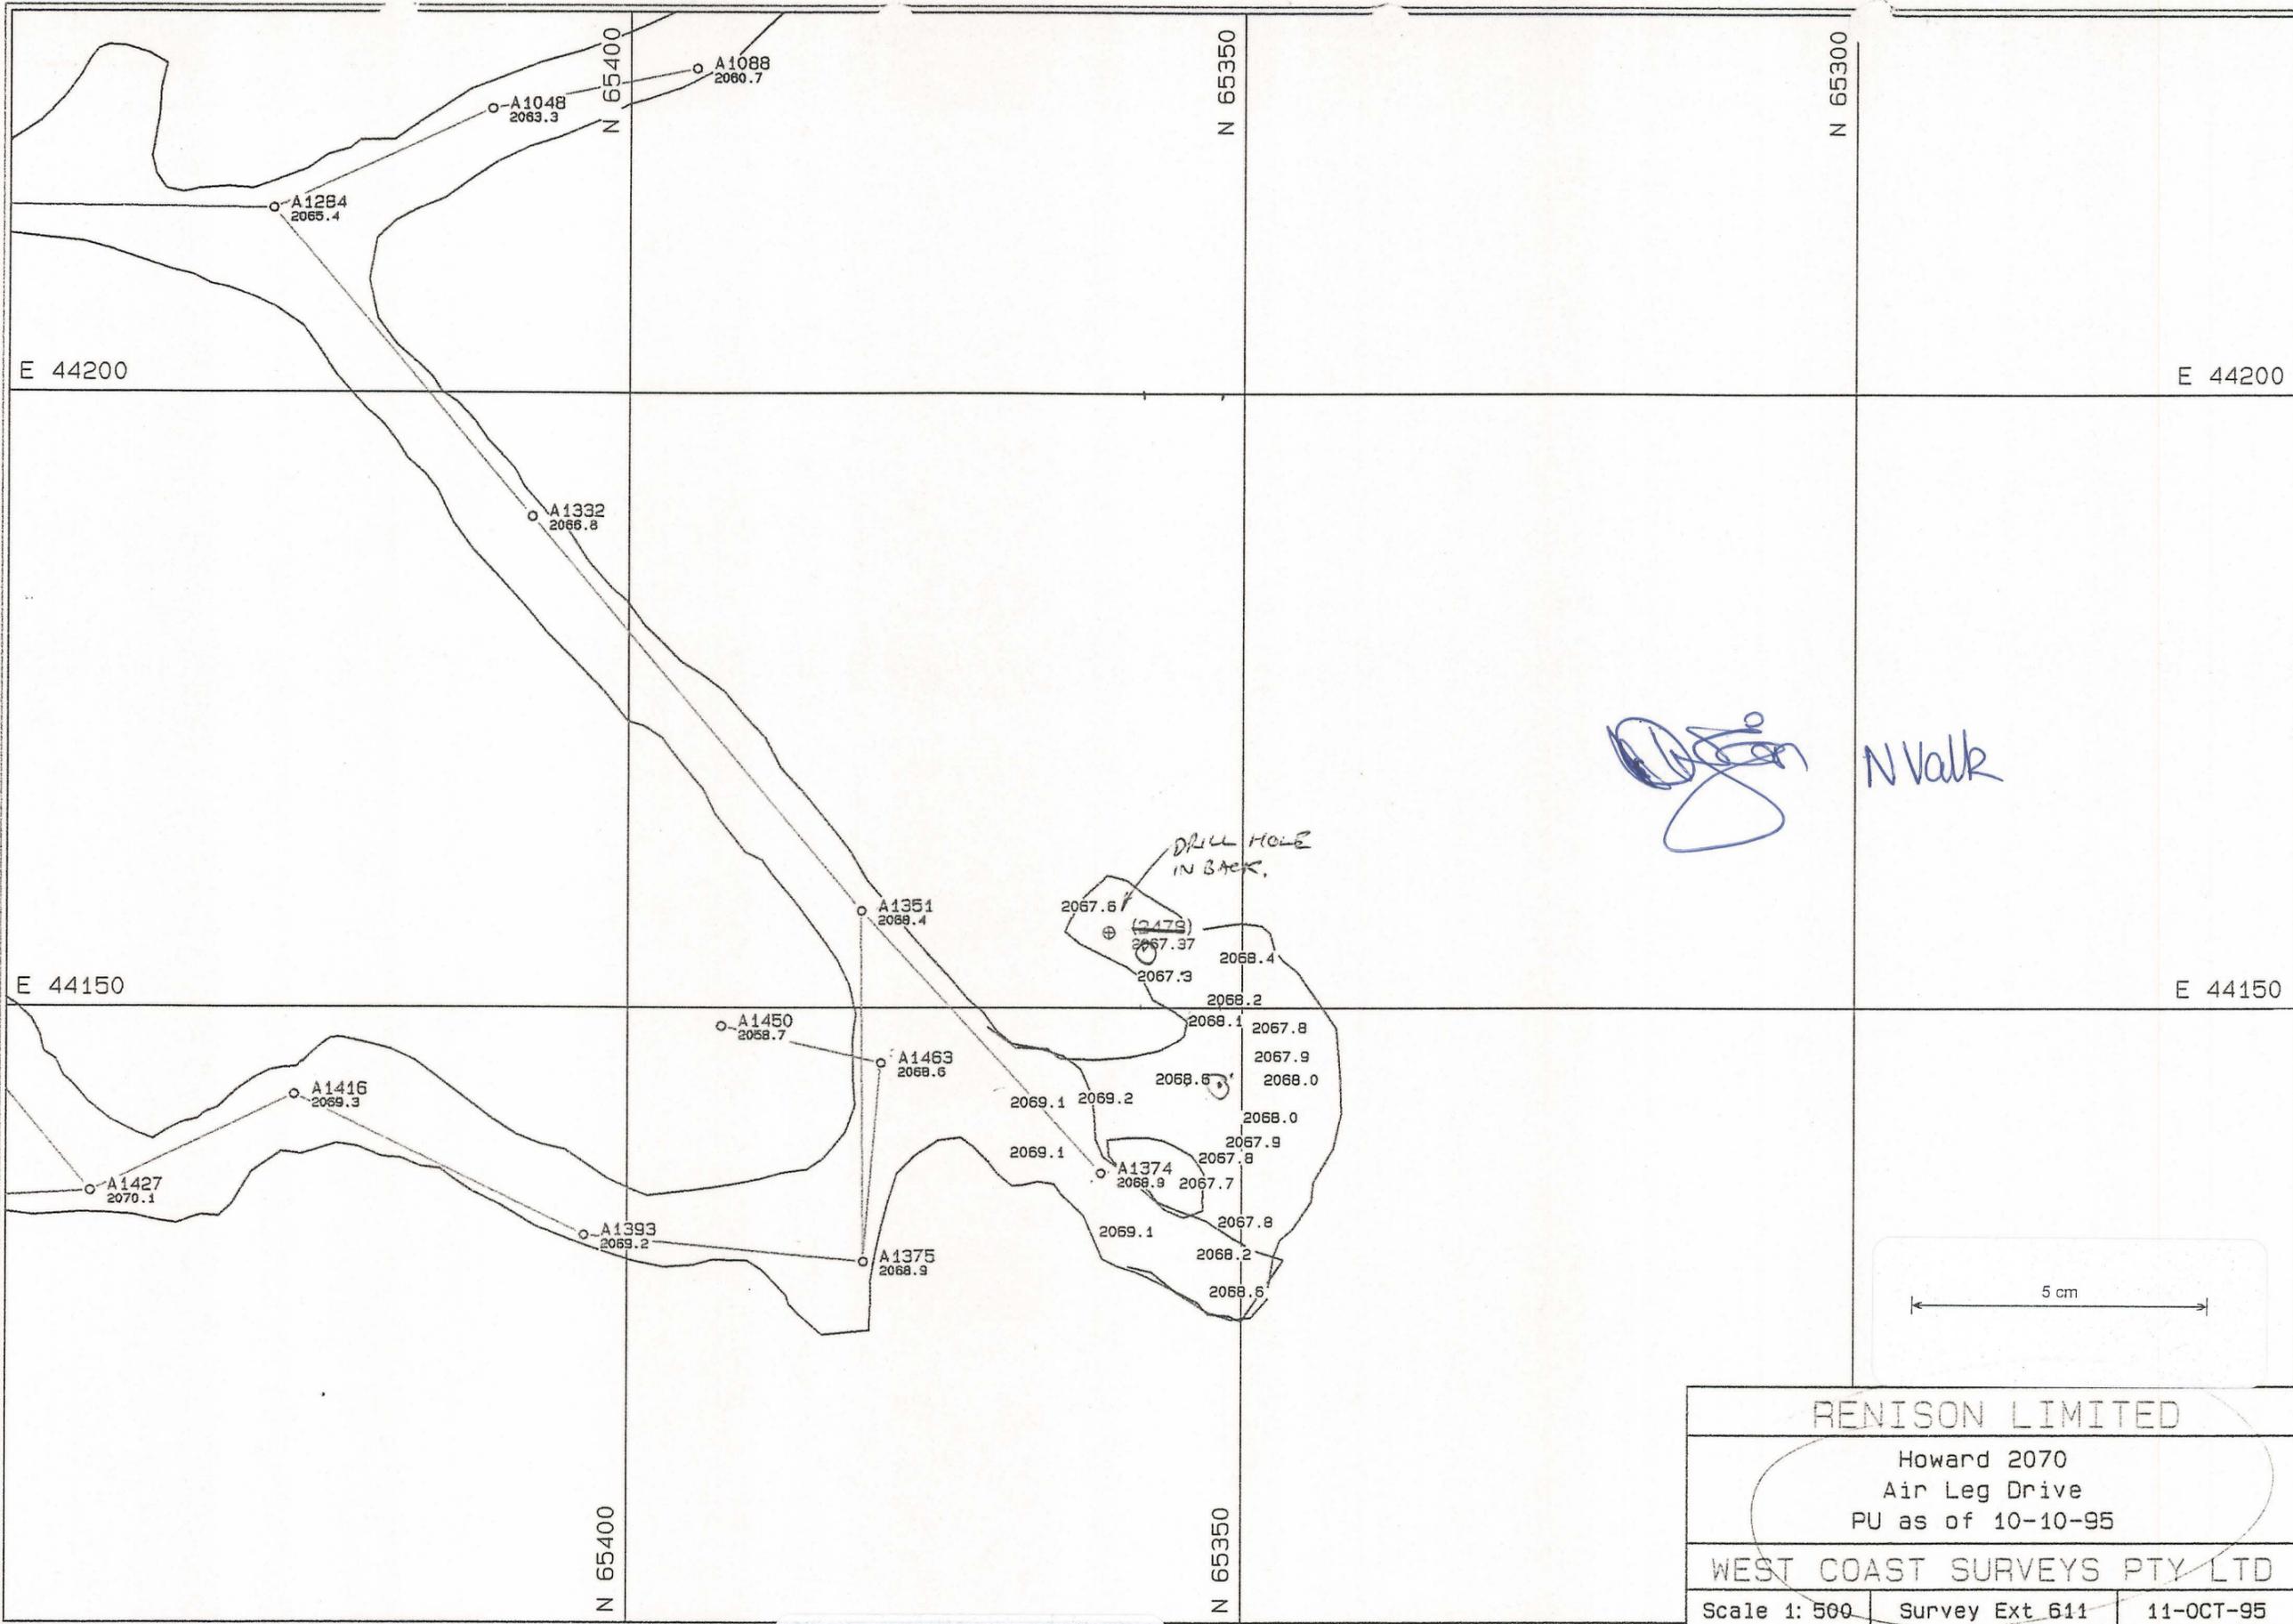

HOWARA.PF

0376_811