


0376_812

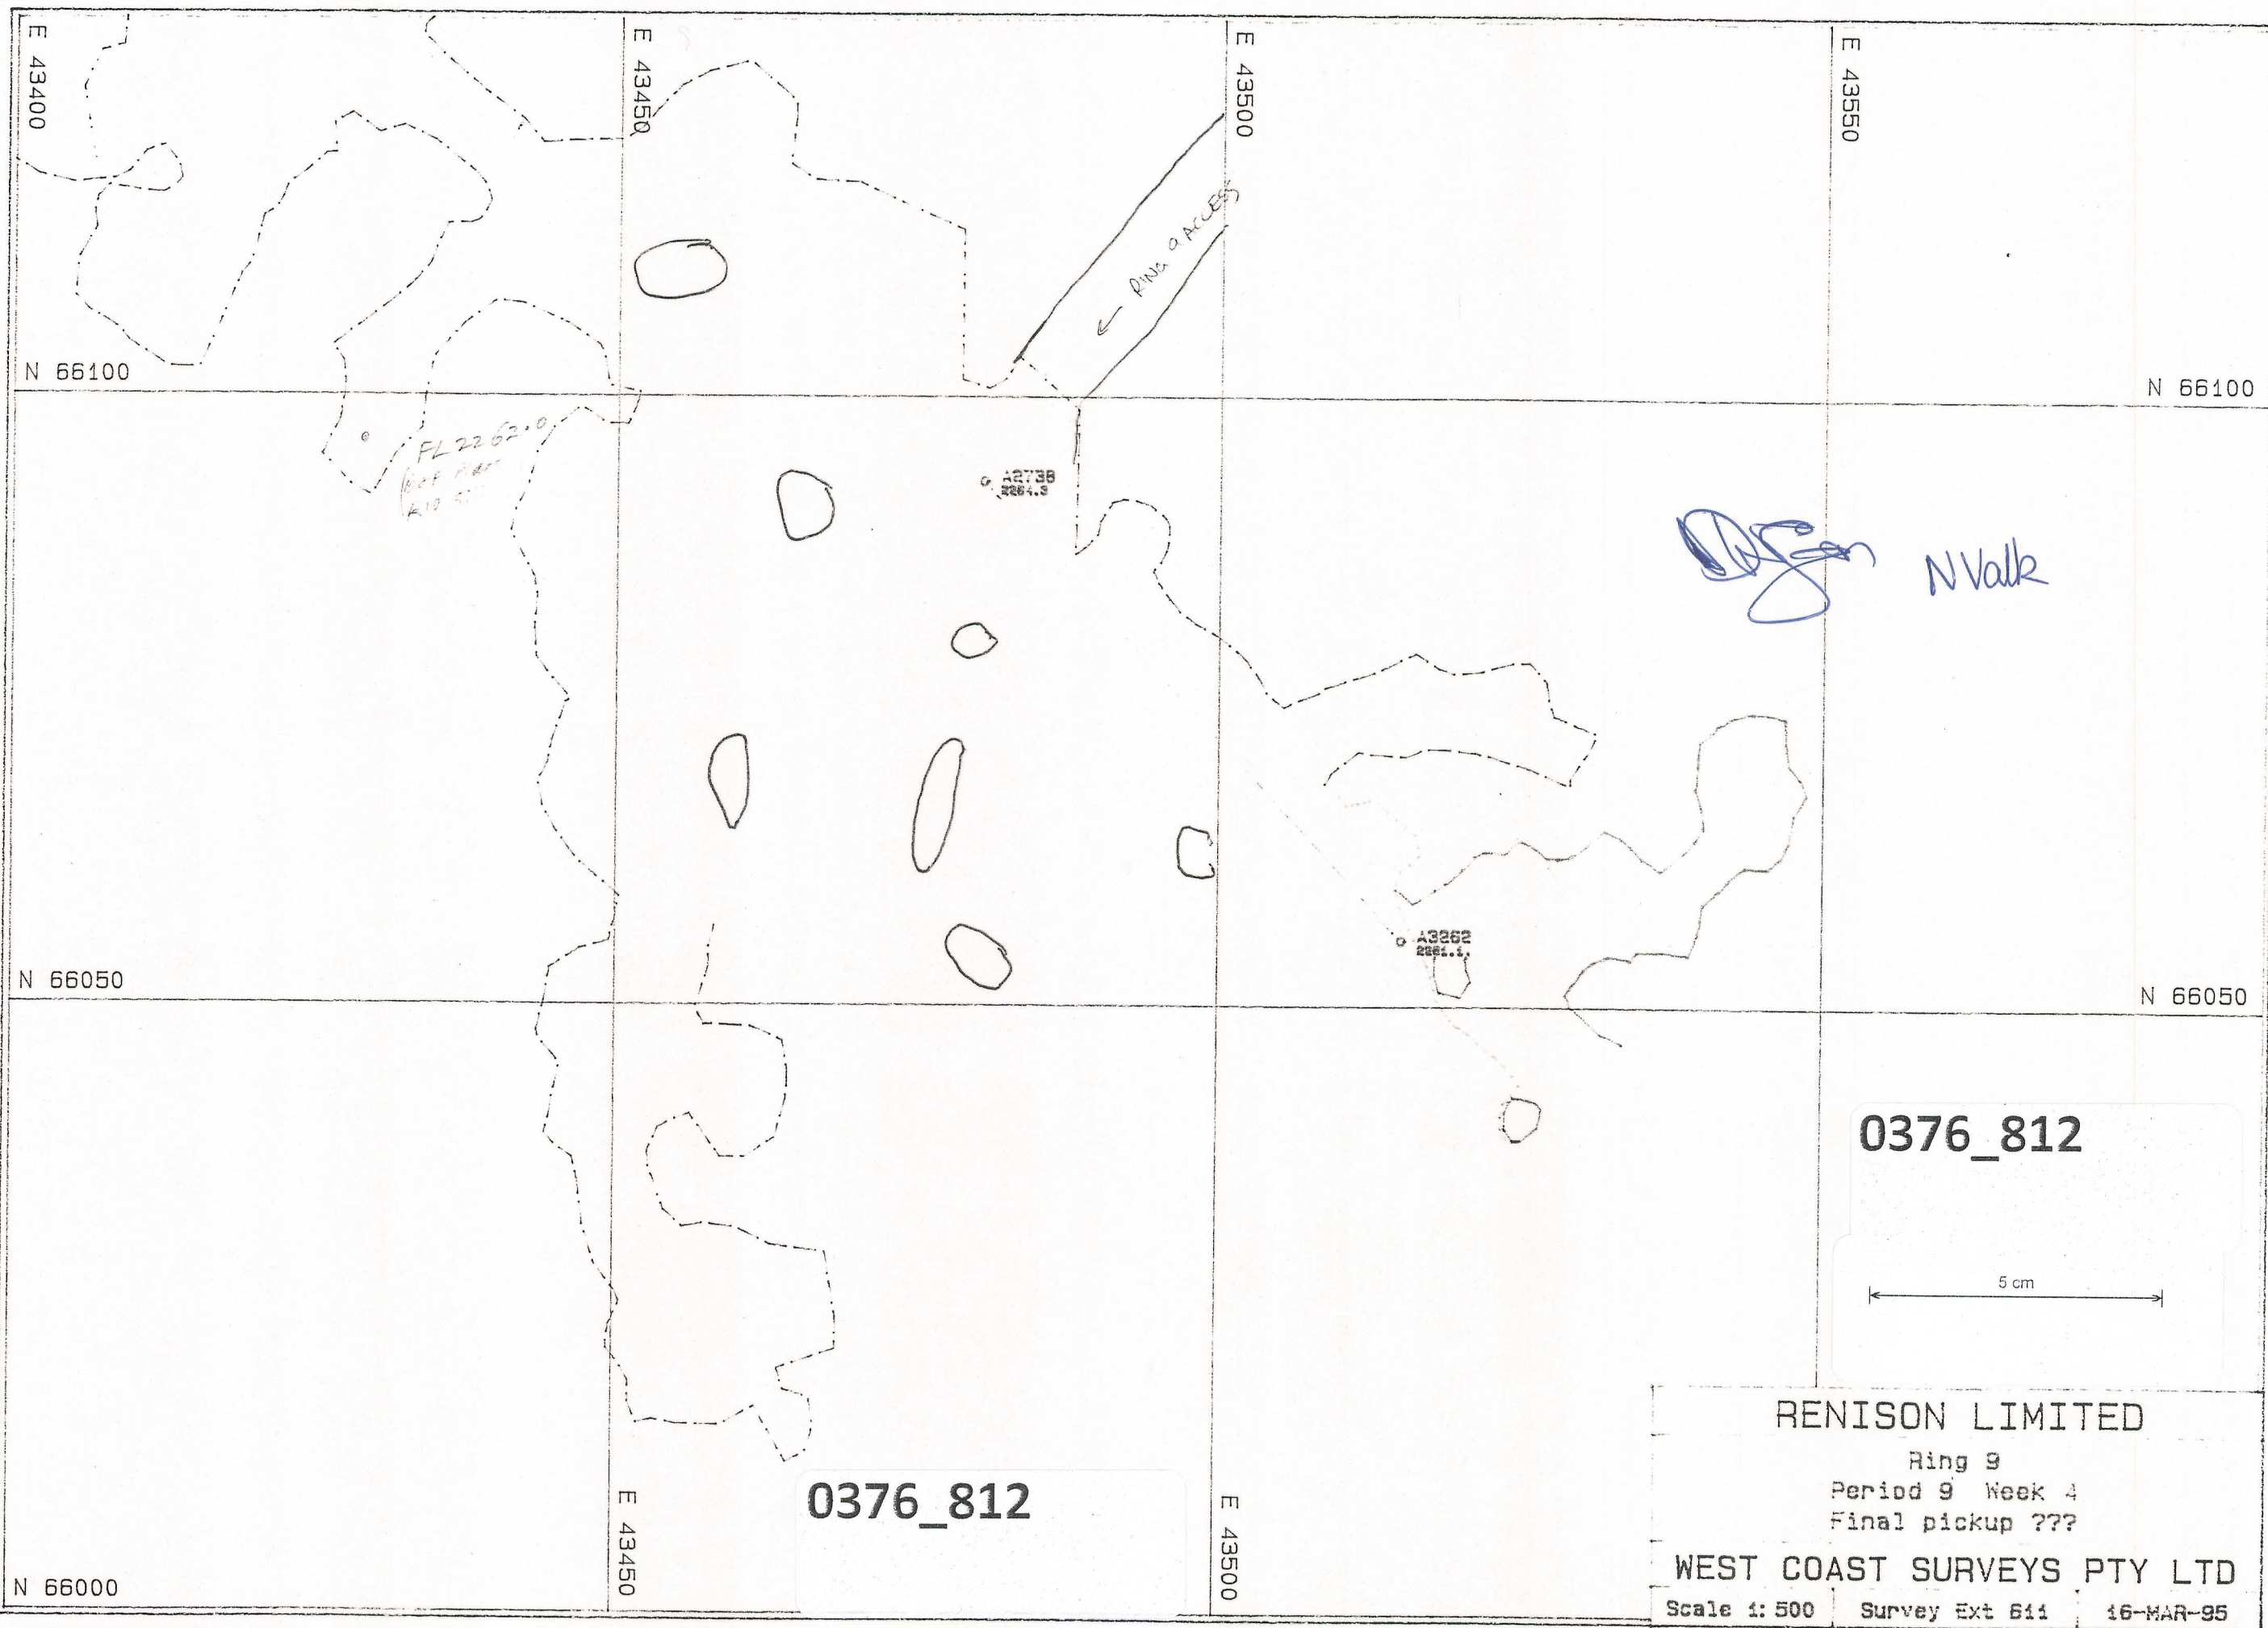

RING9C.PF

X