



0376_813

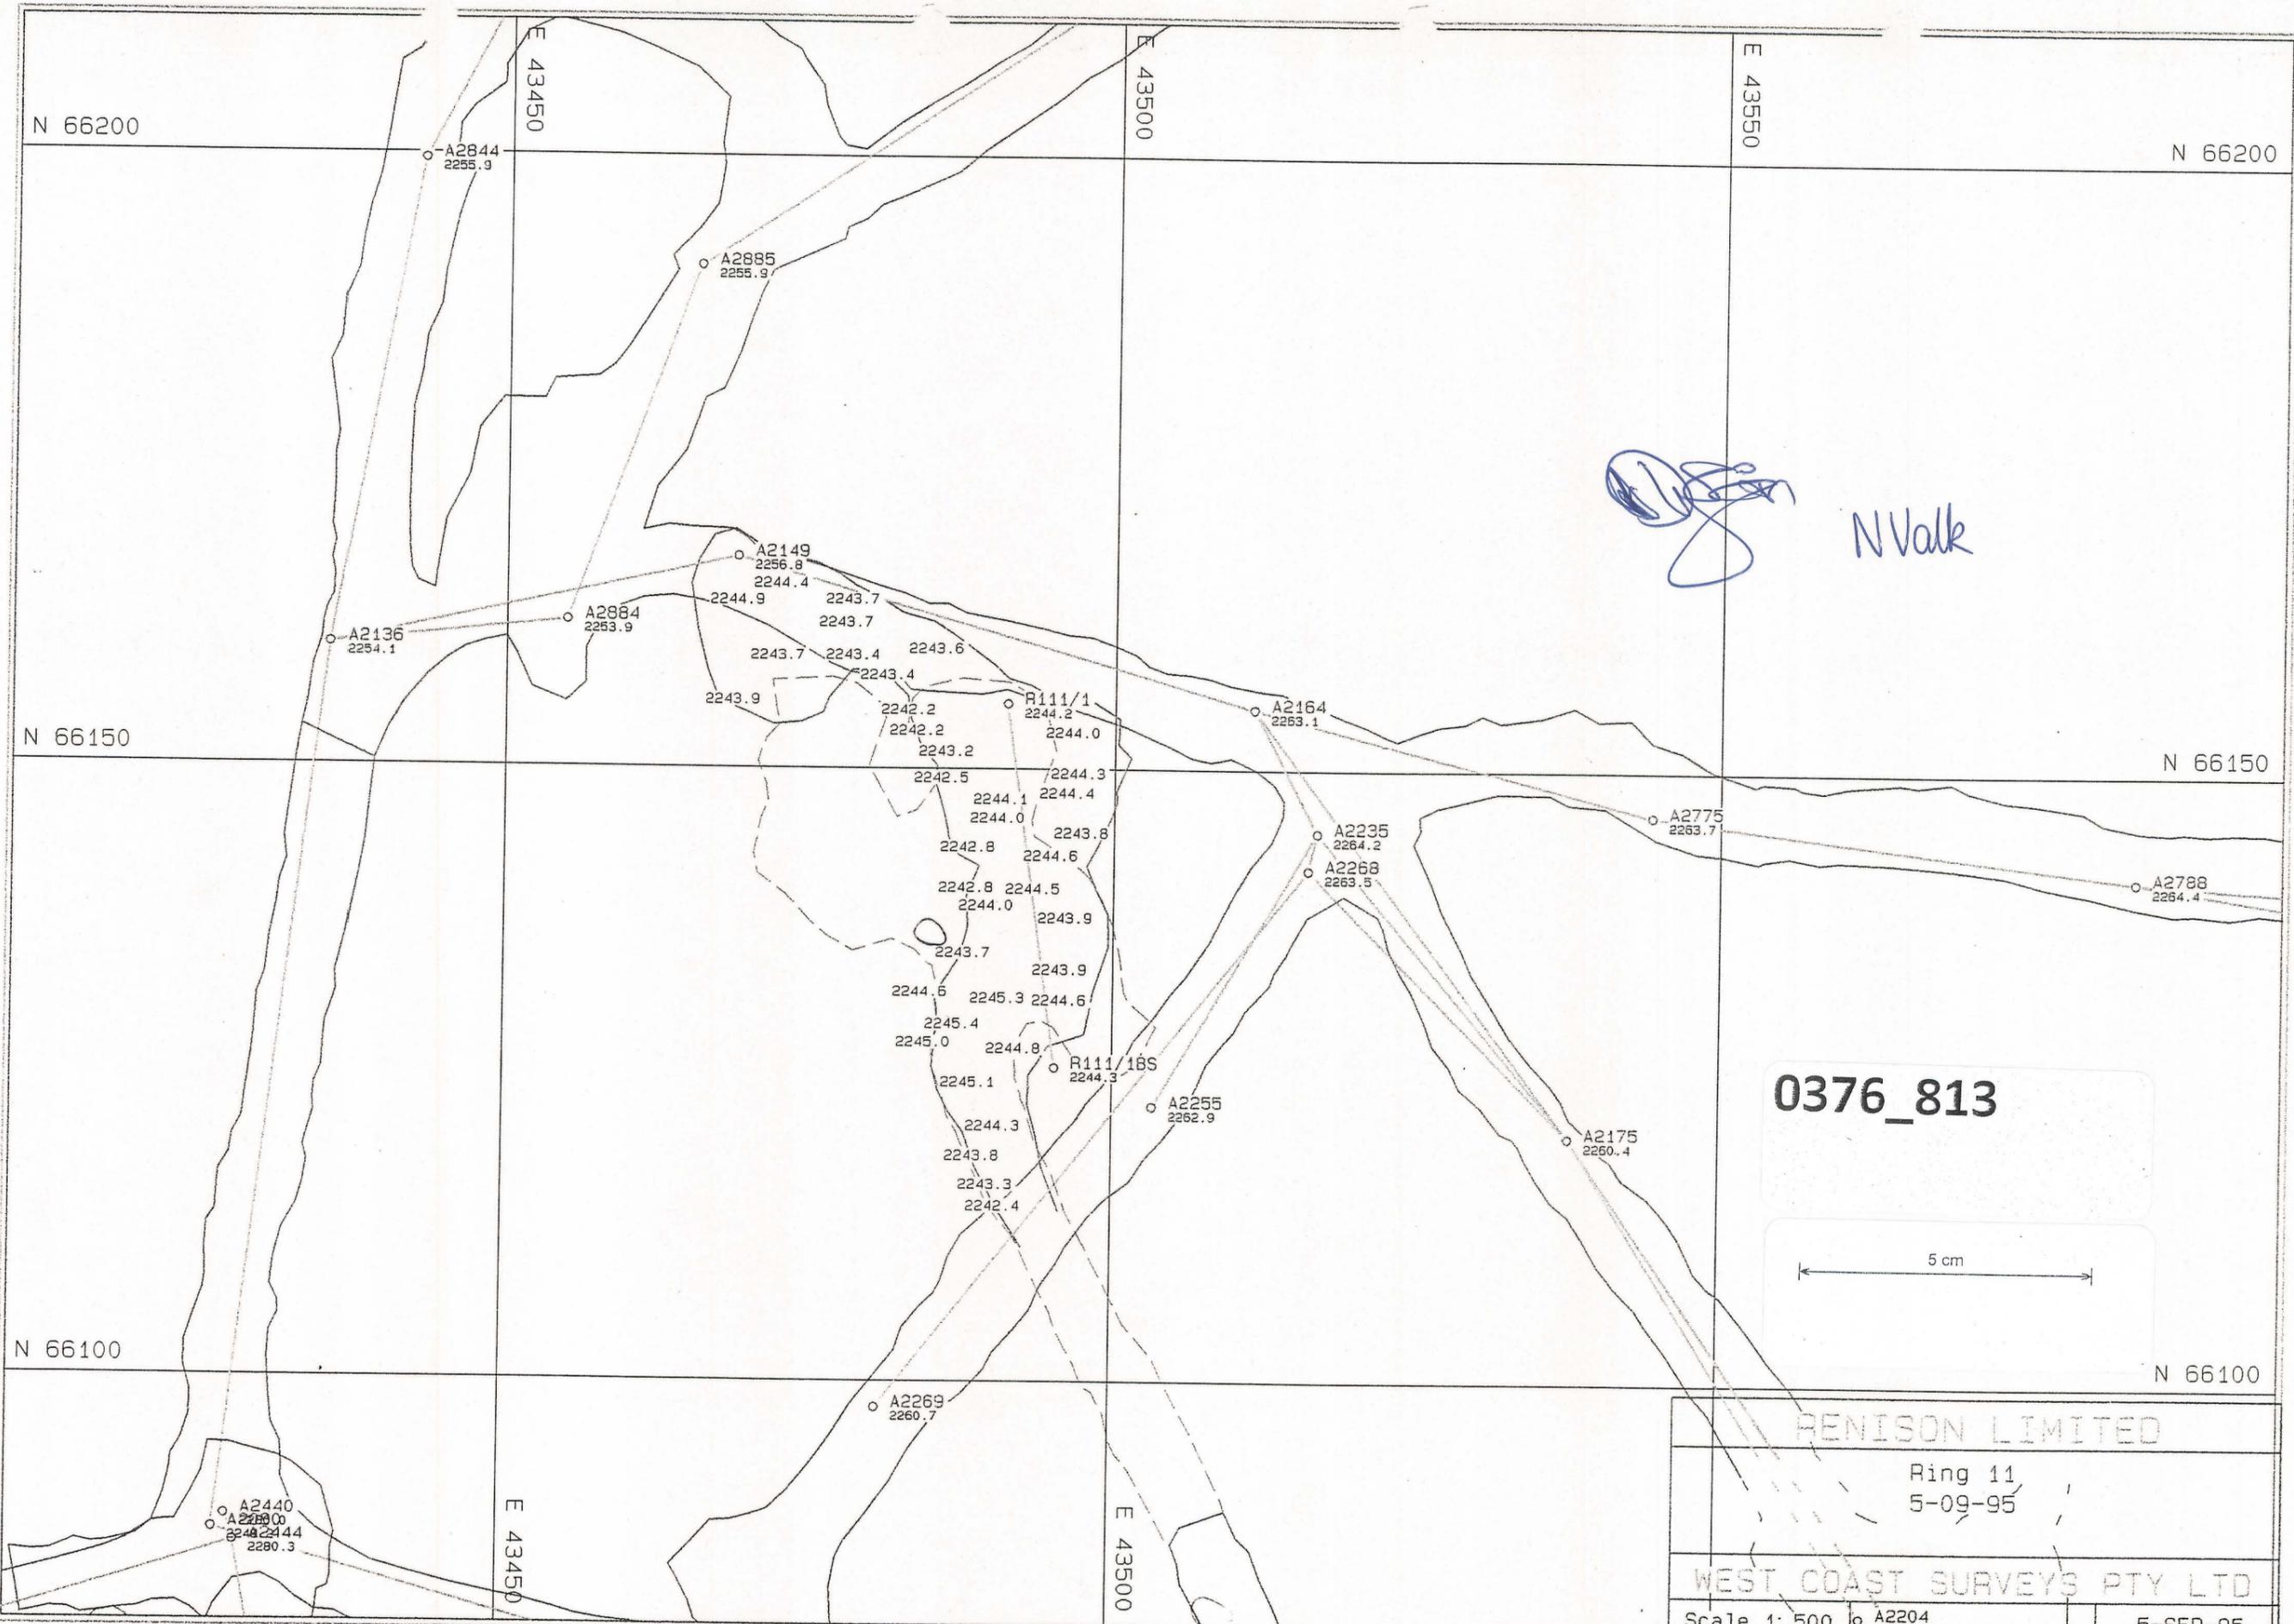

N Valk

0376_813

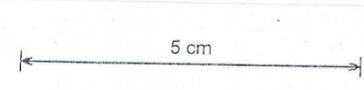

RINGSON LIMITED	
Ring 11, 5-09-95	
WEST COAST SURVEYS PTY LTD	
Scale 1: 500	5-SEP-95

RING1A.PF