



0376_814

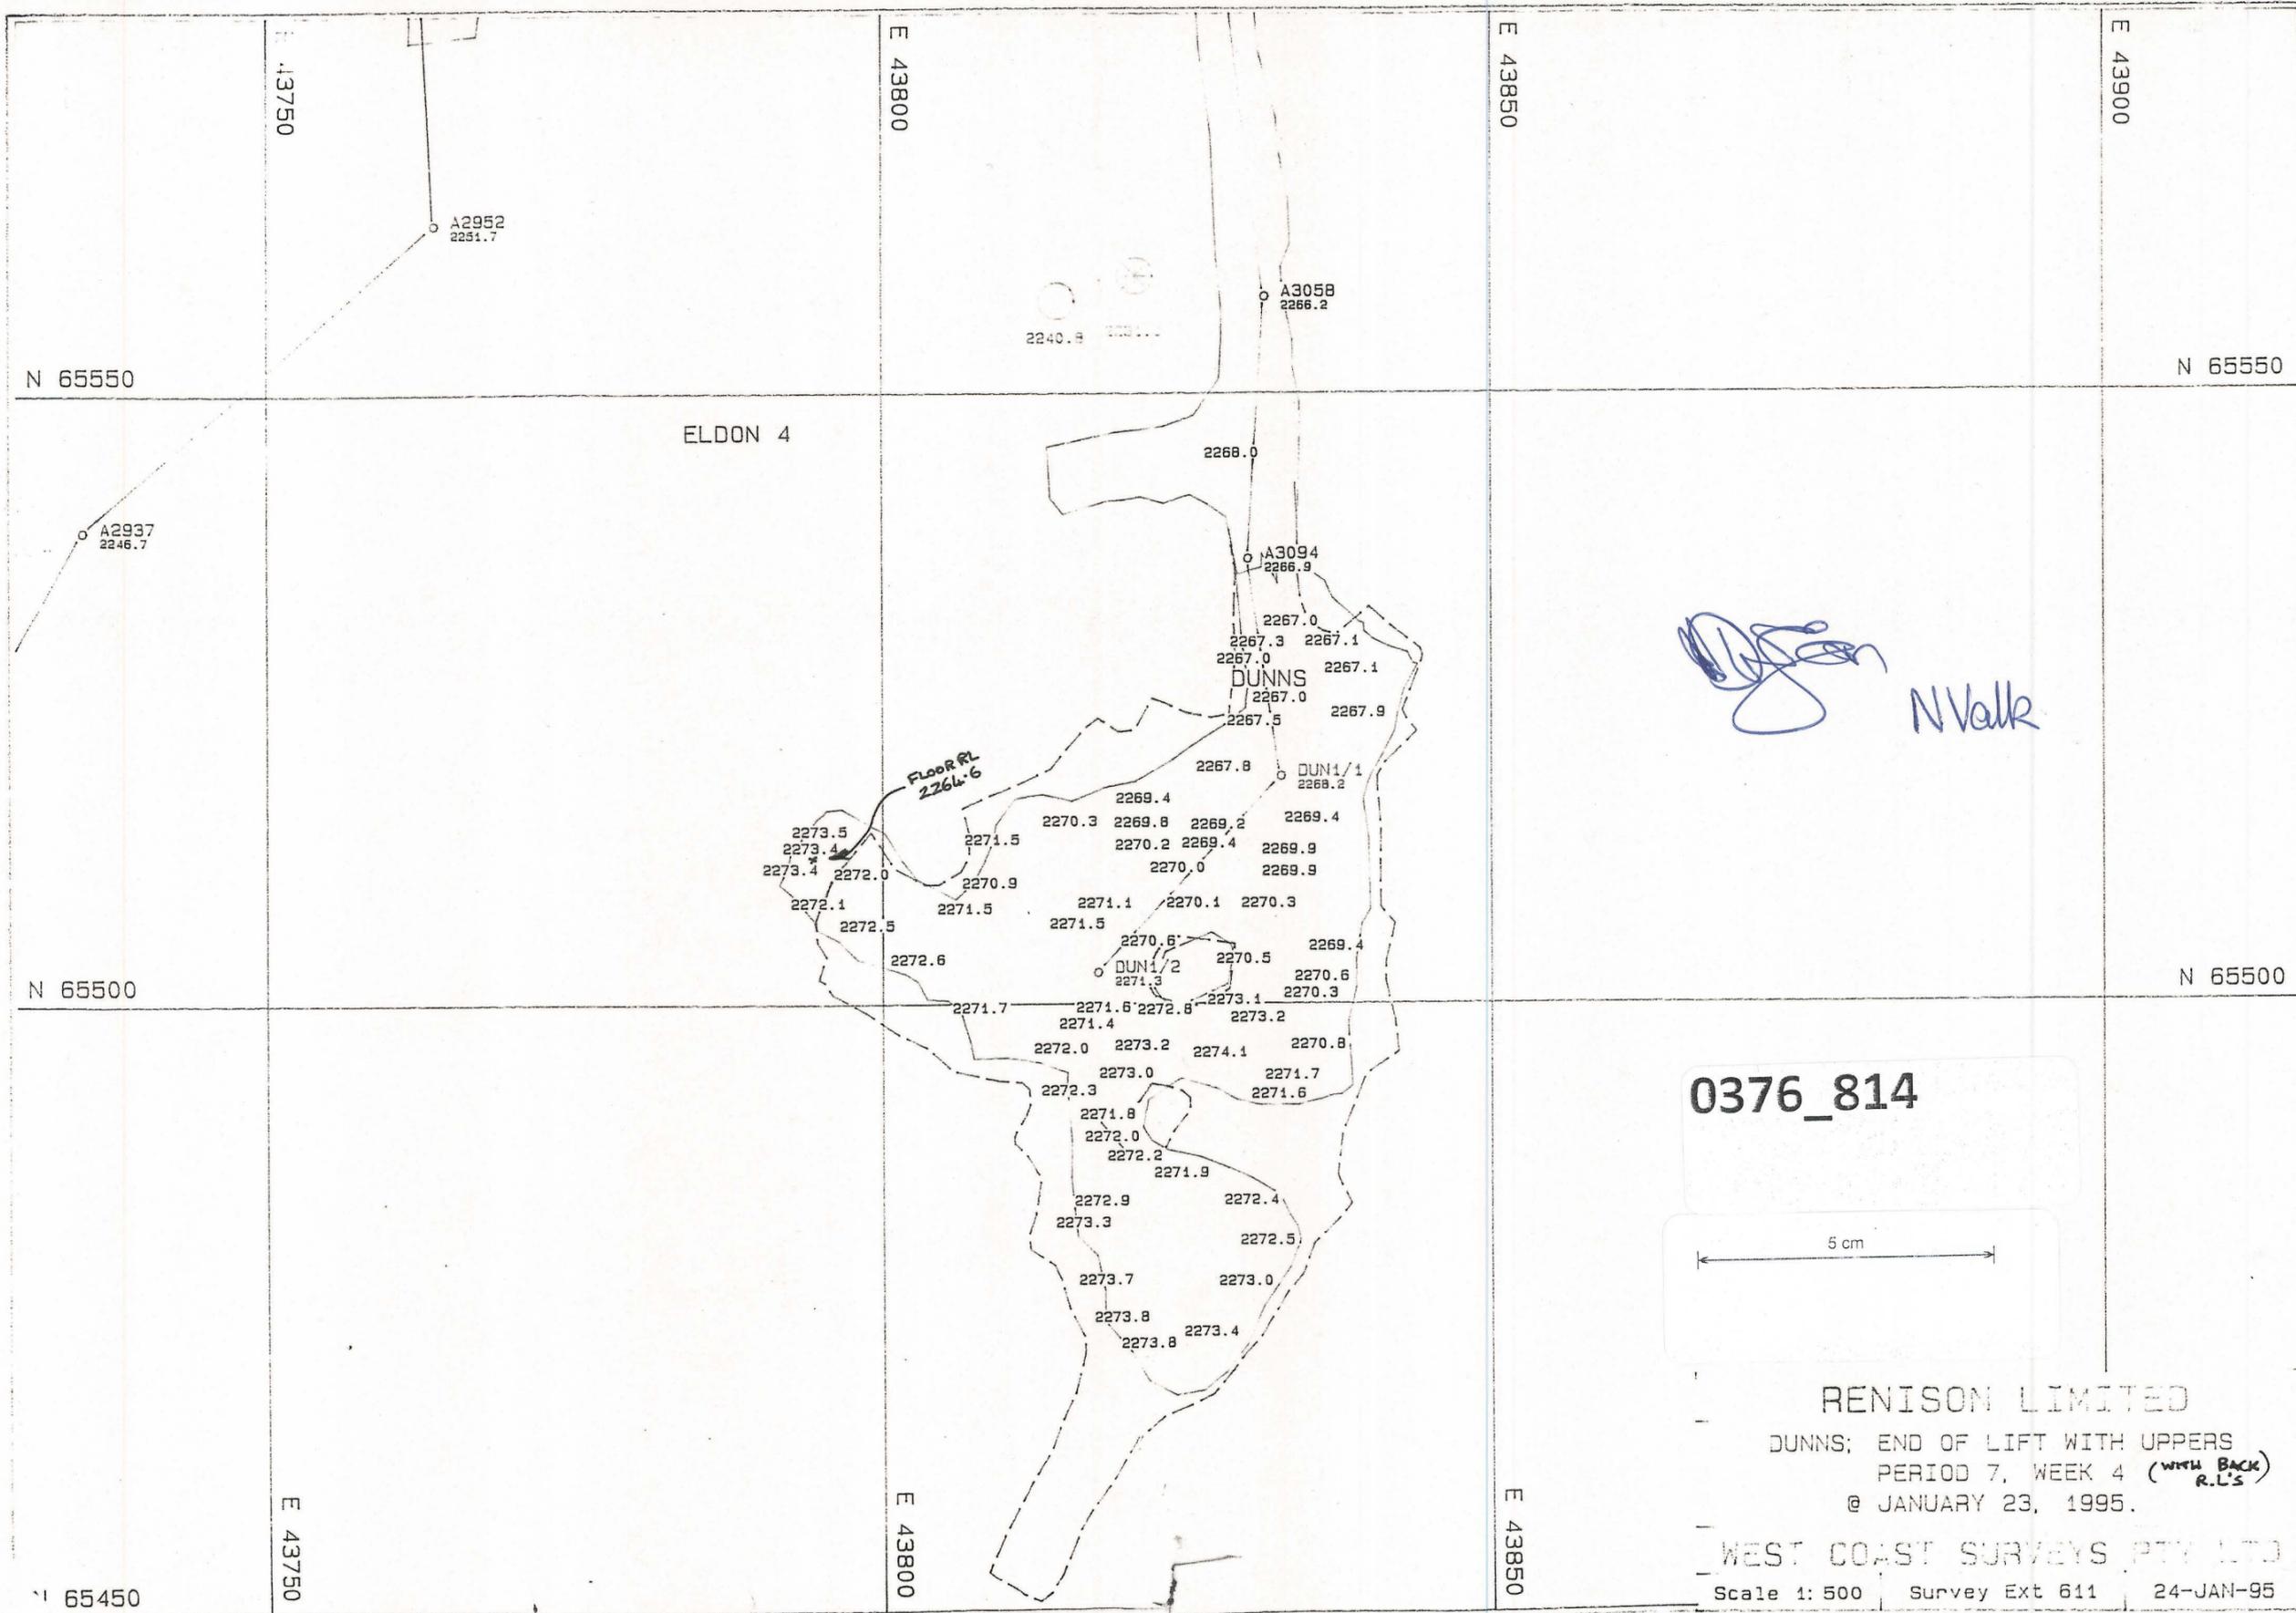

N Valk

0376_814

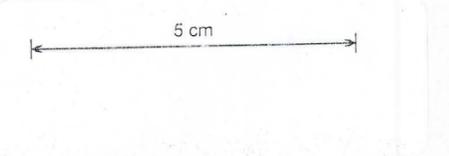

RENISON LIMITED
 DUNNS; END OF LIFT WITH UPPERS
 PERIOD 7, WEEK 4 (WITH BACK R.L.'S)
 @ JANUARY 23, 1995.

WEST COAST SURVEYS PTY LTD
 Scale 1: 500 Survey Ext 611 24-JAN-95