


0376_815

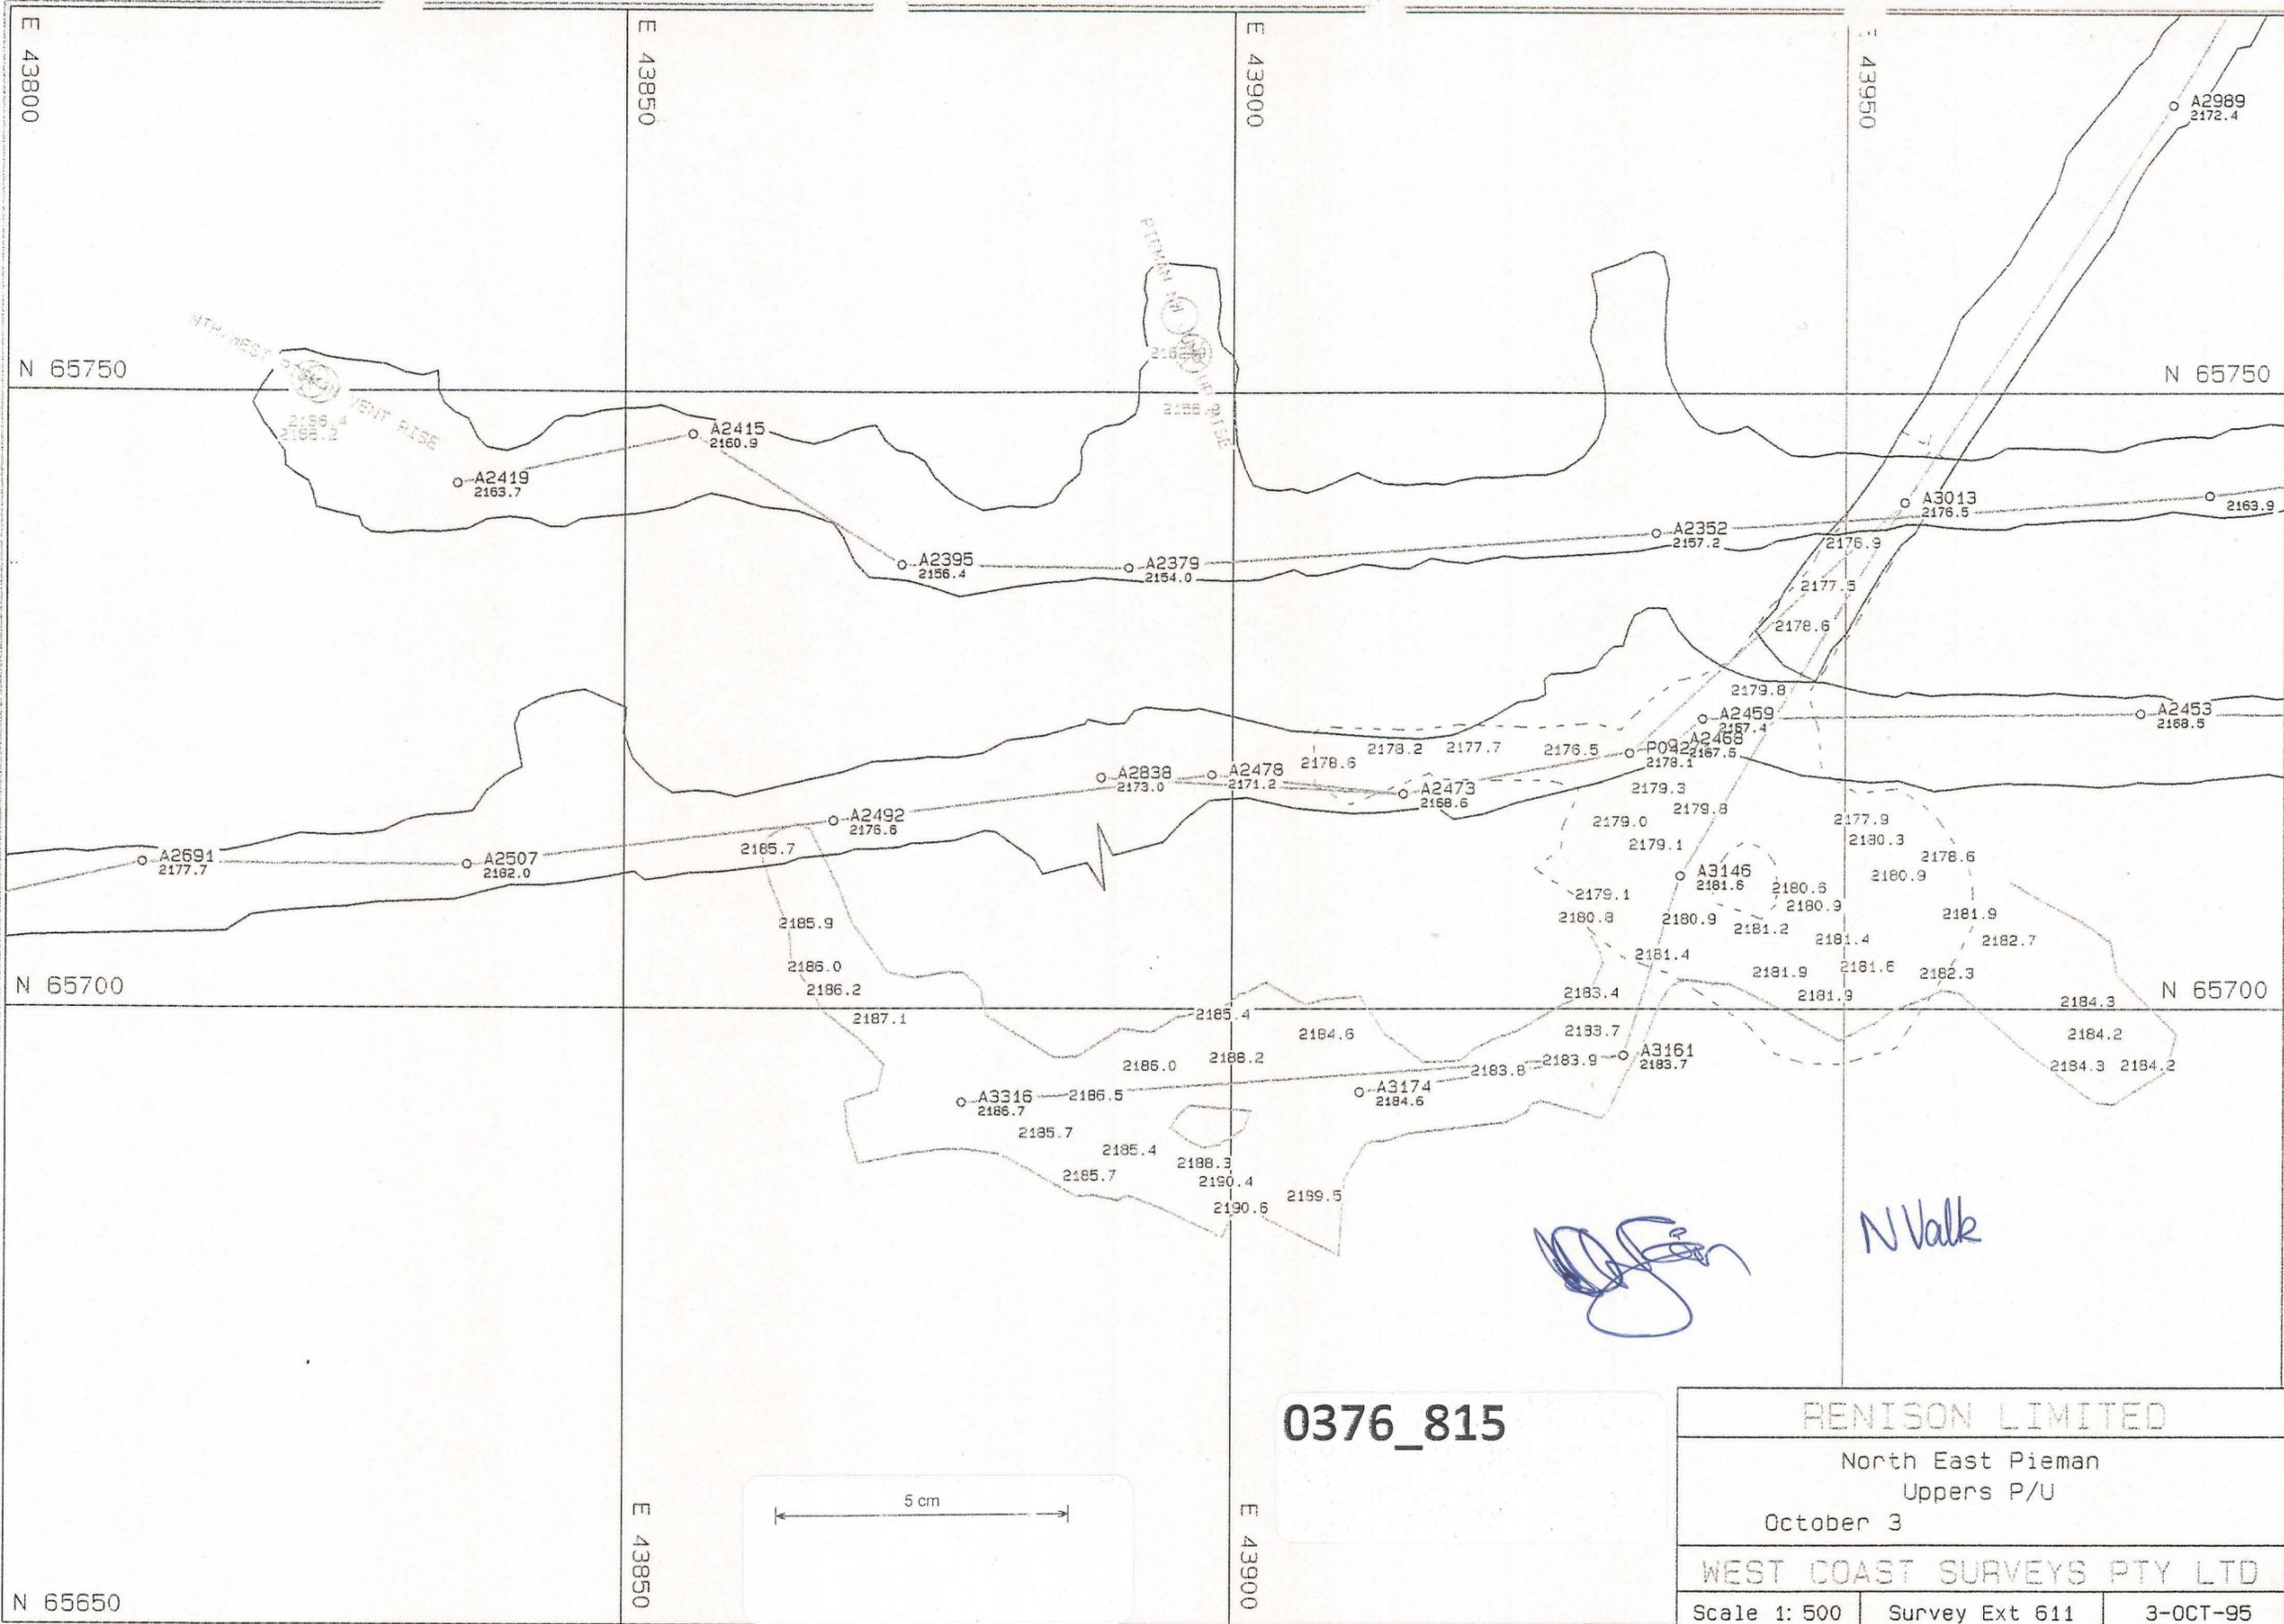

0376_815

RENISON LIMITED

North East Pieman
Uppers P/U

October 3

WEST COAST SURVEYS PTY LTD

Scale 1: 500

Survey Ext 611

3-OCT-95

5 cm

[Handwritten signature]

N Valk

NEPIEA.PF