



0376\_816

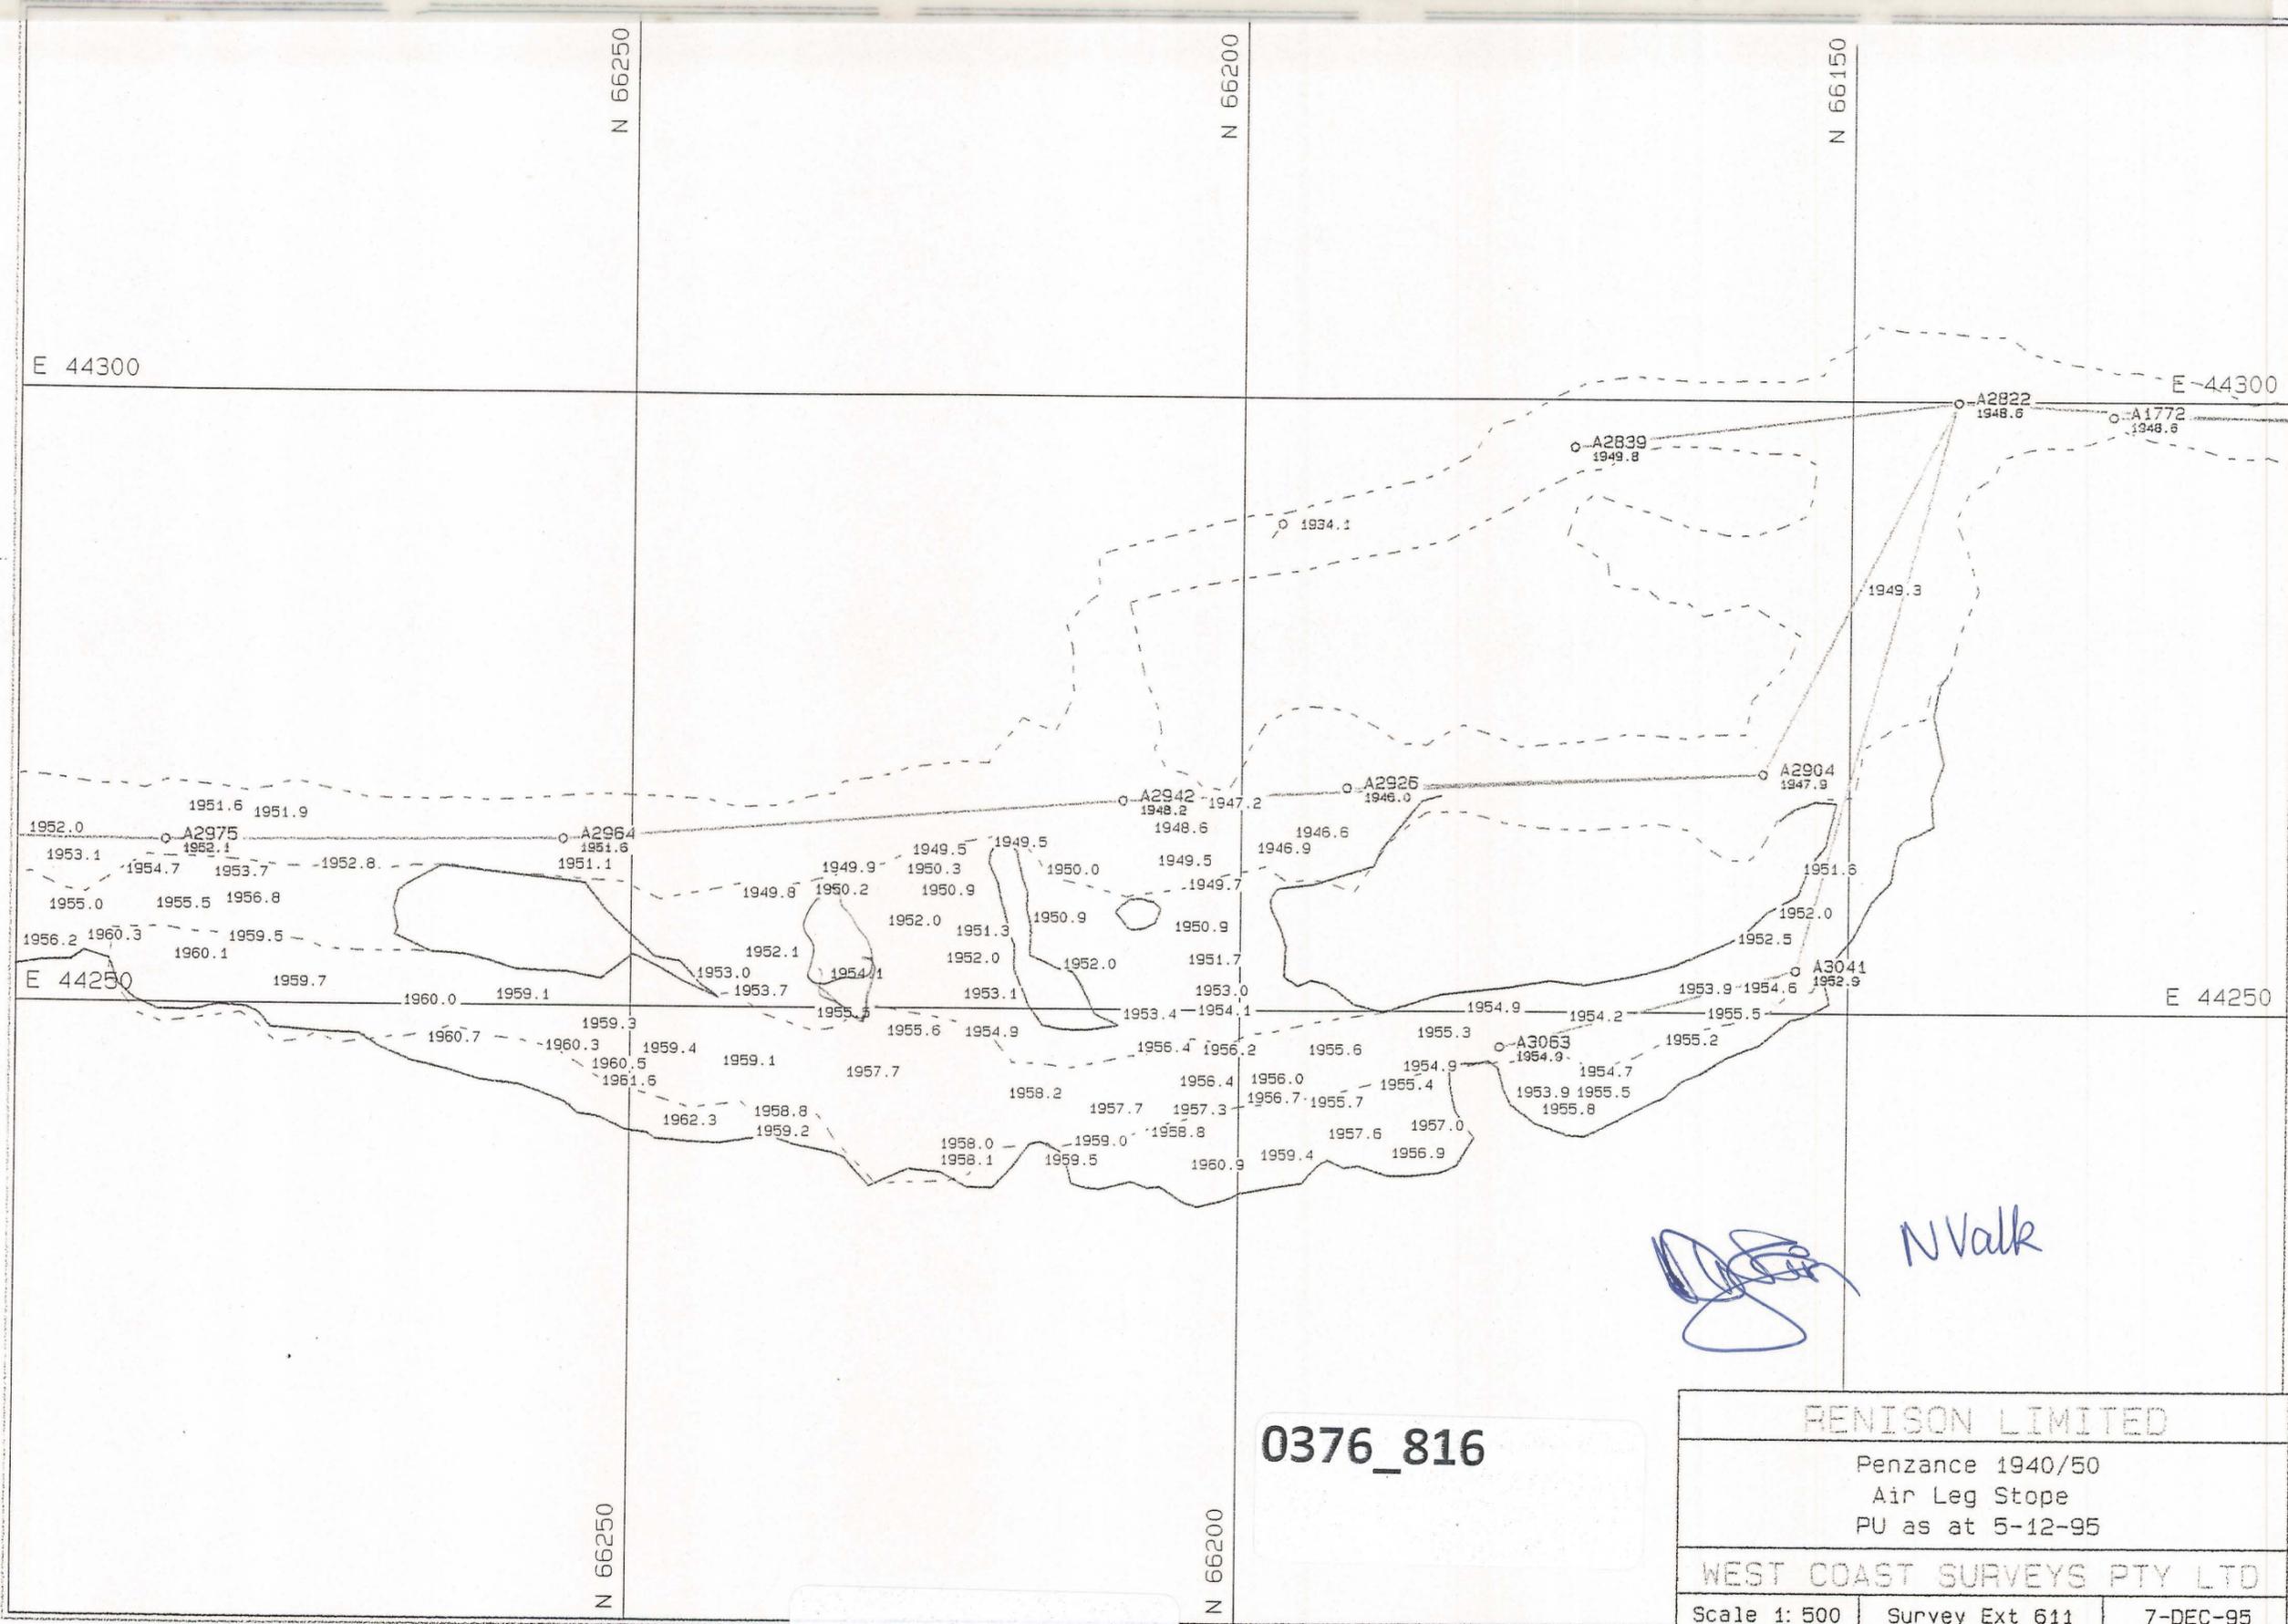

*N Valk*

0376\_816

RENISON LIMITED		
Penzance 1940/50		
Air Leg Stope		
PU as at 5-12-95		
WEST COAST SURVEYS PTY LTD		
Scale 1: 500	Survey Ext 611	7-DEC-95

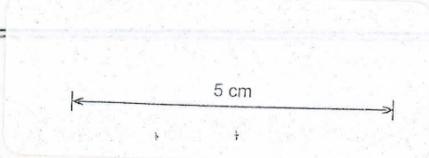

PENZAB.PF