


0376\_818

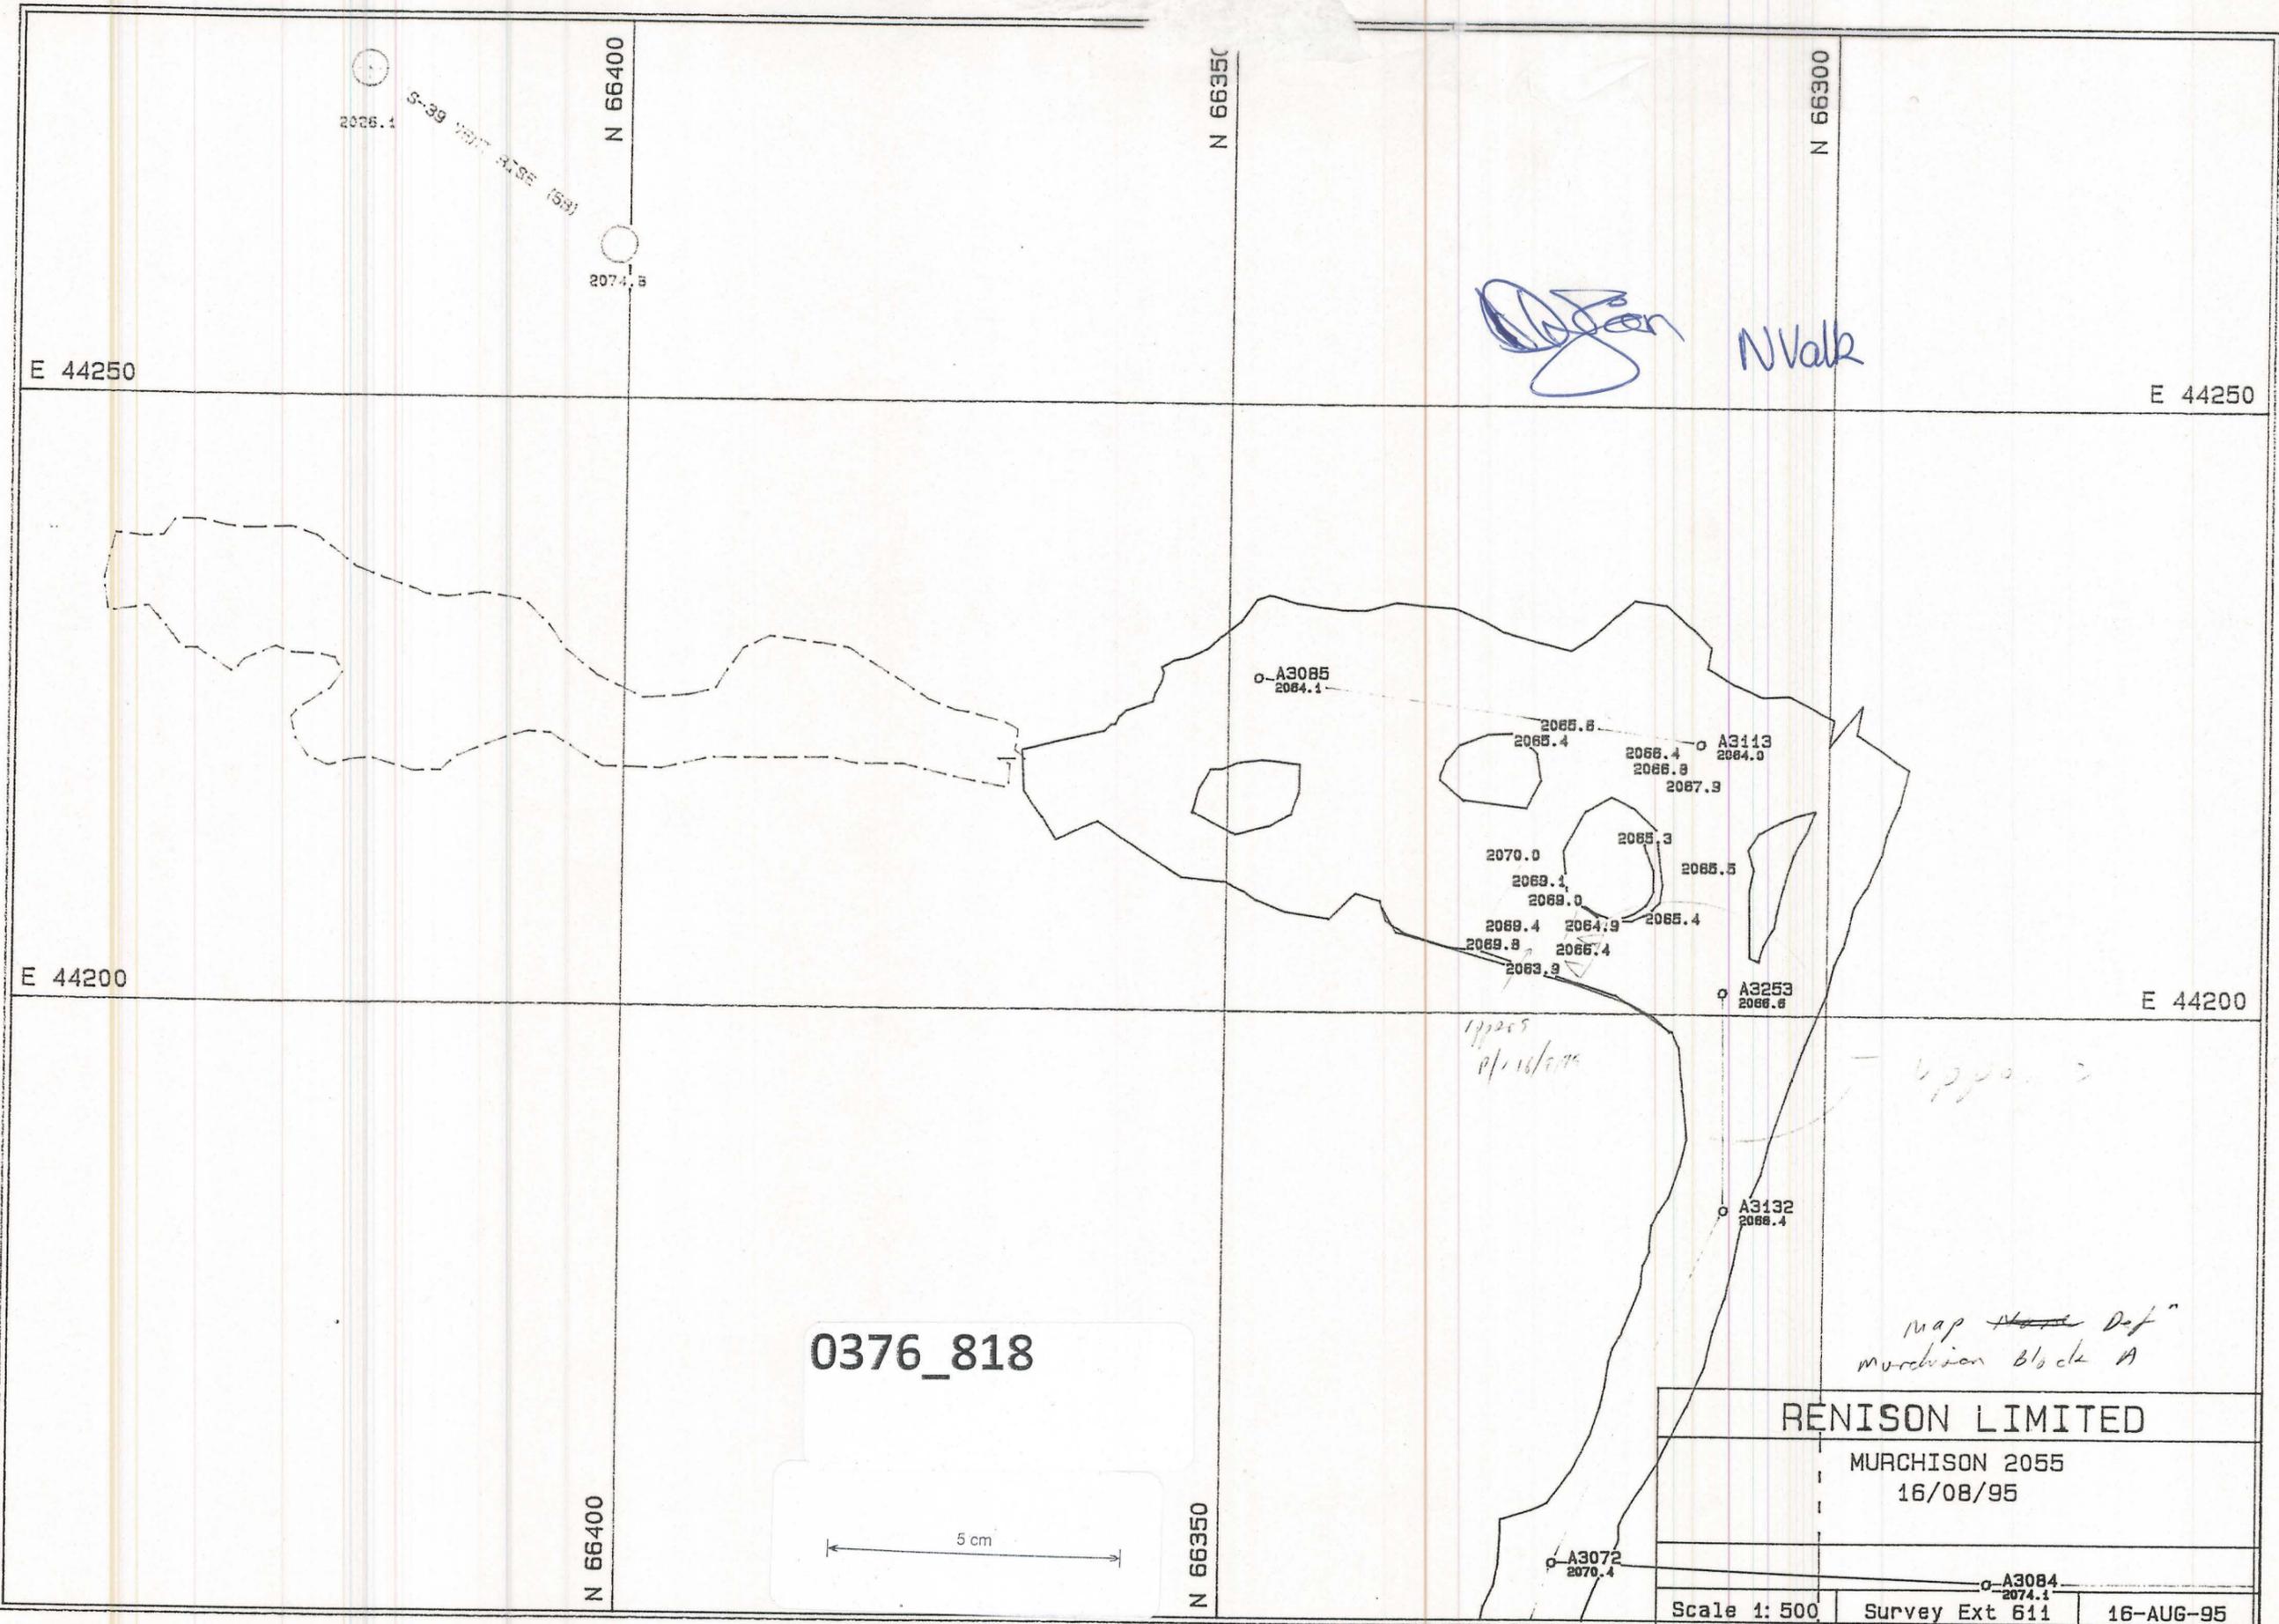

0376\_818

RENISON LIMITED

MURCHISON 2055  
16/08/95

Scale 1: 500

Survey Ext 611

16-AUG-95

MURCHA.PF