


0376_819

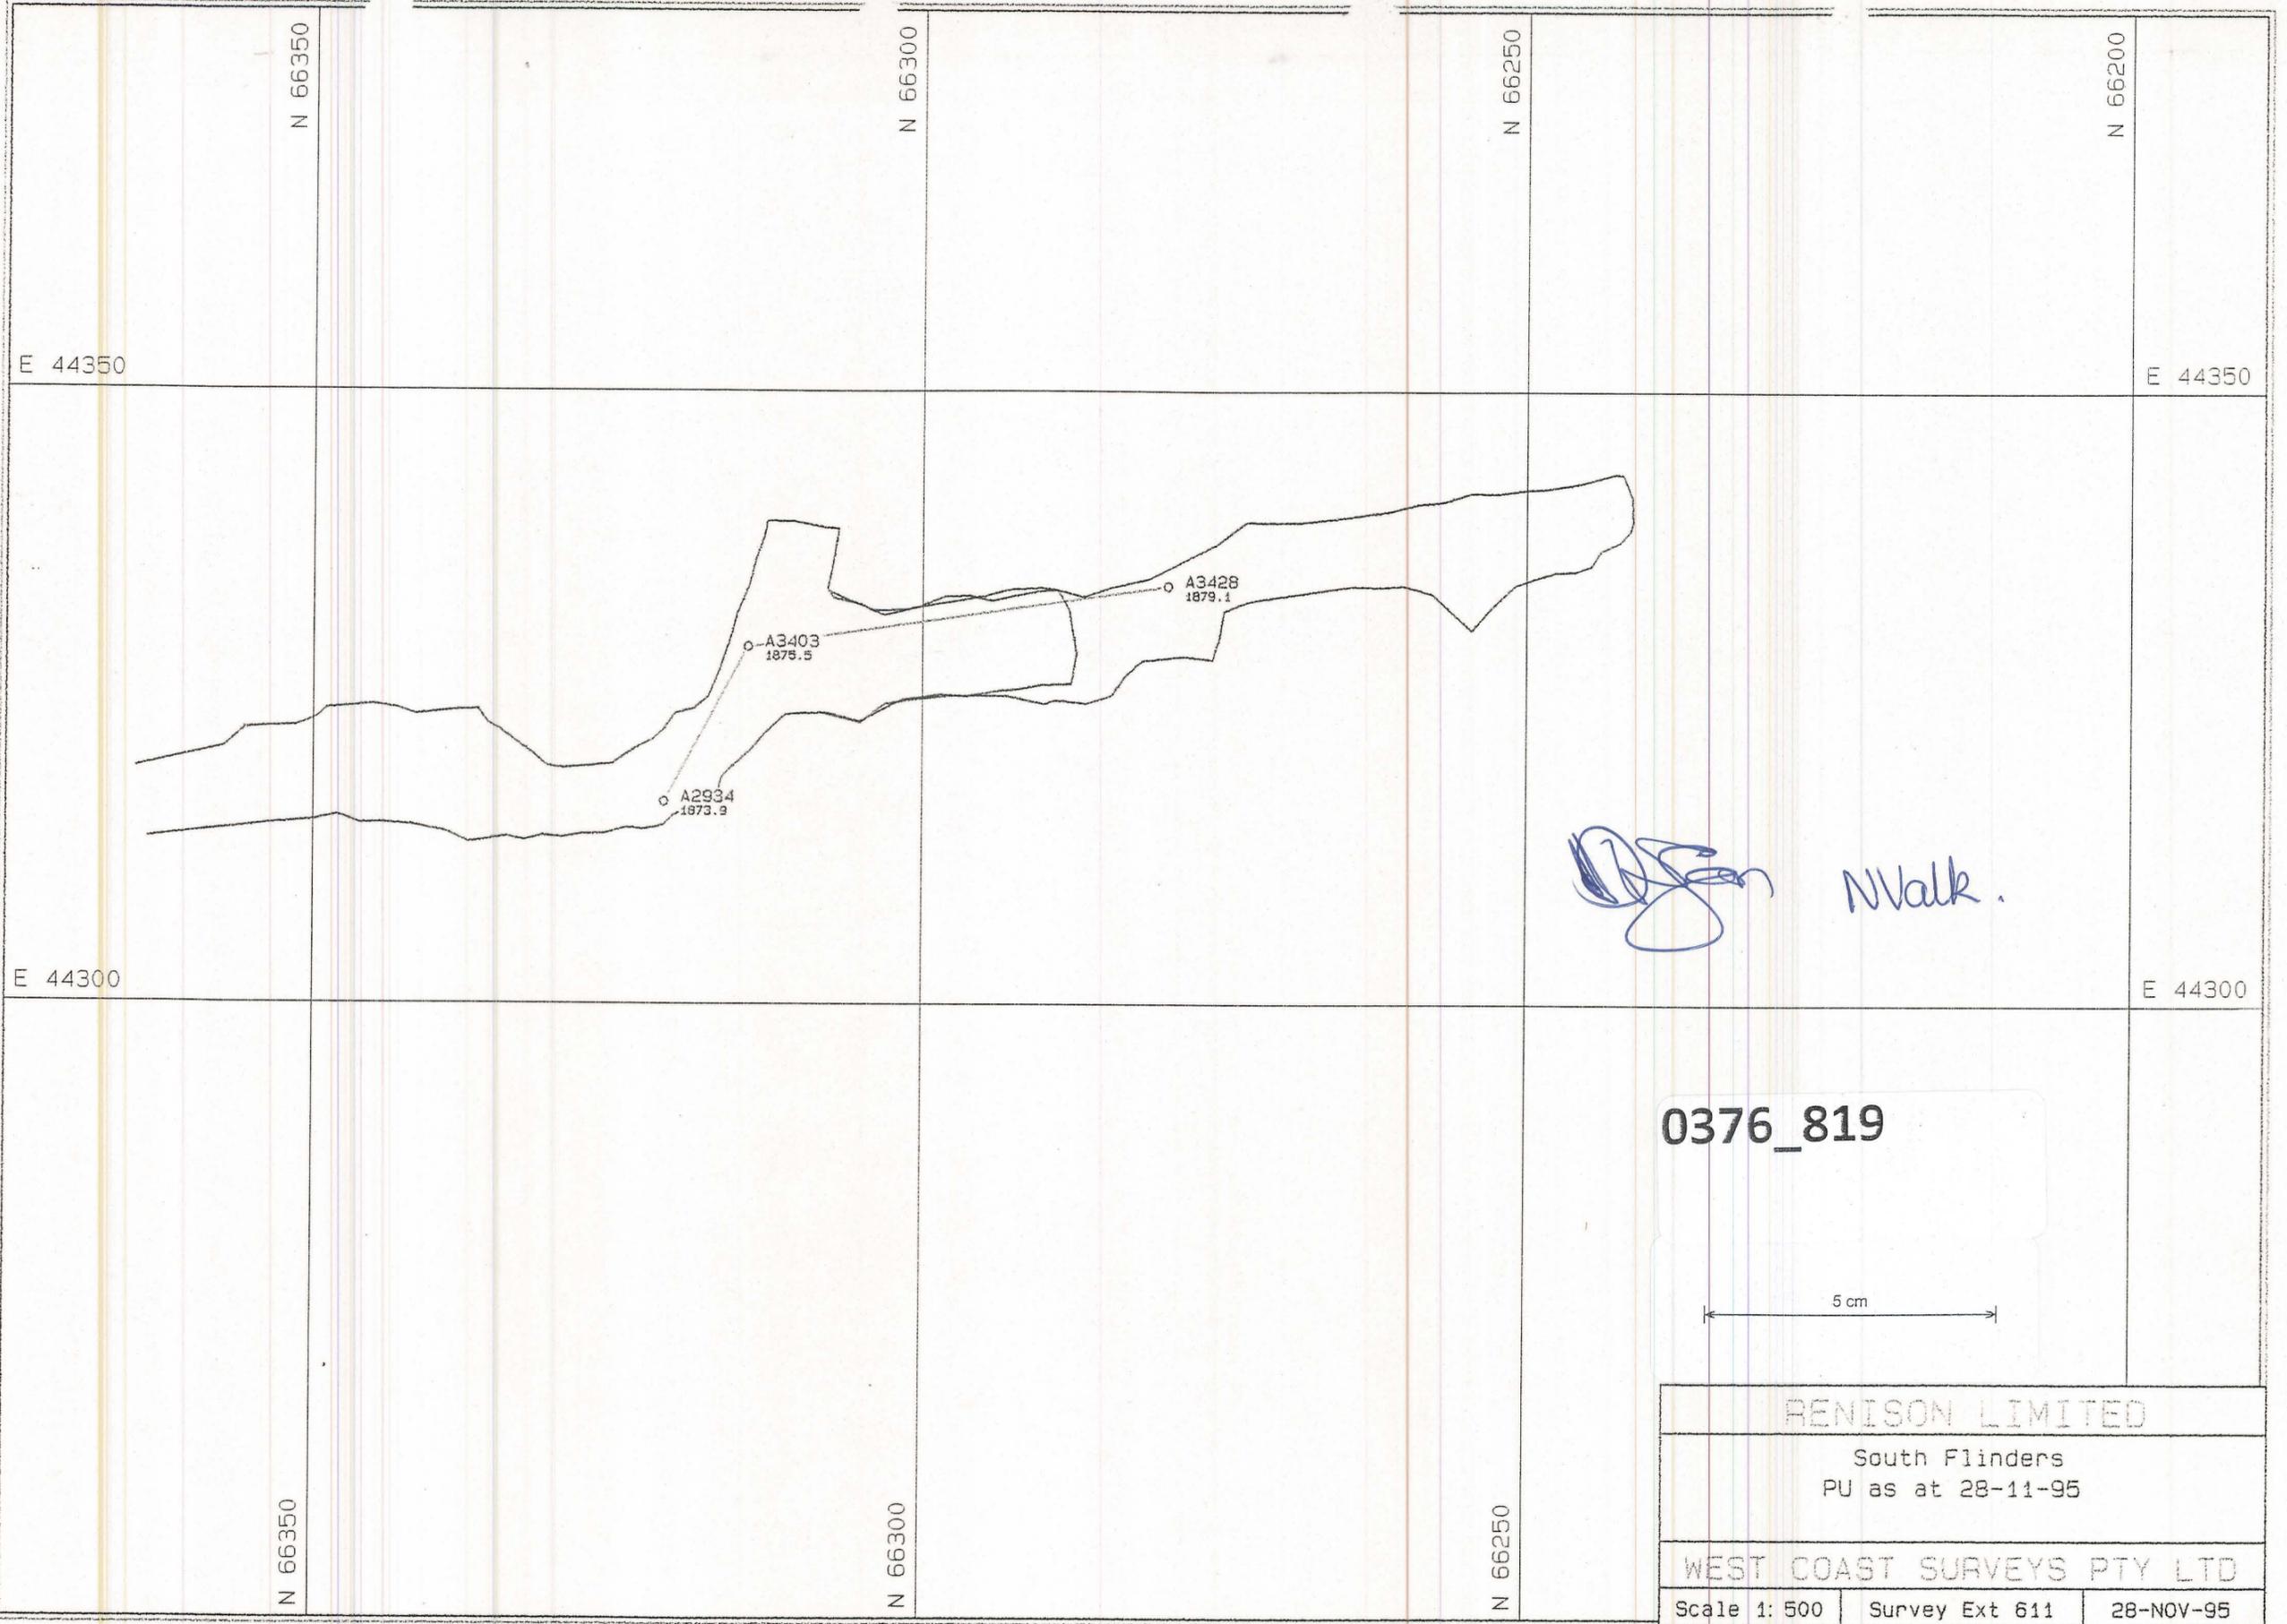

0376_819

5 cm

RENISON LIMITED		
South Flinders PU as at 28-11-95		
WEST COAST SURVEYS PTY LTD		
Scale 1: 500	Survey Ext 611	28-NOV-95

SOUTH.PF