


0376_821

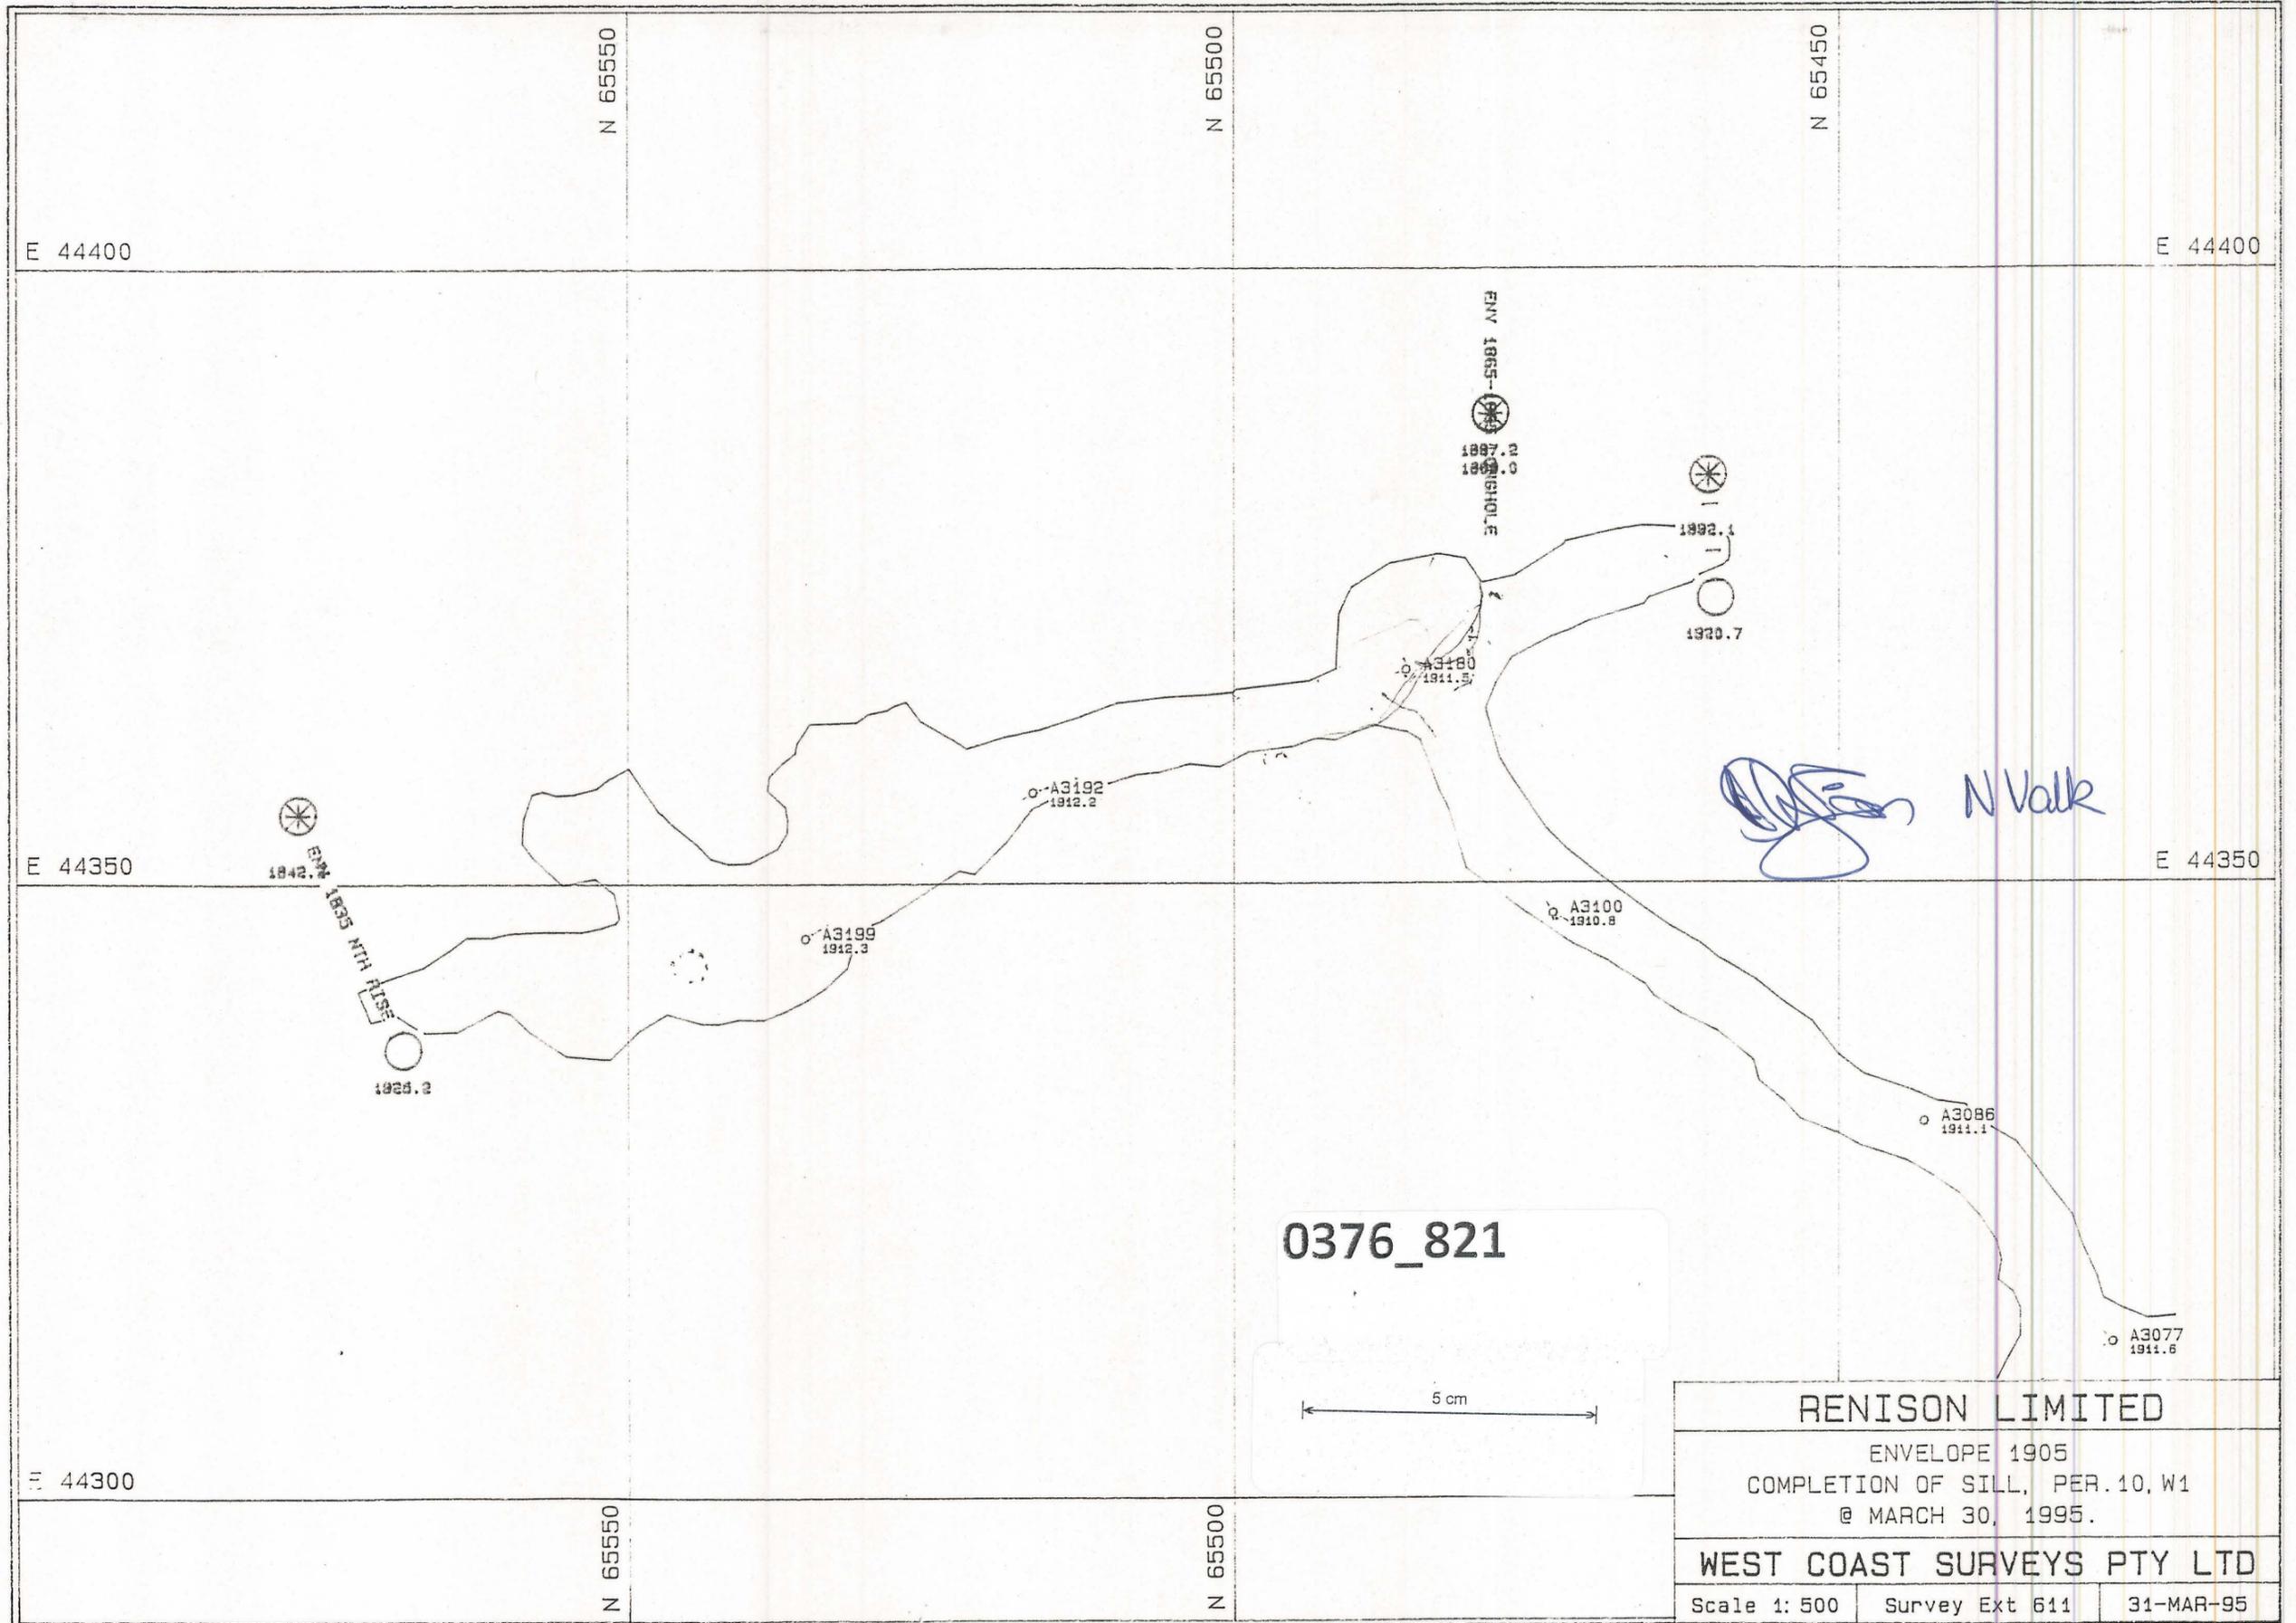

0376_821

5 cm

RENISON LIMITED		
ENVELOPE 1905		
COMPLETION OF SILL, PER.10, W1		
@ MARCH 30, 1995.		
WEST COAST SURVEYS PTY LTD		
Scale 1: 500	Survey Ext 611	31-MAR-95

ENVELD.PF