


0376\_822

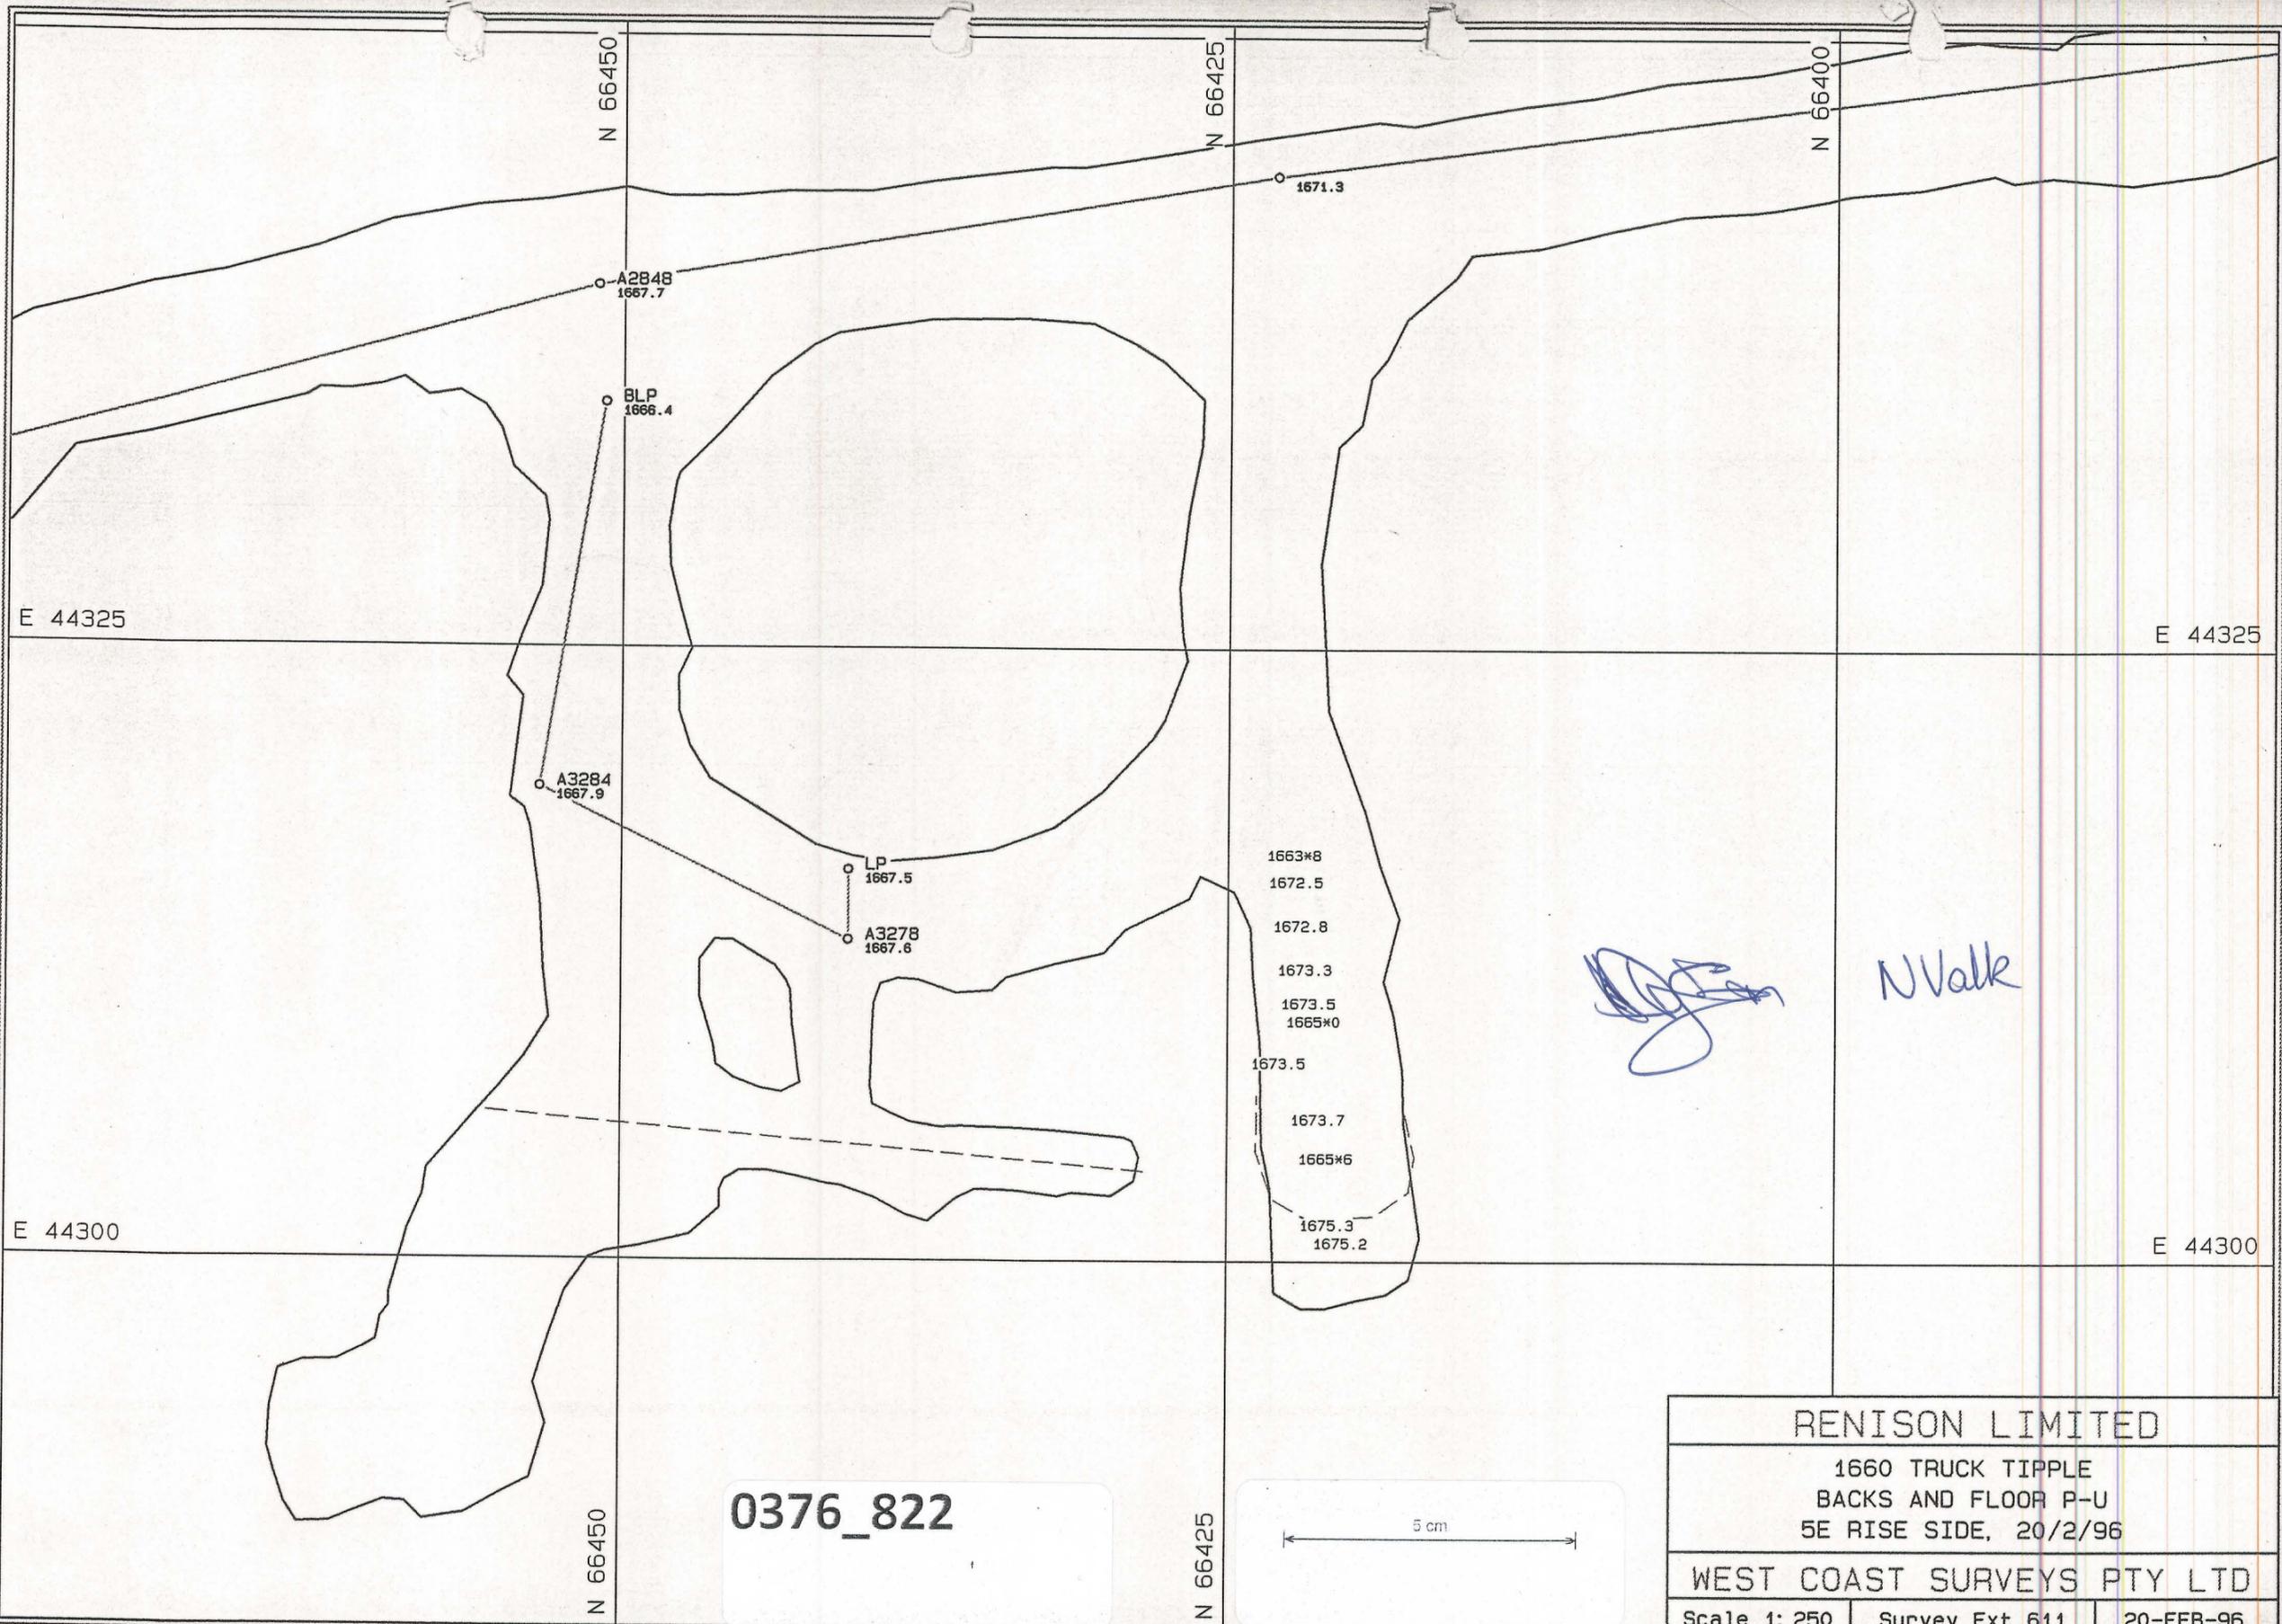

*N Valk*

RENISON LIMITED		
1660 TRUCK TIPPLE BACKS AND FLOOR P-U 5E RISE SIDE, 20/2/96		
WEST COAST SURVEYS PTY LTD		
Scale 1: 250	Survey Ext 611	20-FEB-96

TRUCKE .PF