


0376_823

0376_823

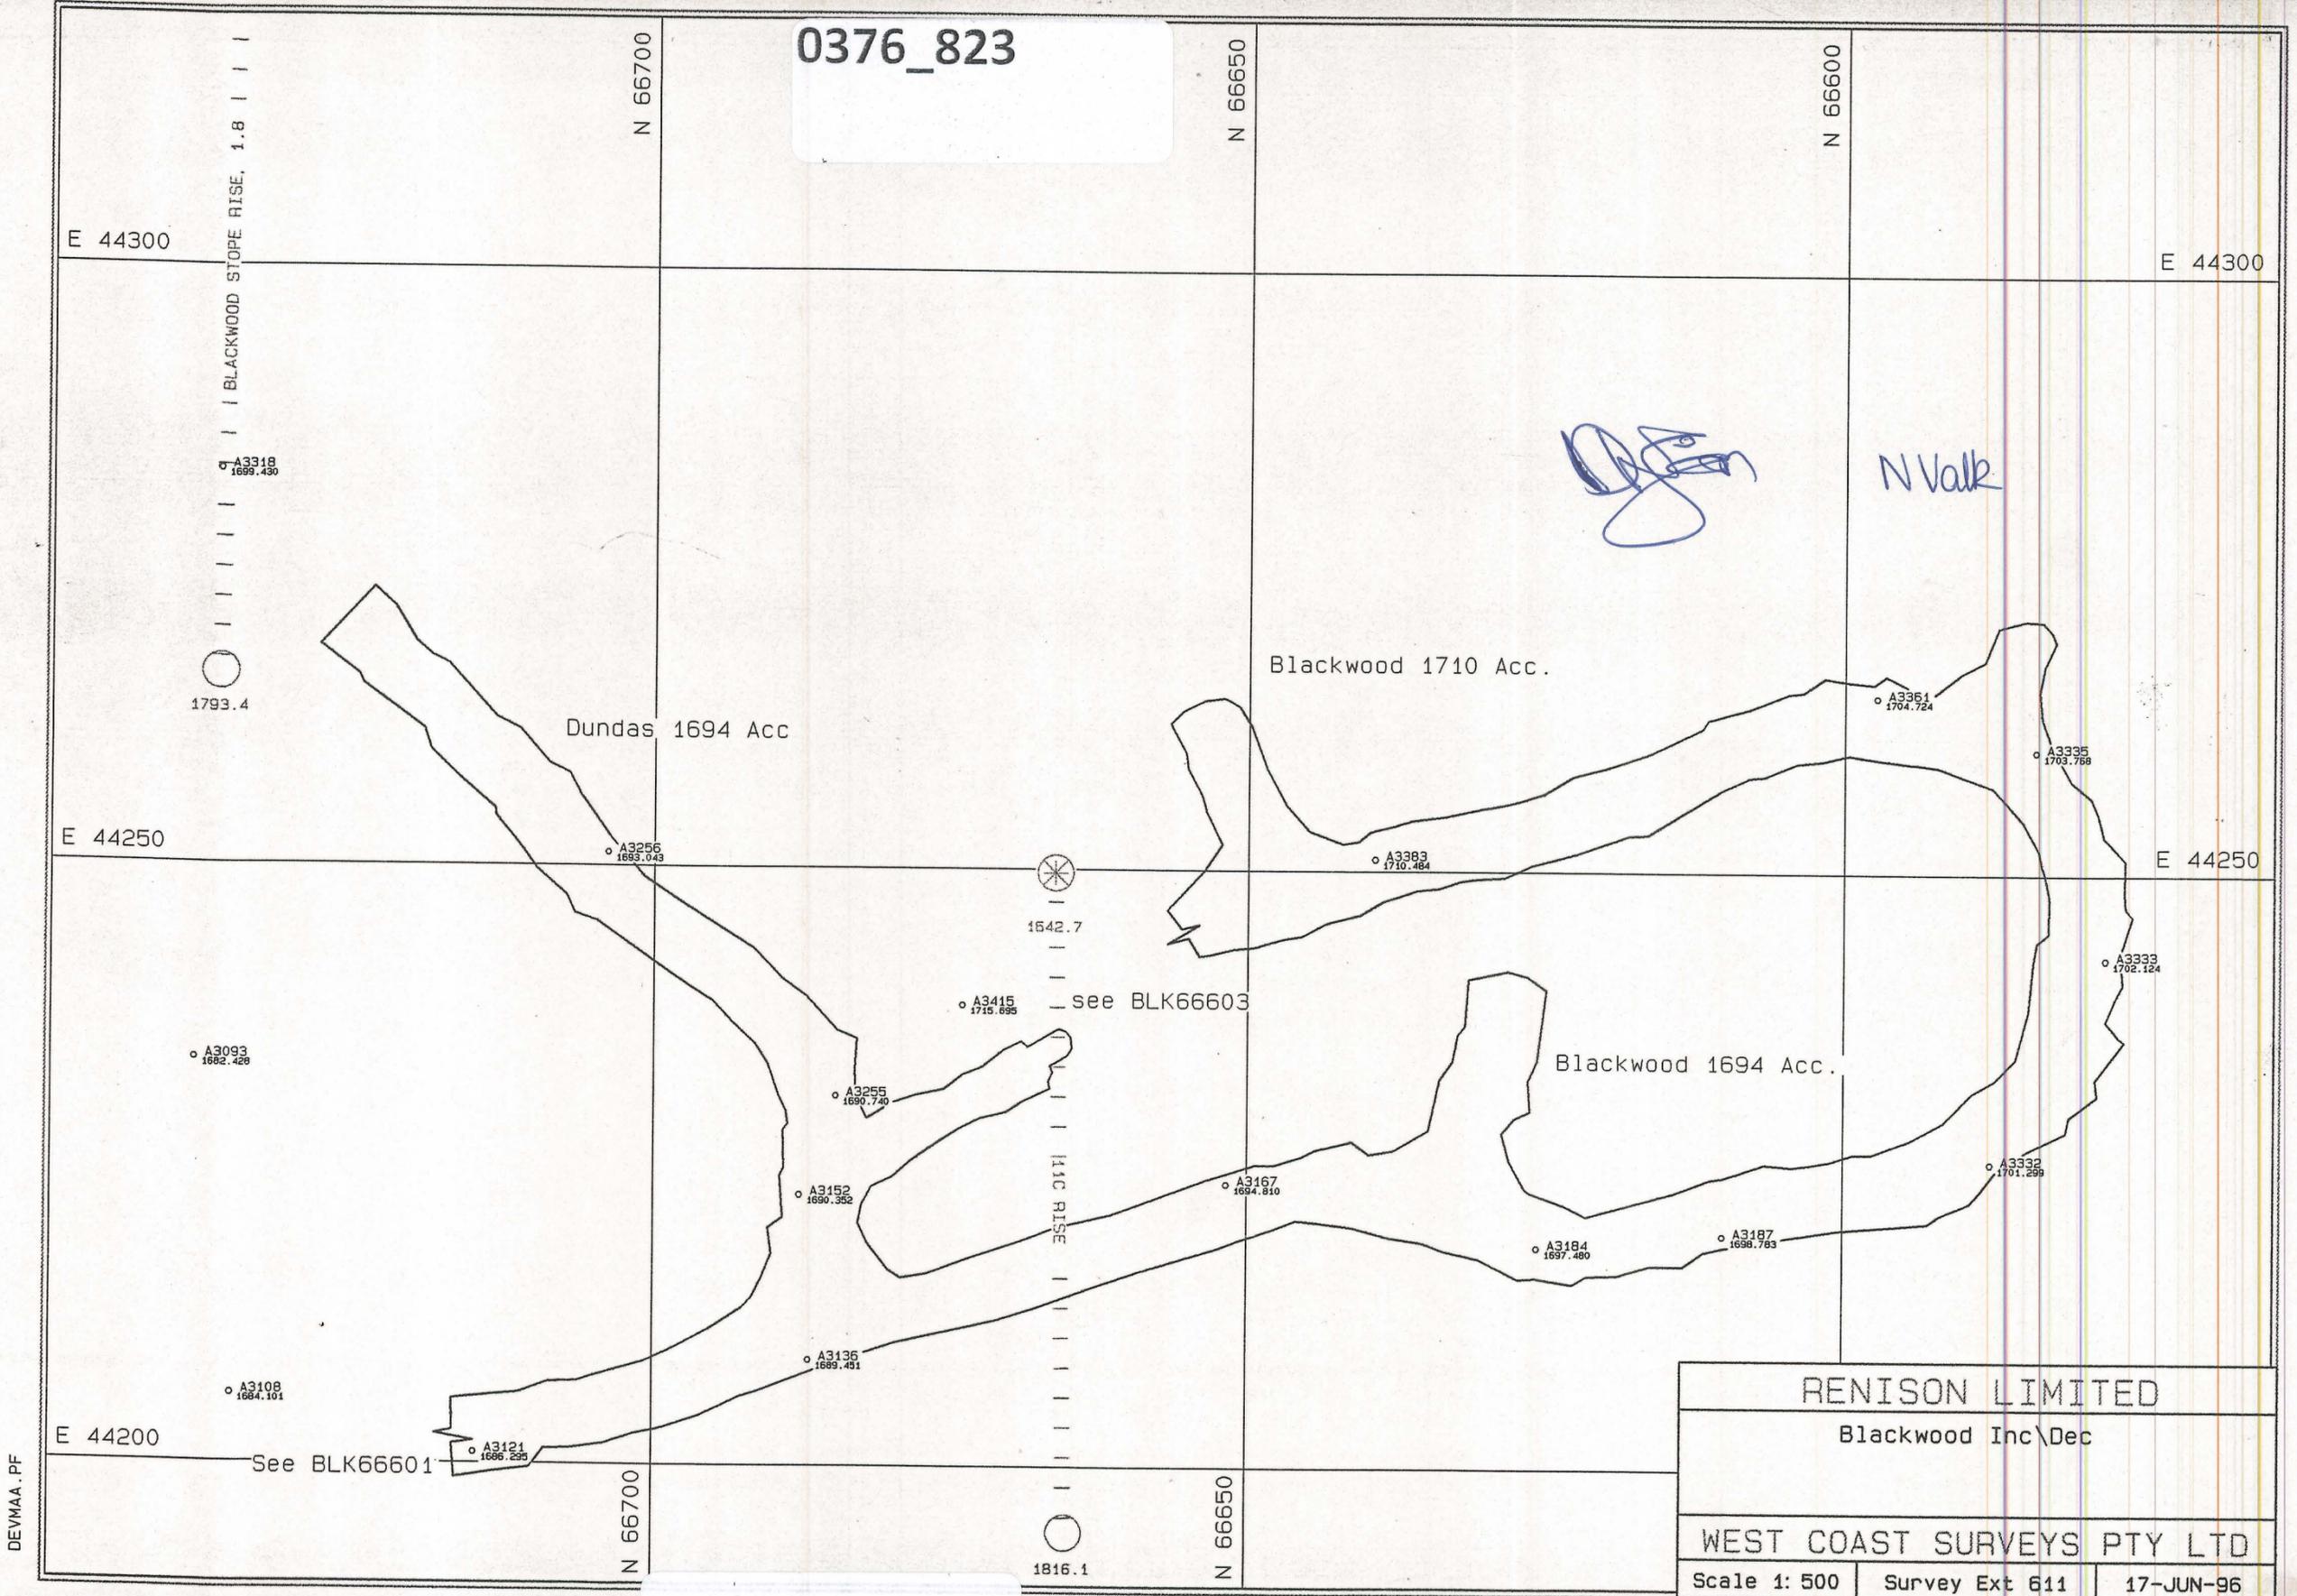

N Valk

RENISON LIMITED		
Blackwood Inc/Dec		
WEST COAST SURVEYS PTY LTD		
Scale 1: 500	Survey Ext 611	17-JUN-96

DEVMAA.PF
K