


0376_824

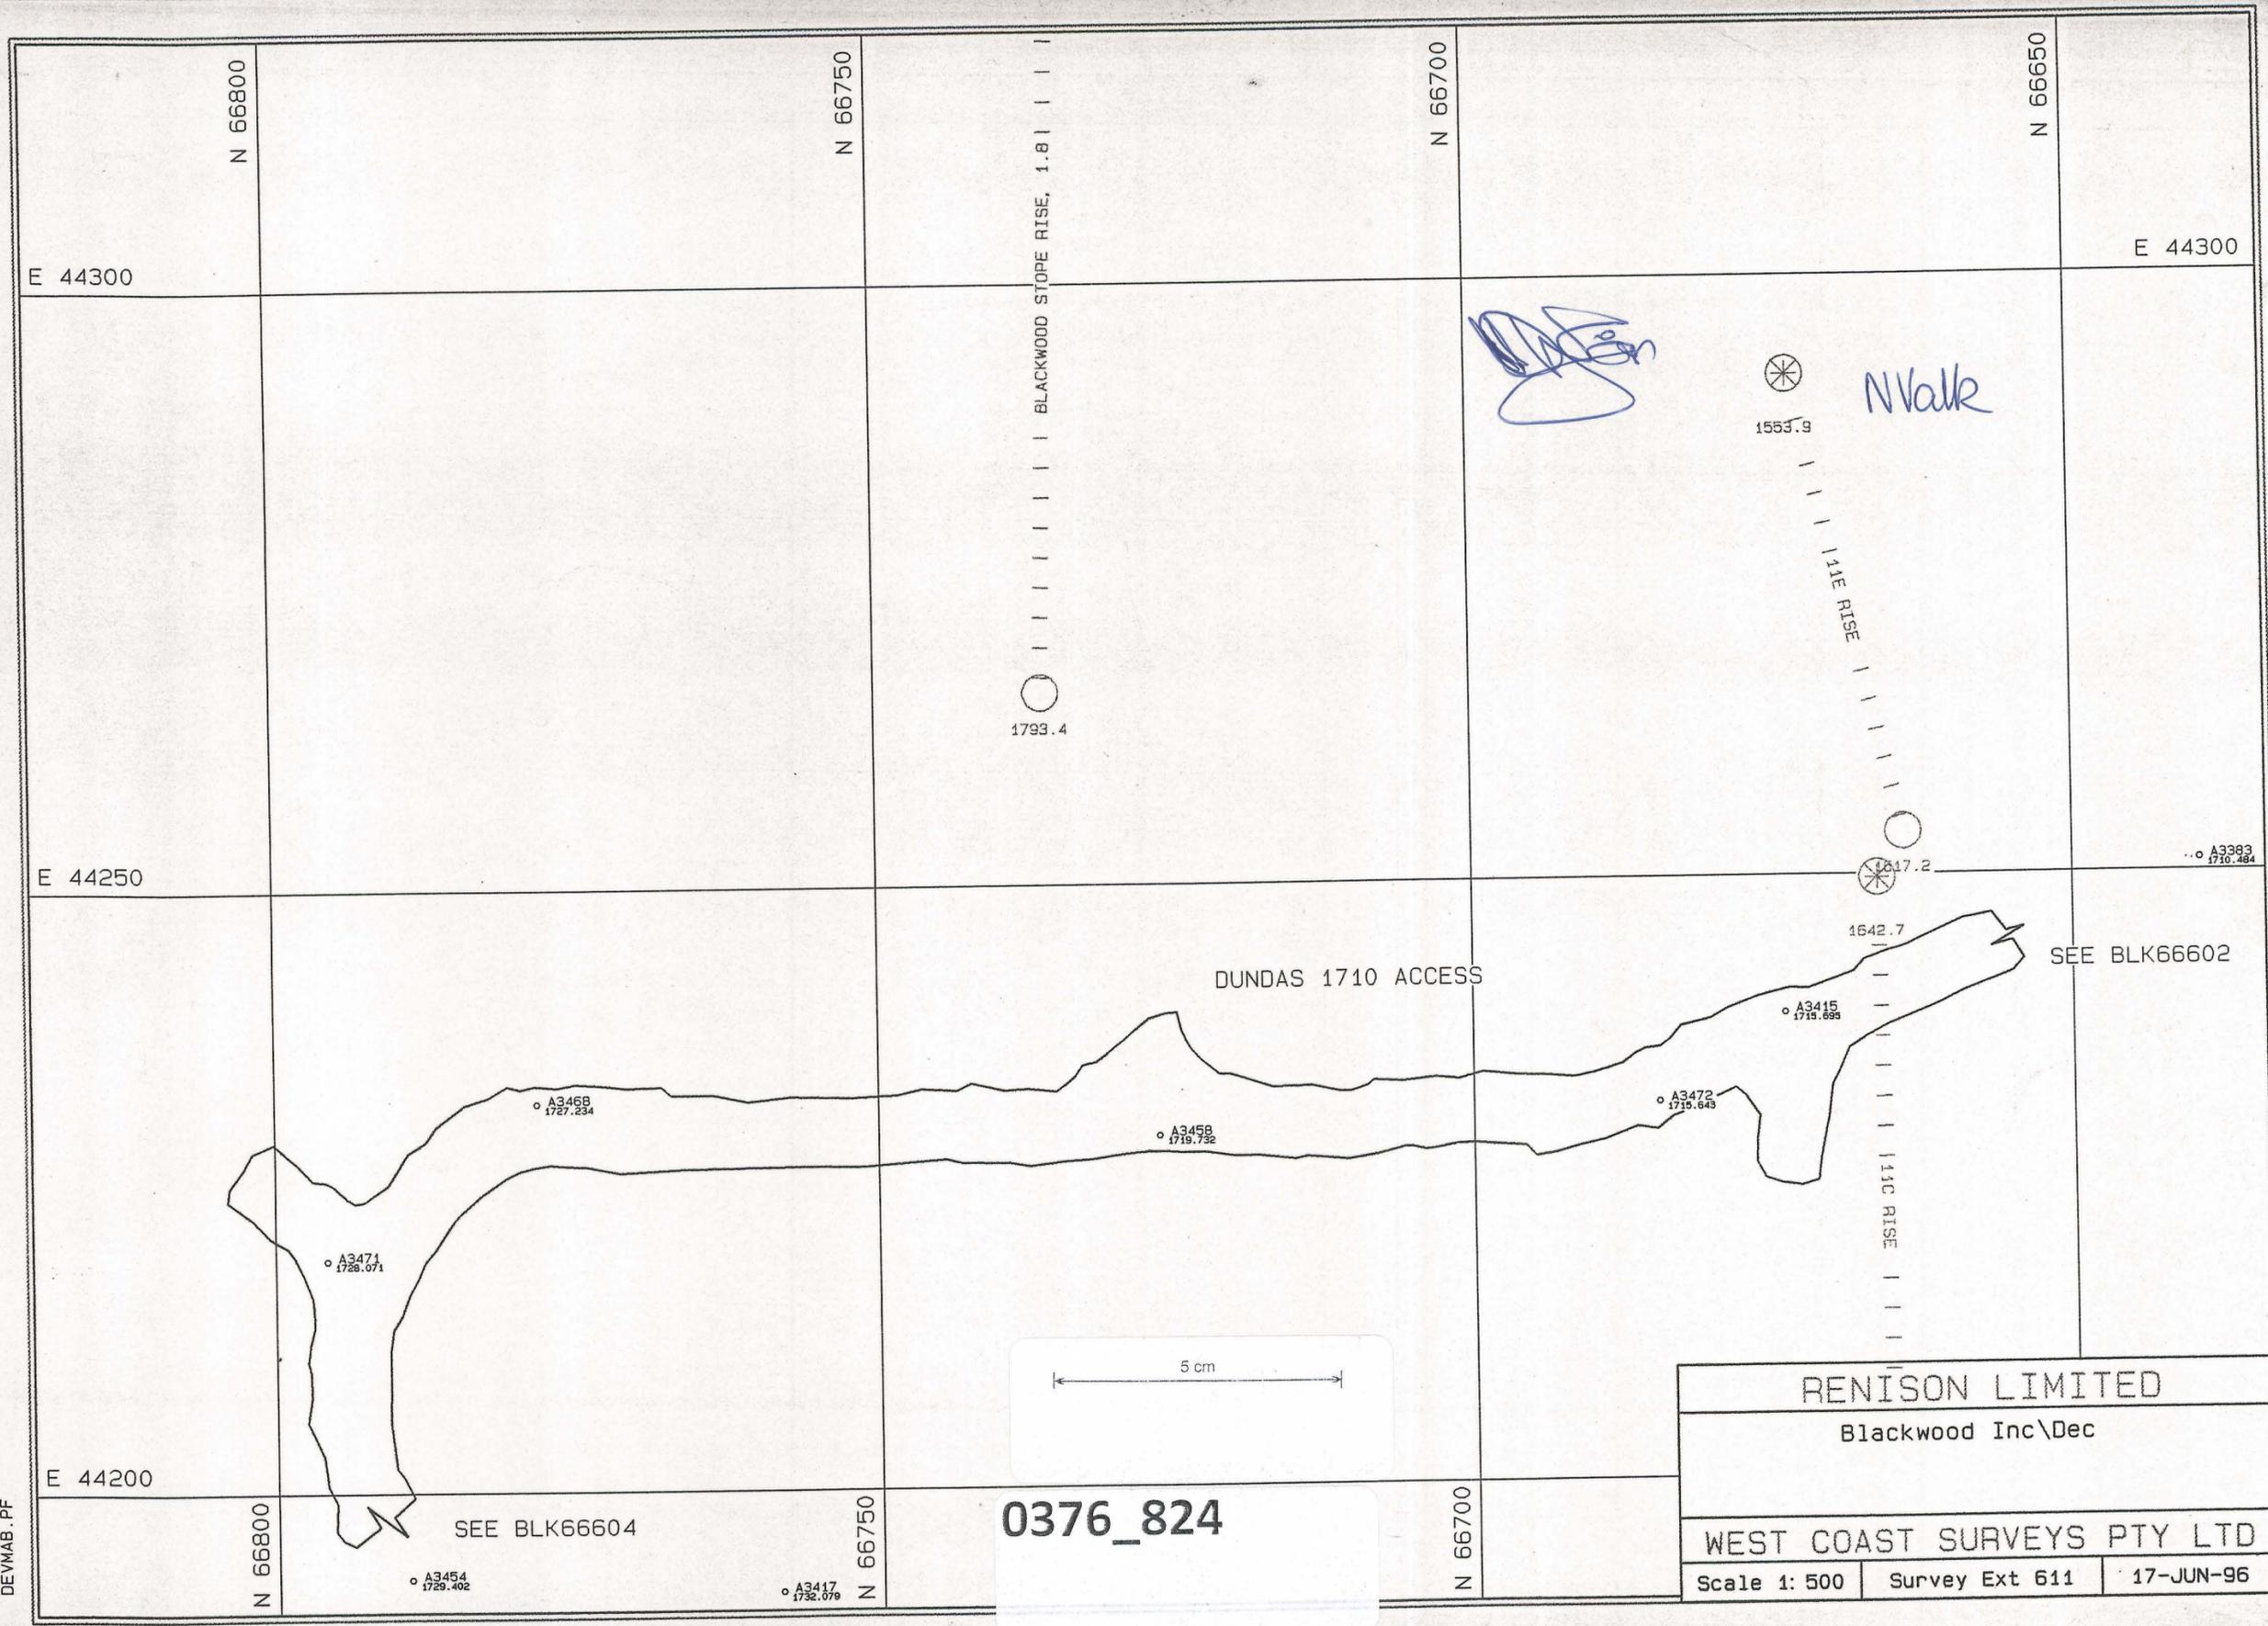

RENISON LIMITED
 Blackwood Inc\Dec
 WEST COAST SURVEYS PTY LTD
 Scale 1: 500 | Survey Ext 611 | 17-JUN-96

0376_824

DEVNAB.PF