


0376_825

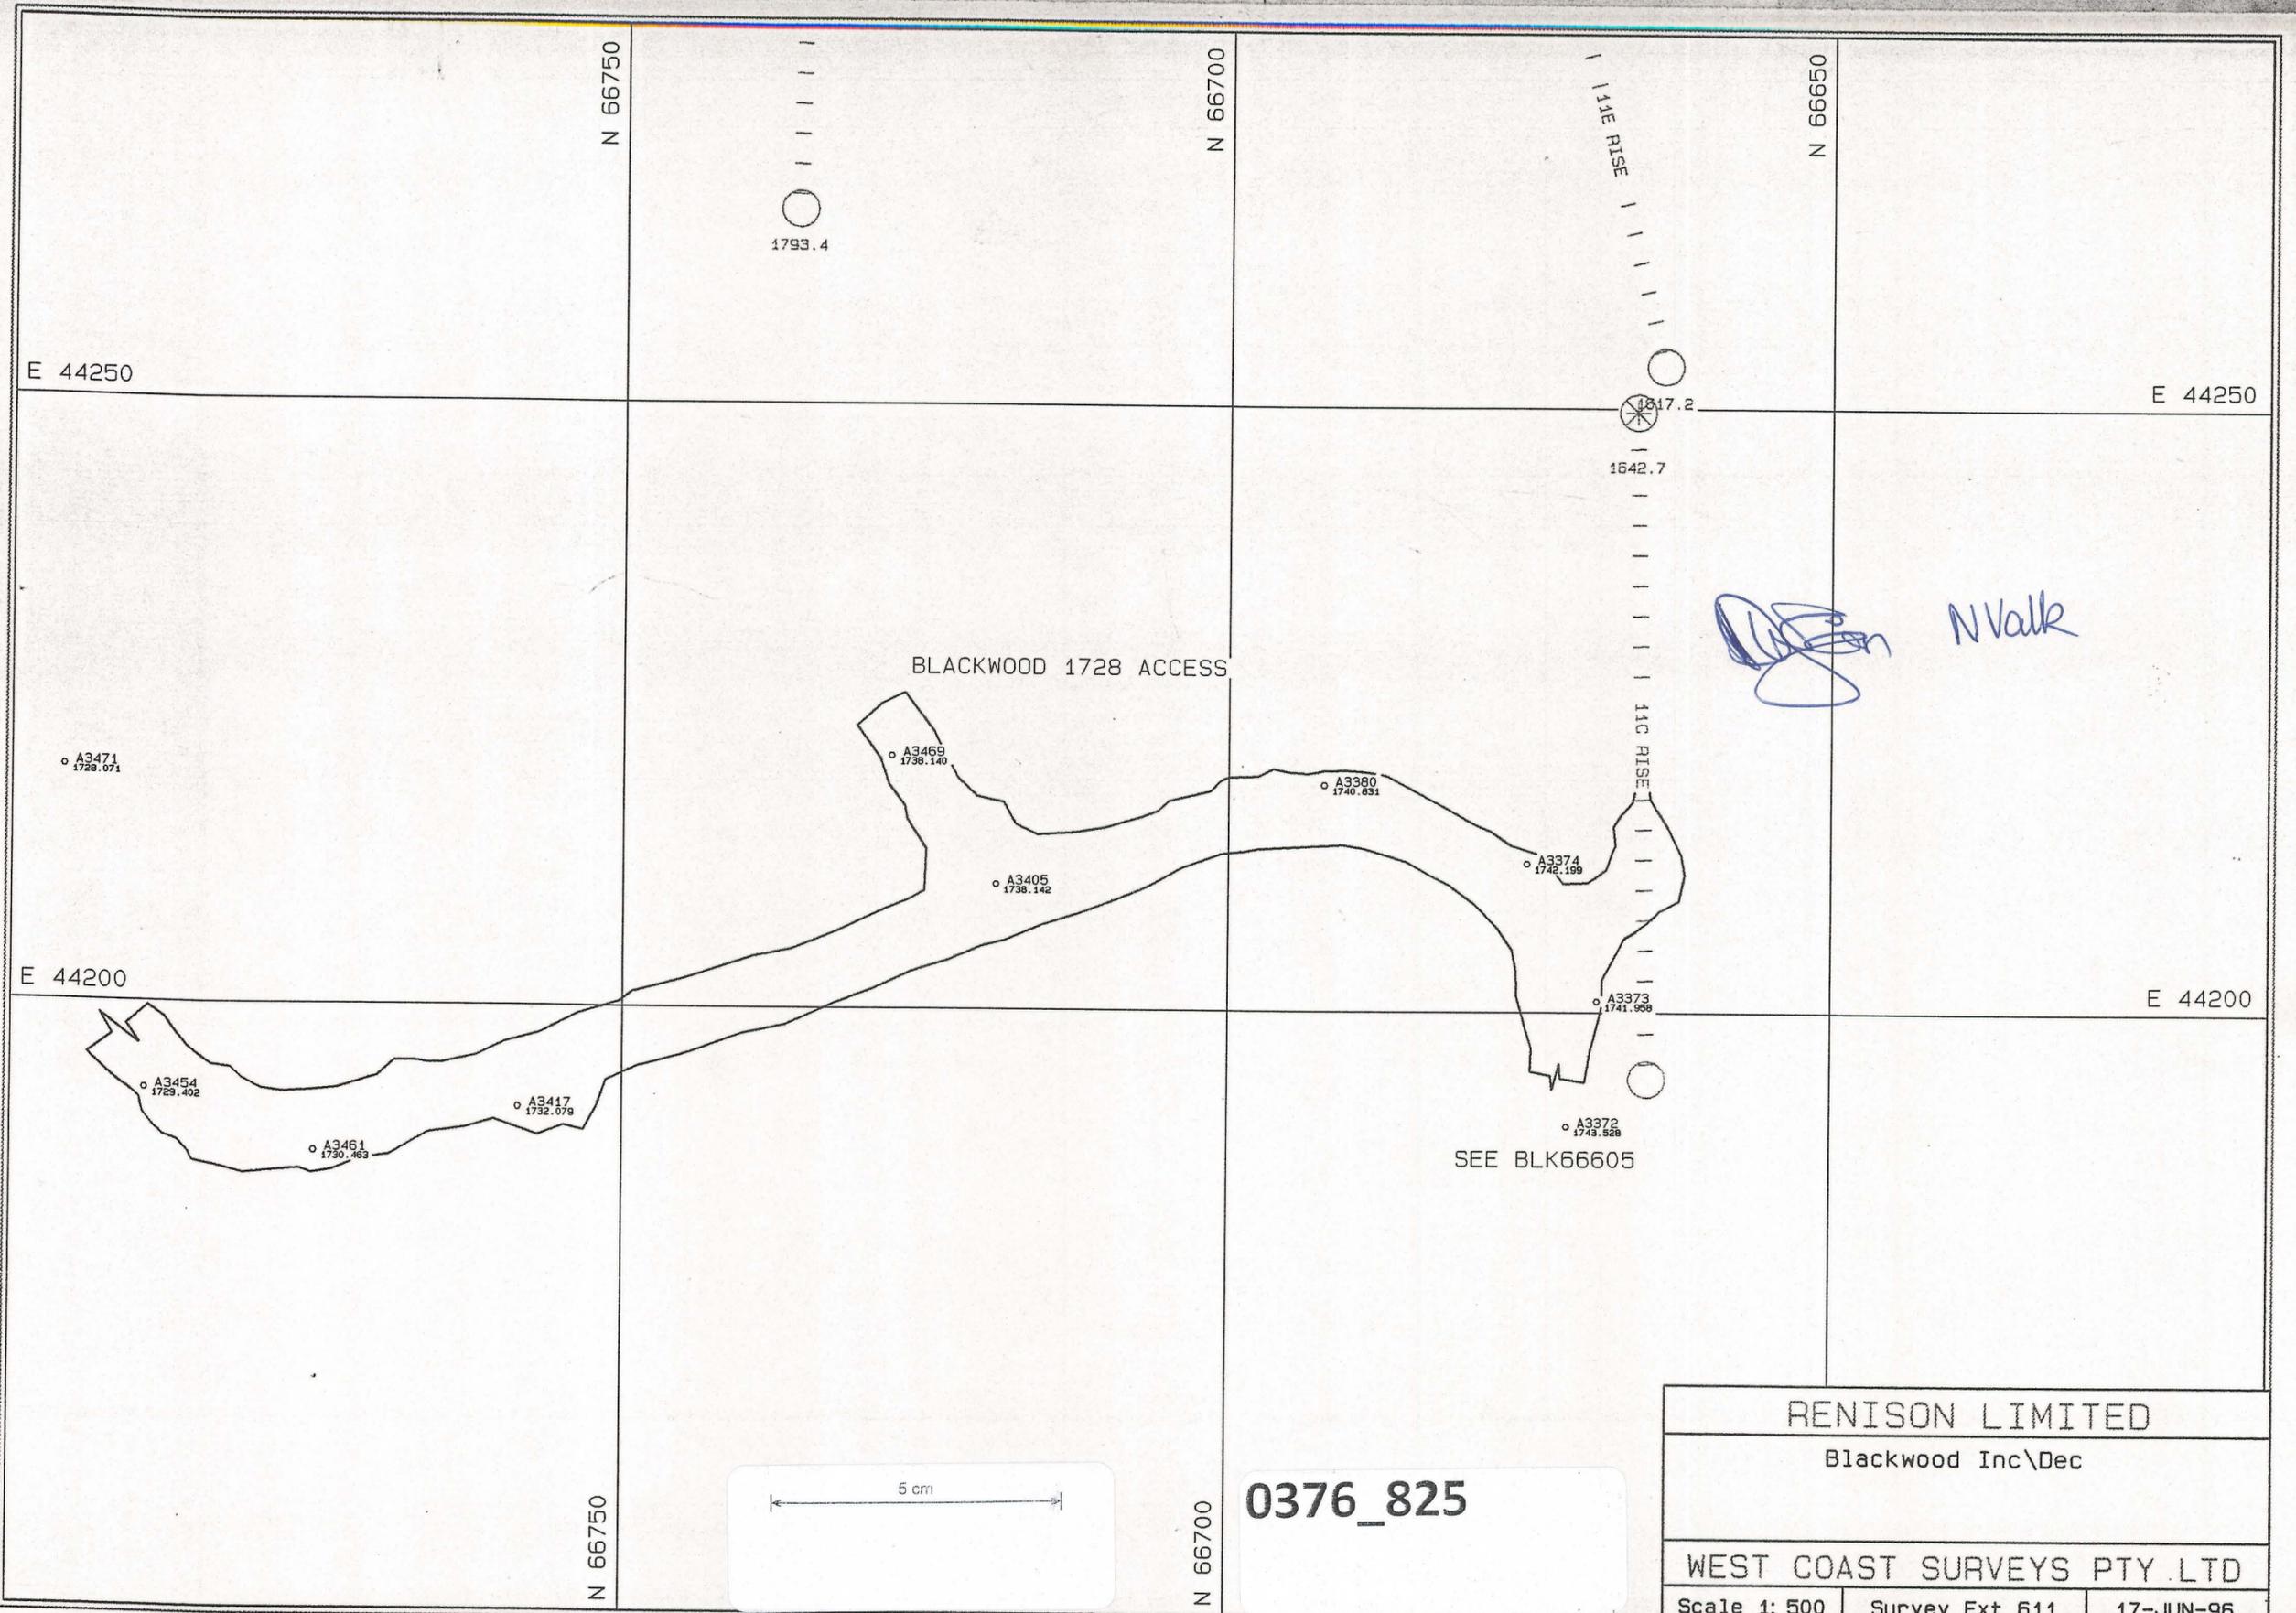

RENISON LIMITED		
Blackwood Inc\Dec		
WEST COAST SURVEYS PTY LTD		
Scale 1: 500	Survey Ext 611	17-JUN-96

0376_825

DEVMAC.PF