


0376_827

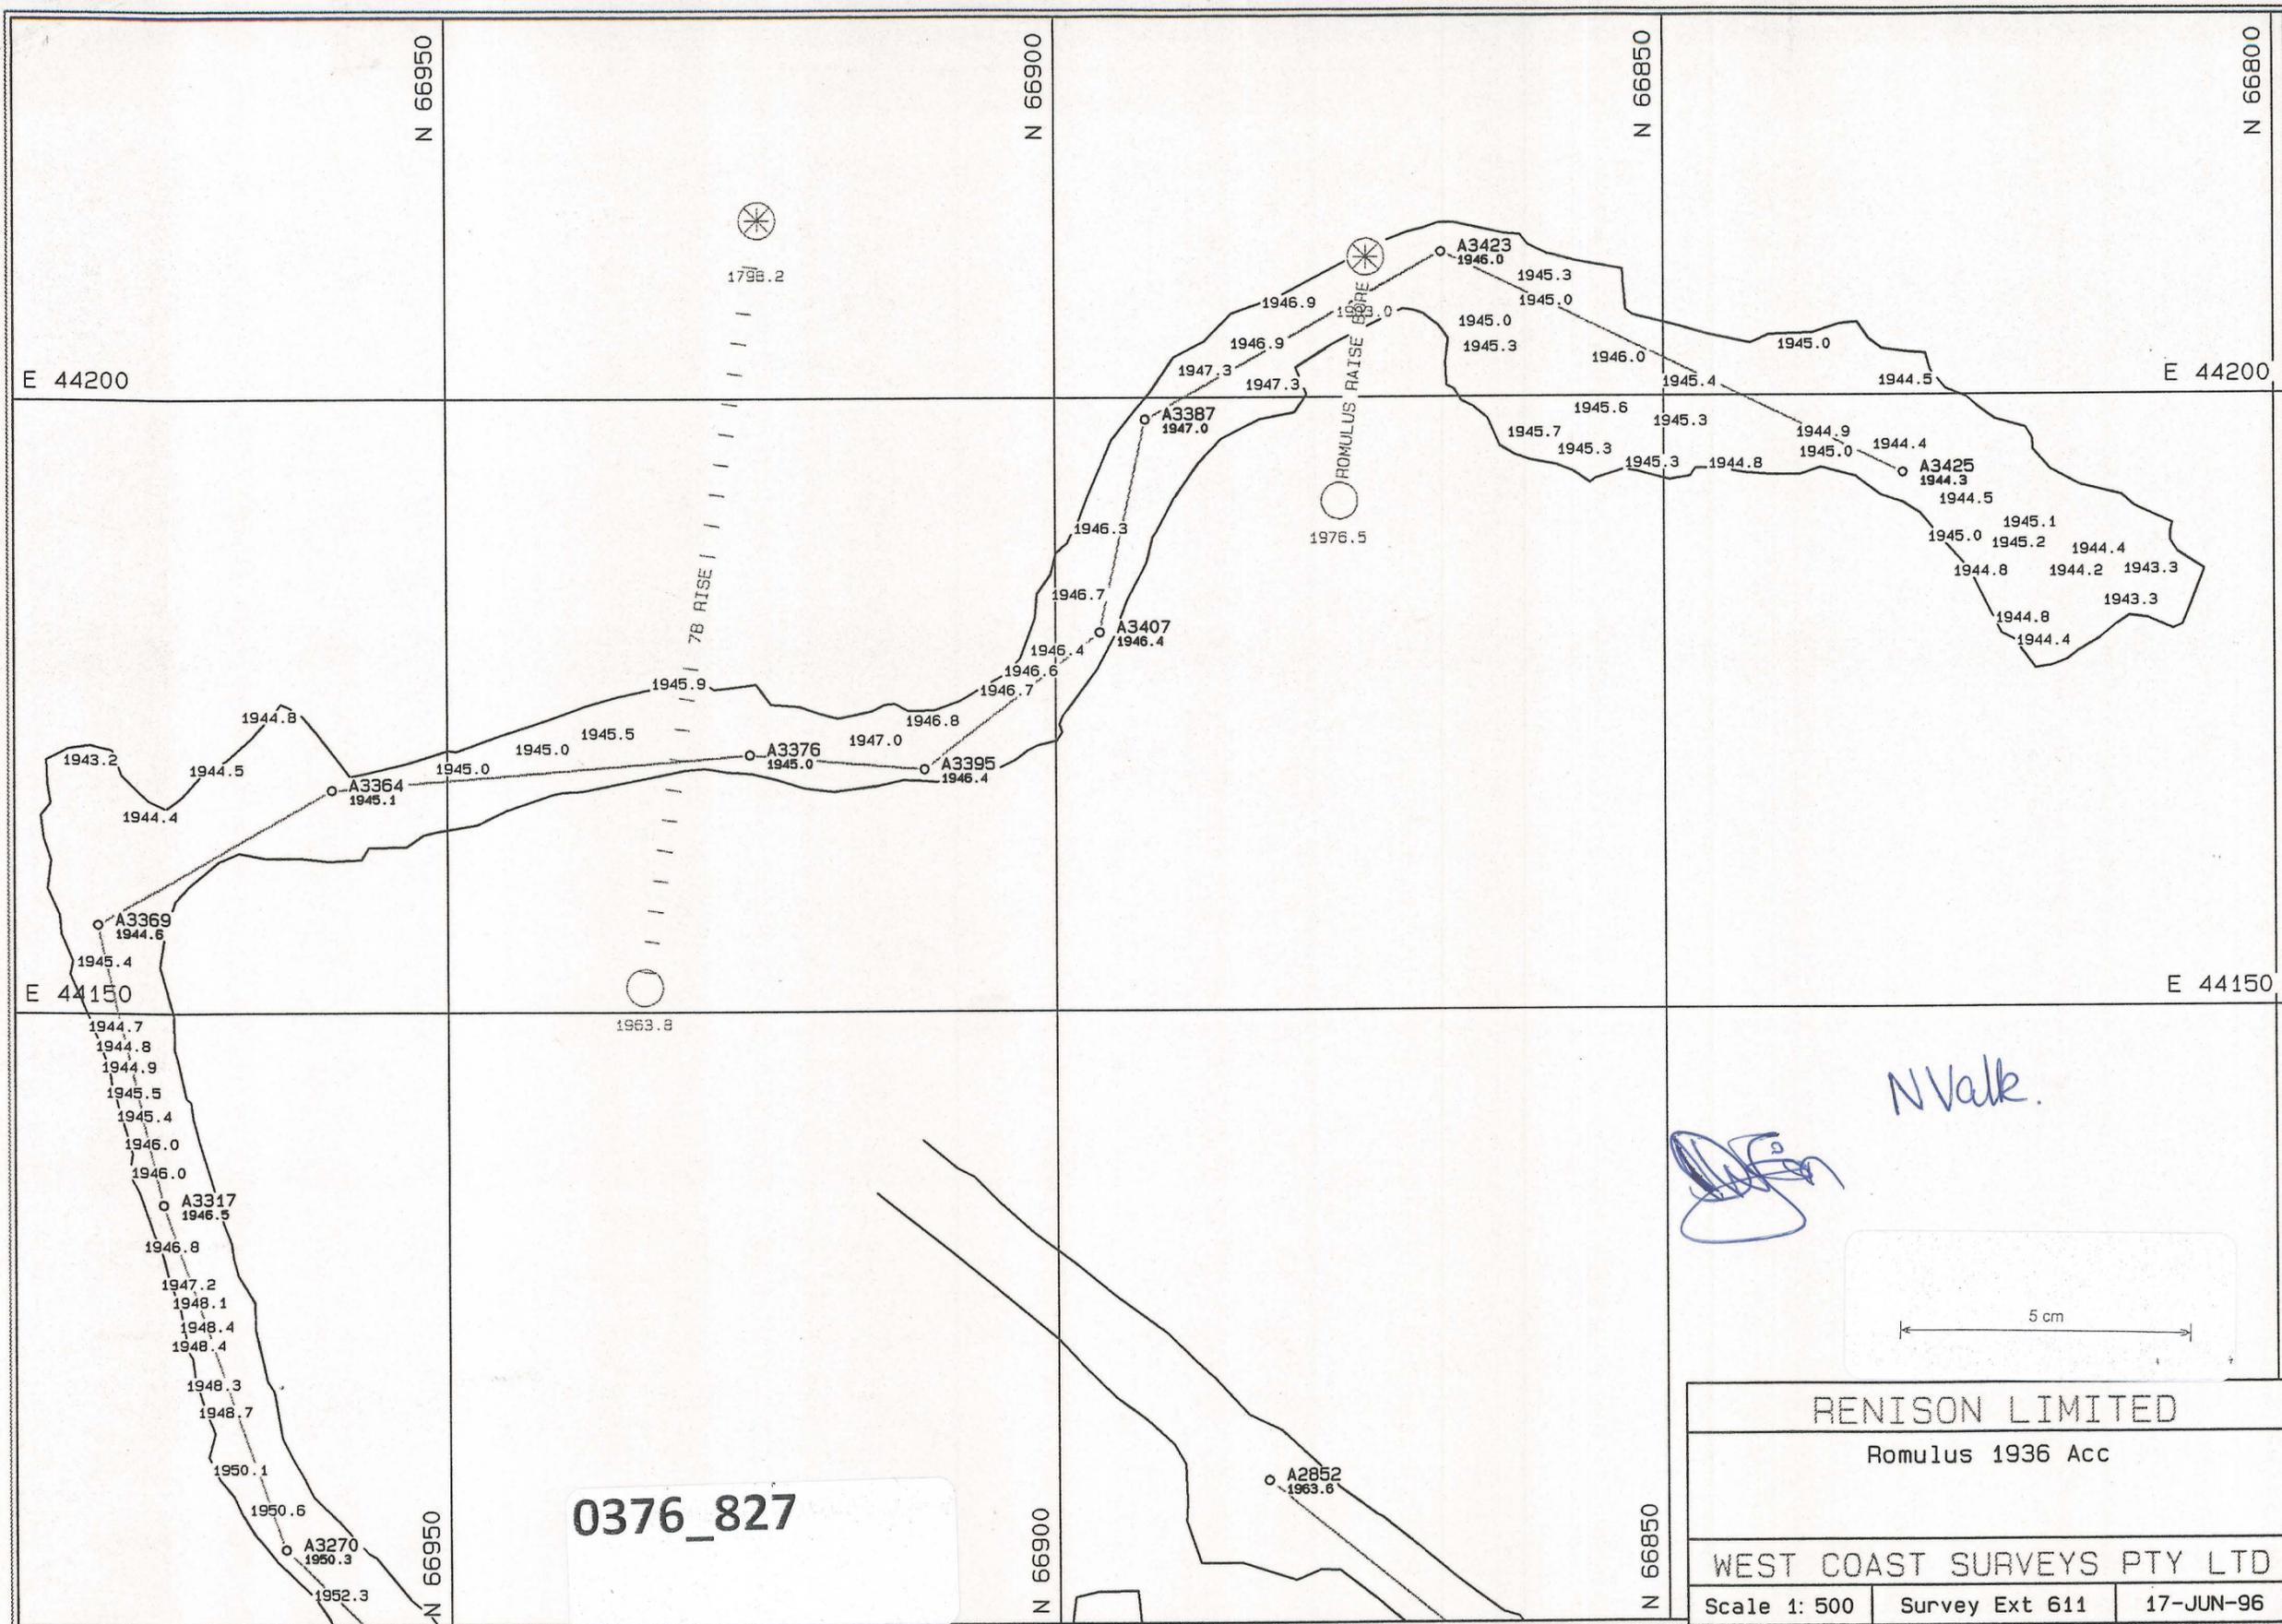

0376_827

ROMULM.PF