


0376\_828

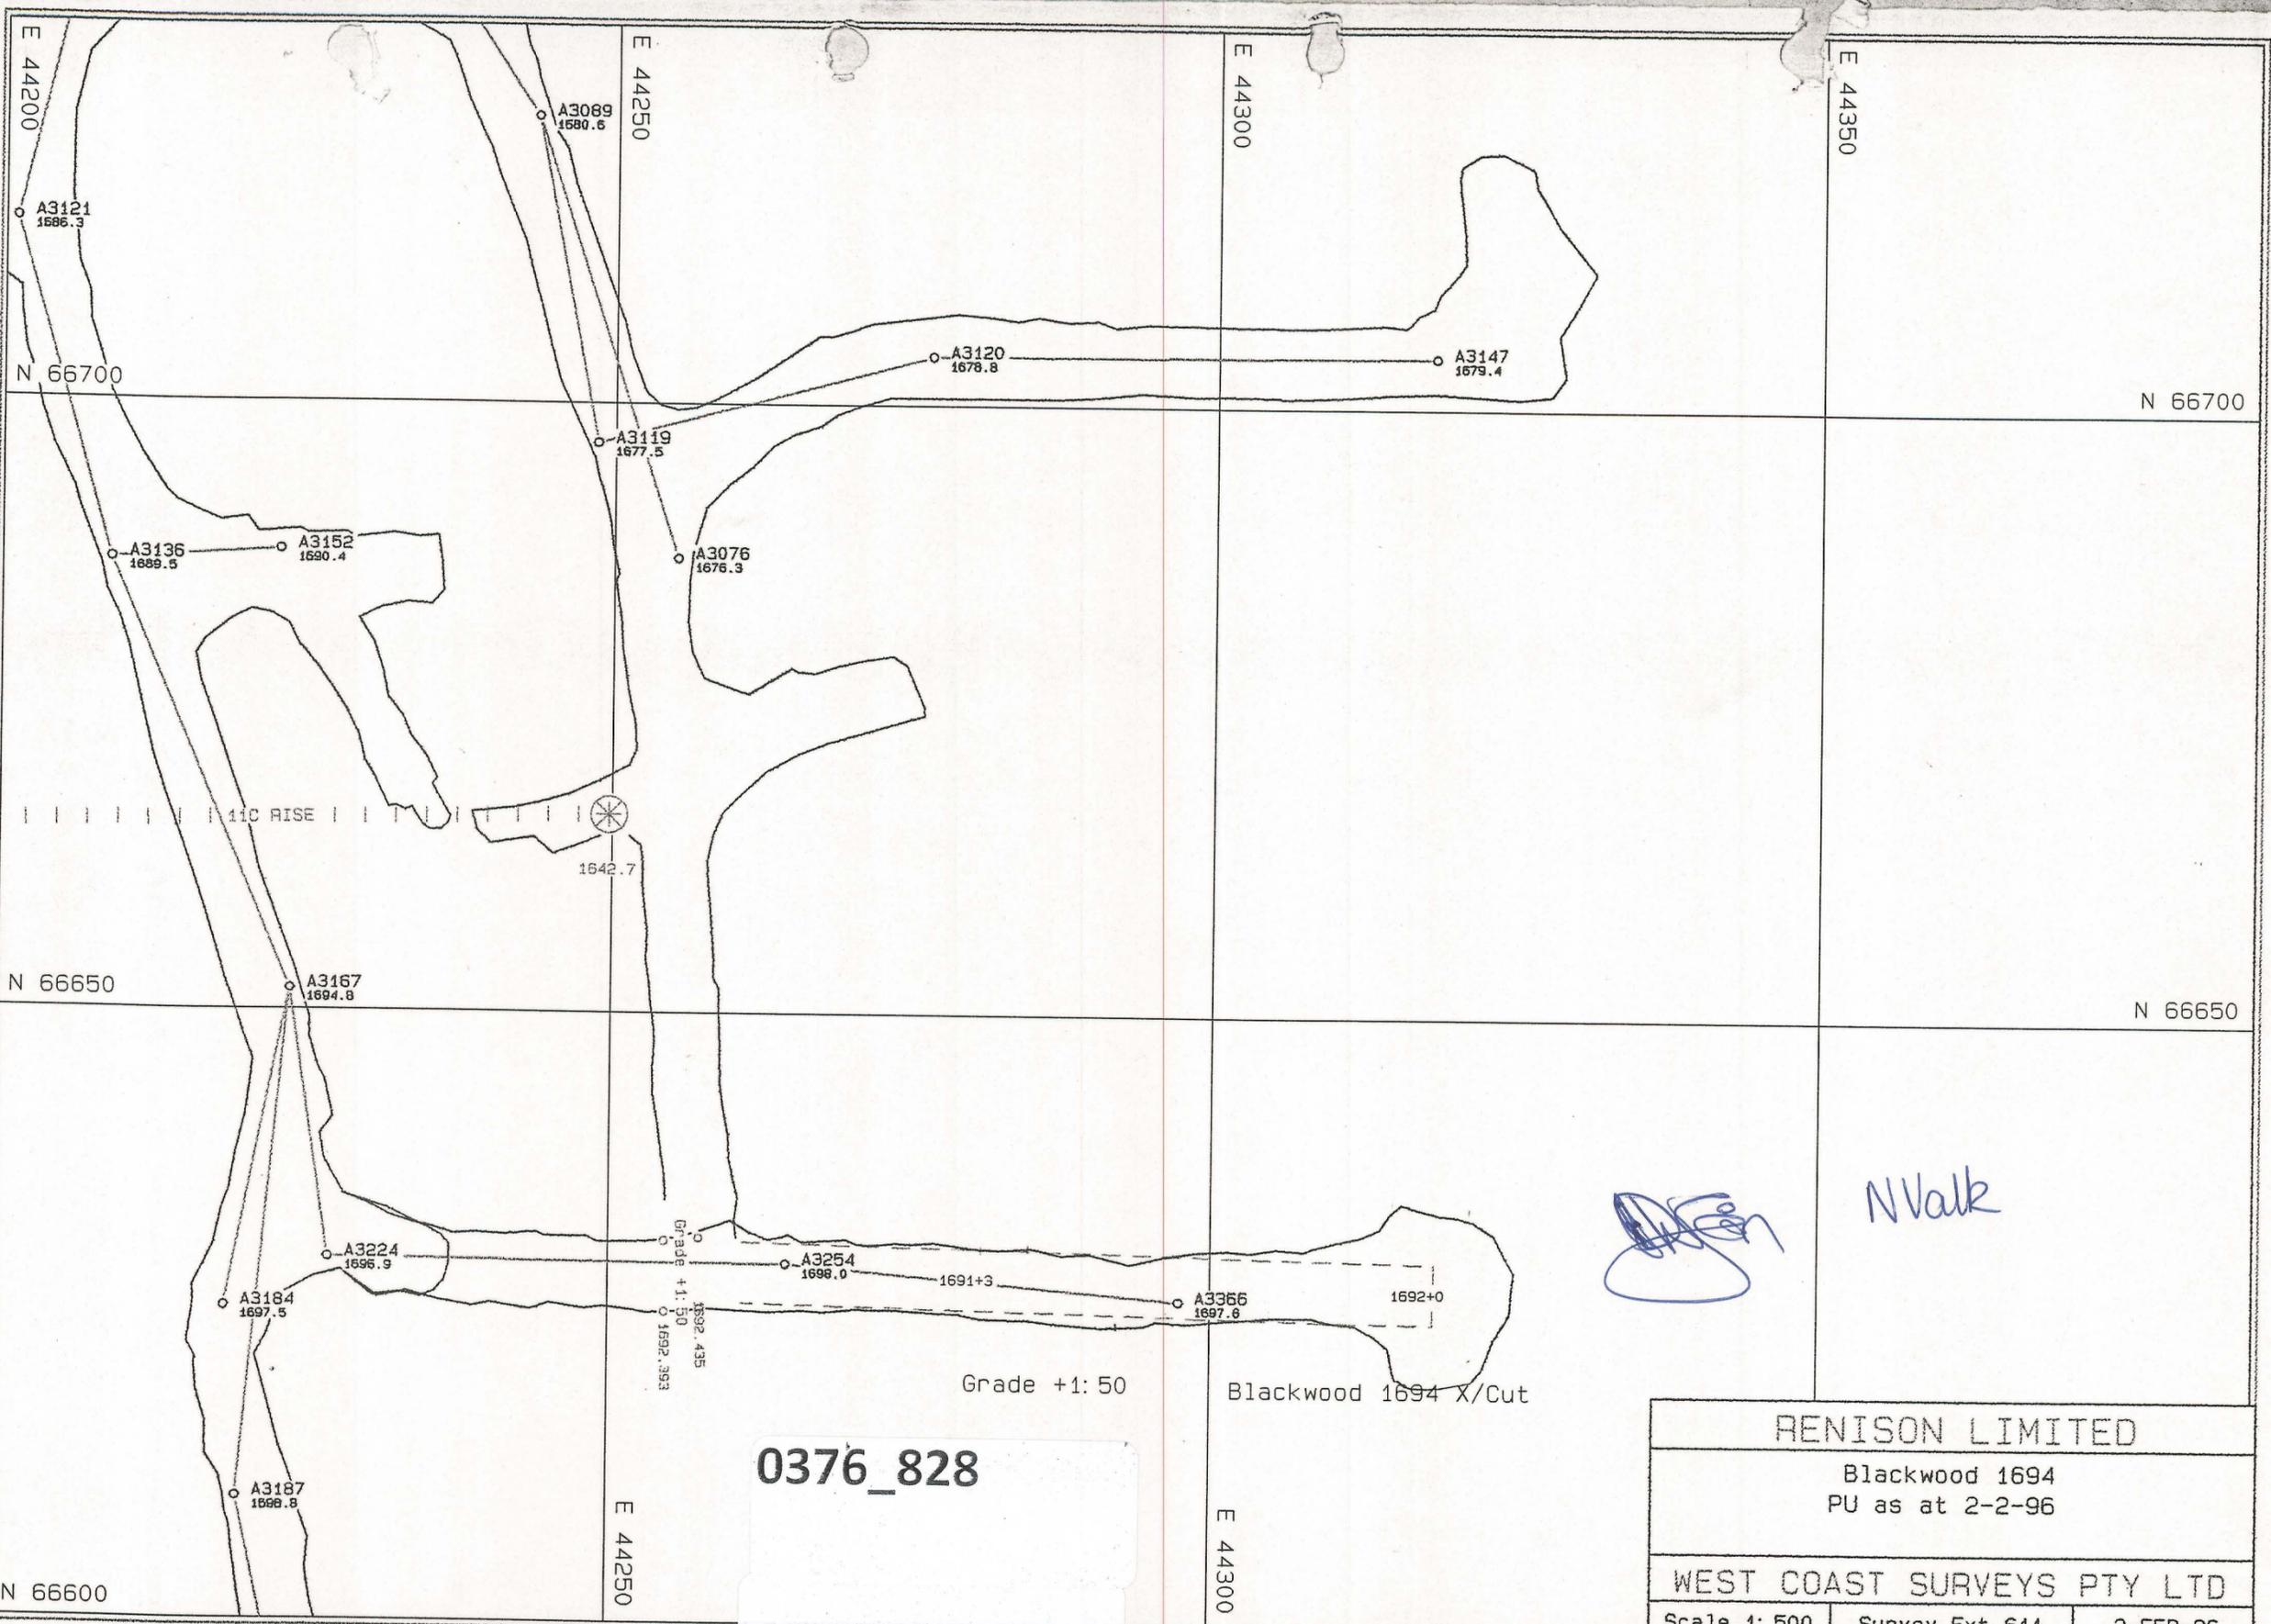

*N Valk*

0376\_828

5 cm

RENISON LIMITED		
Blackwood 1694 PU as at 2-2-96		
WEST COAST SURVEYS PTY LTD		
Scale 1: 500	Survey Ext 611	2-FEB-96