


0376-829

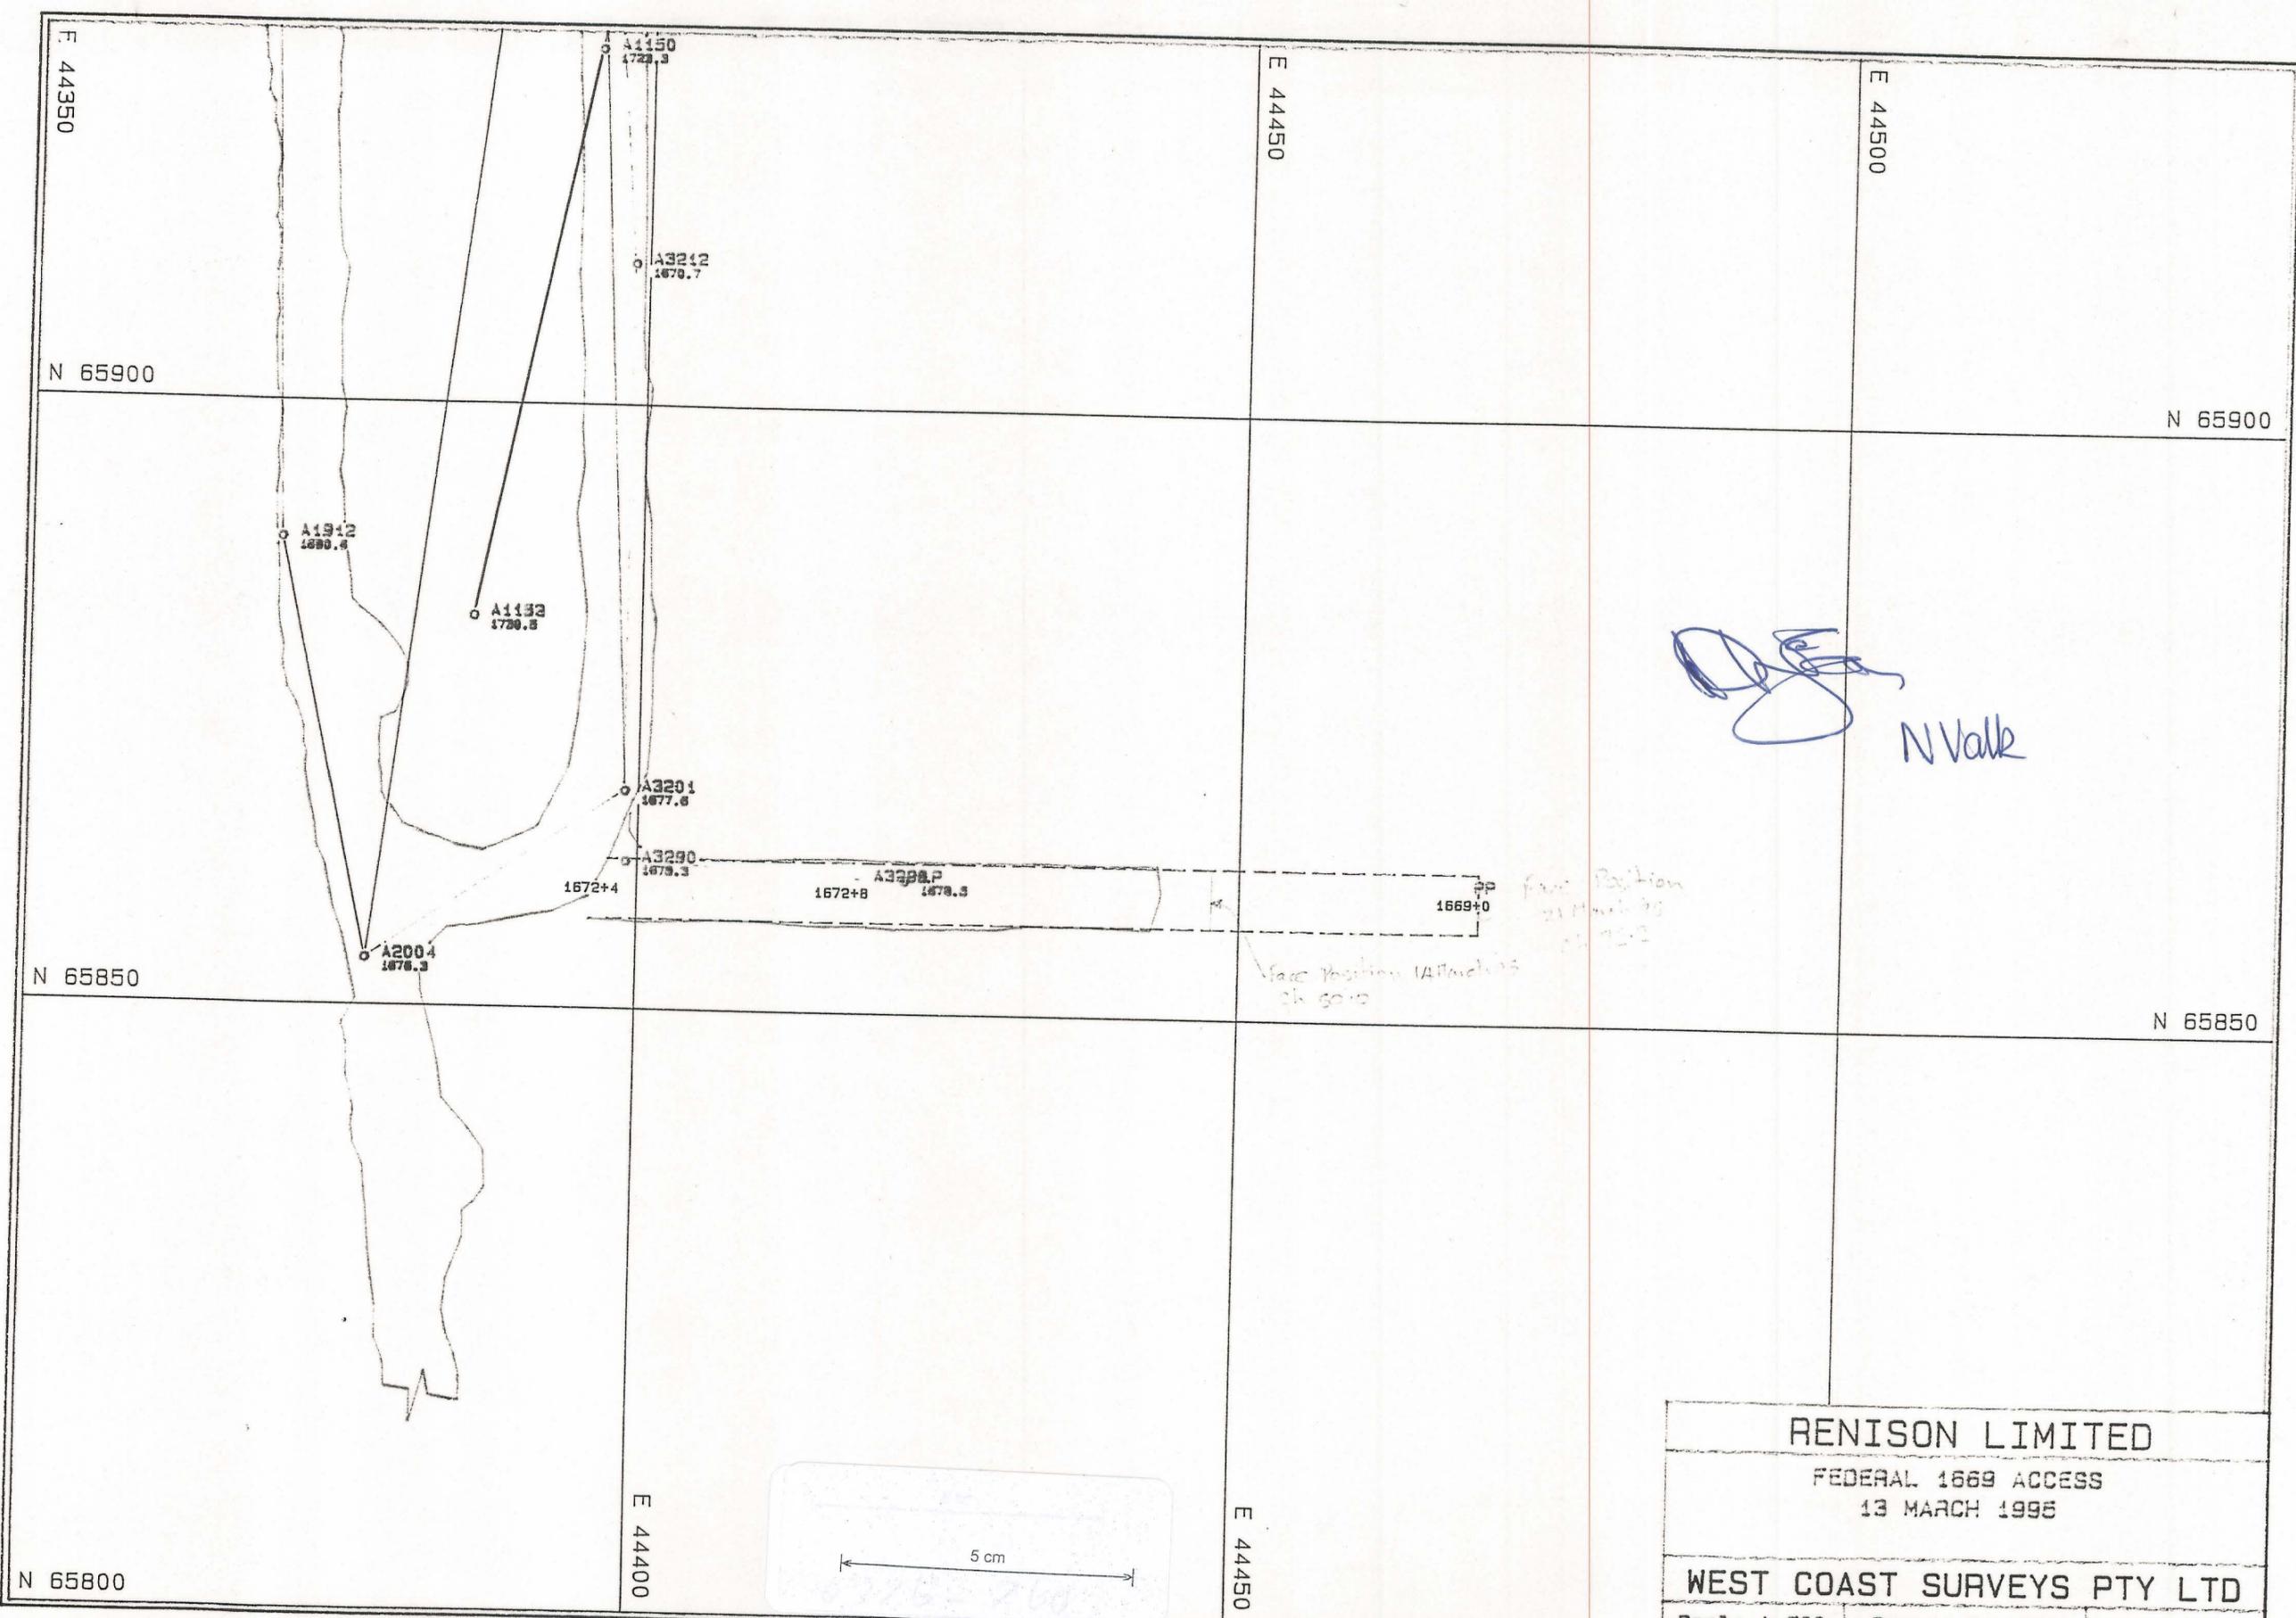

N Valle

Face Position 14/11/95
ok gold
Face Position 21/11/95
ok gold

RENISON LIMITED		
FEDERAL 1669 ACCESS		
13 MARCH 1995		
WEST COAST SURVEYS PTY LTD		
Scale 1: 500	Survey Ext: 611	13-MAR-95

