


0376-830

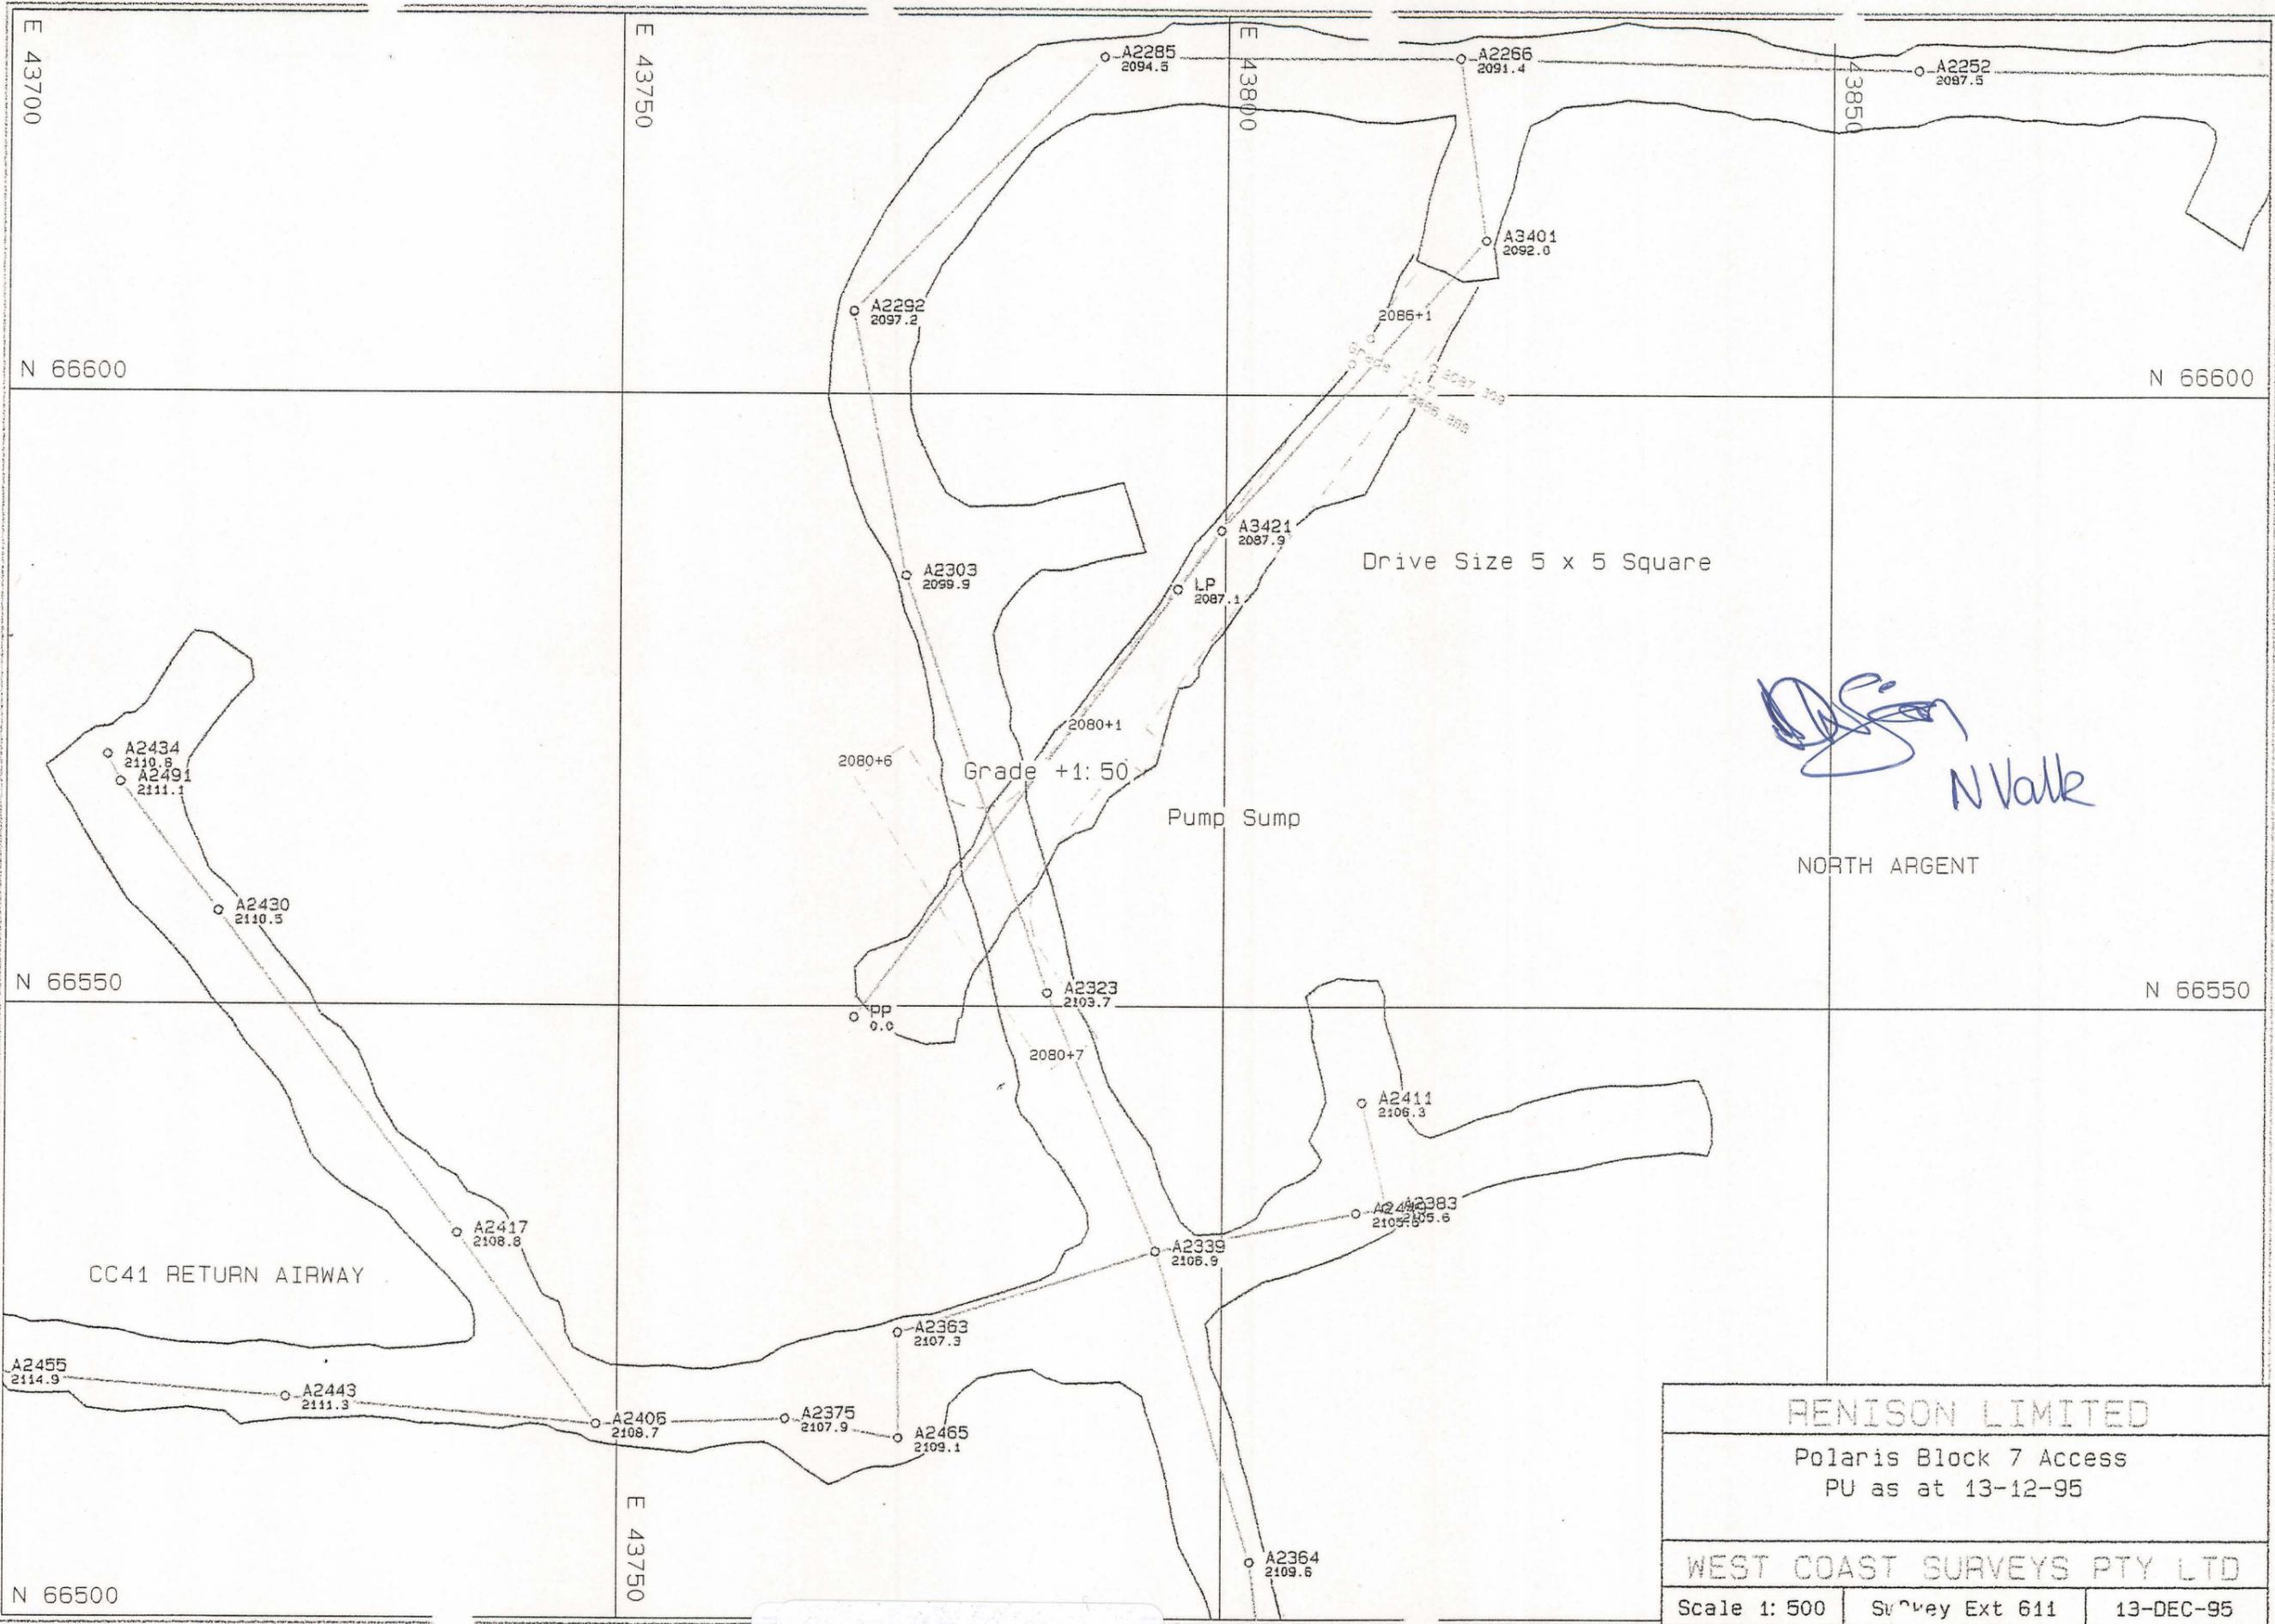

N Valk
N Valk

NORTH ARGENT

RENISON LIMITED		
Polaris Block 7 Access PU as at 13-12-95		
WEST COAST SURVEYS PTY LTD		
Scale 1: 500	Survey Ext 611	13-DEC-95

