



0376-831

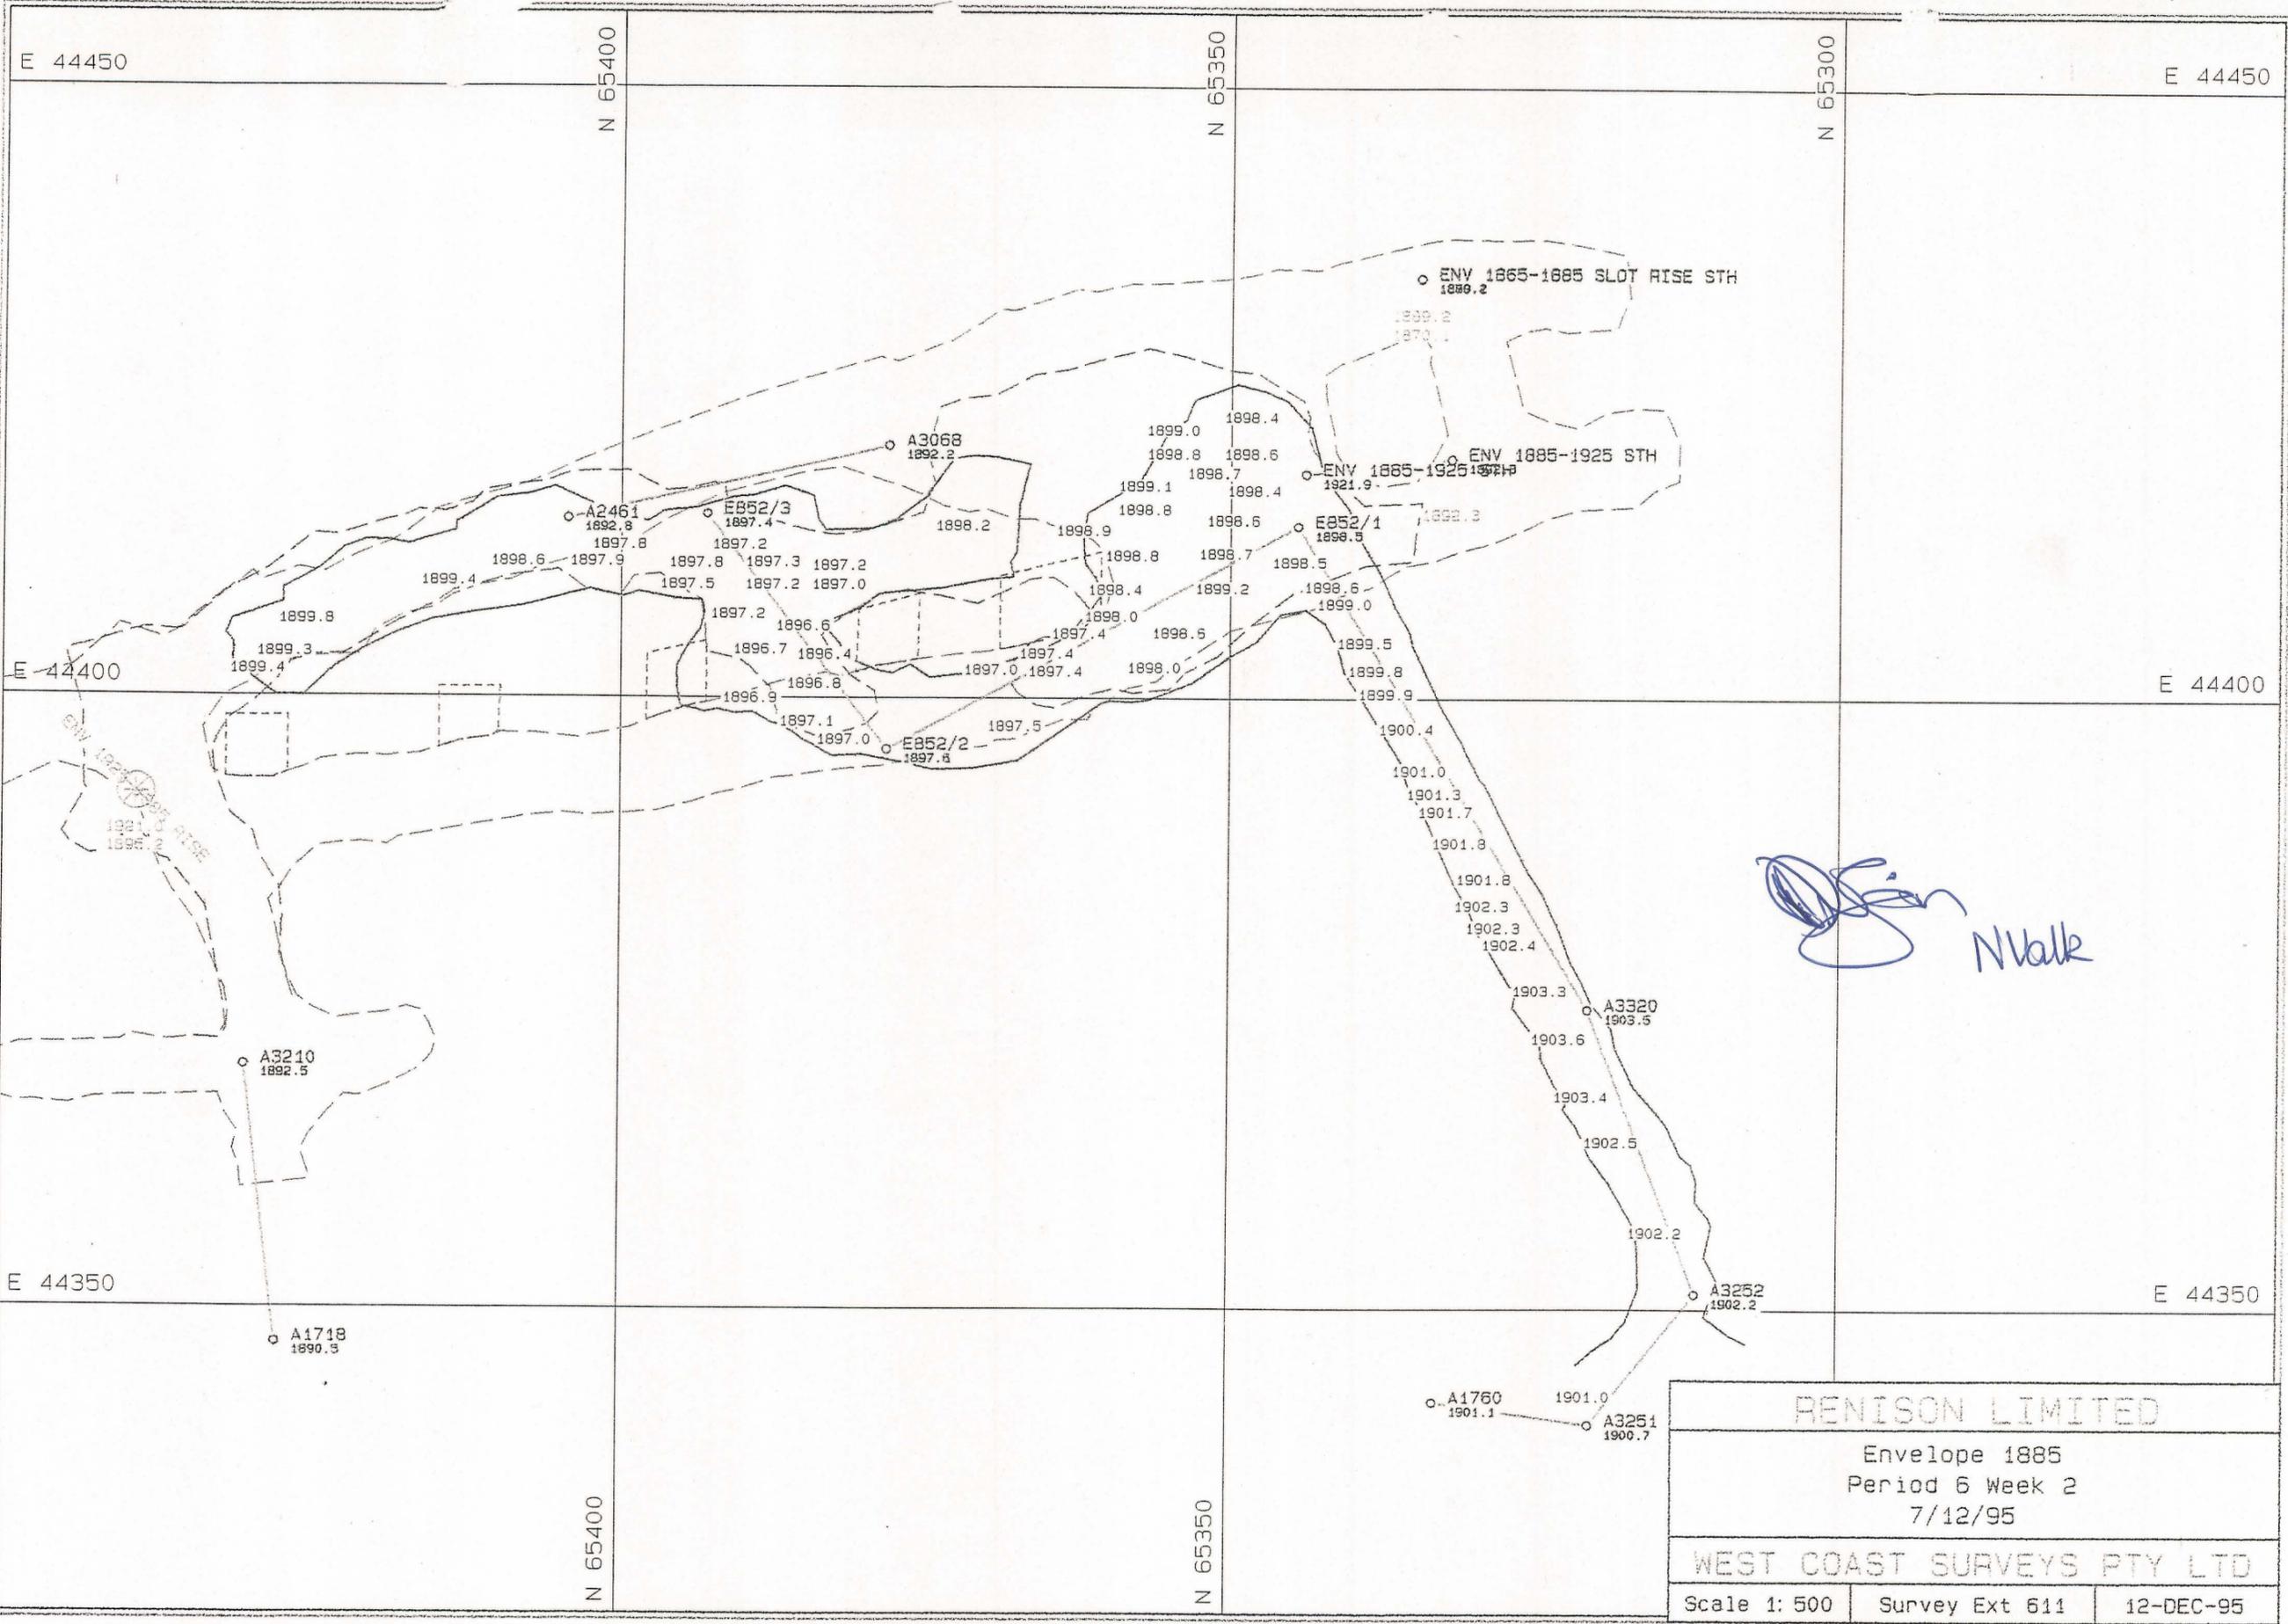

RENISON LIMITED		
Envelope 1885		
Period 6 Week 2		
7/12/95		
WEST COAST SURVEYS PTY LTD		
Scale 1: 500	Survey Ext 611	12-DEC-95

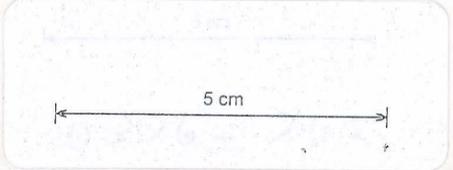

ENVELA .PF