


3-11
-02

3-11
-02

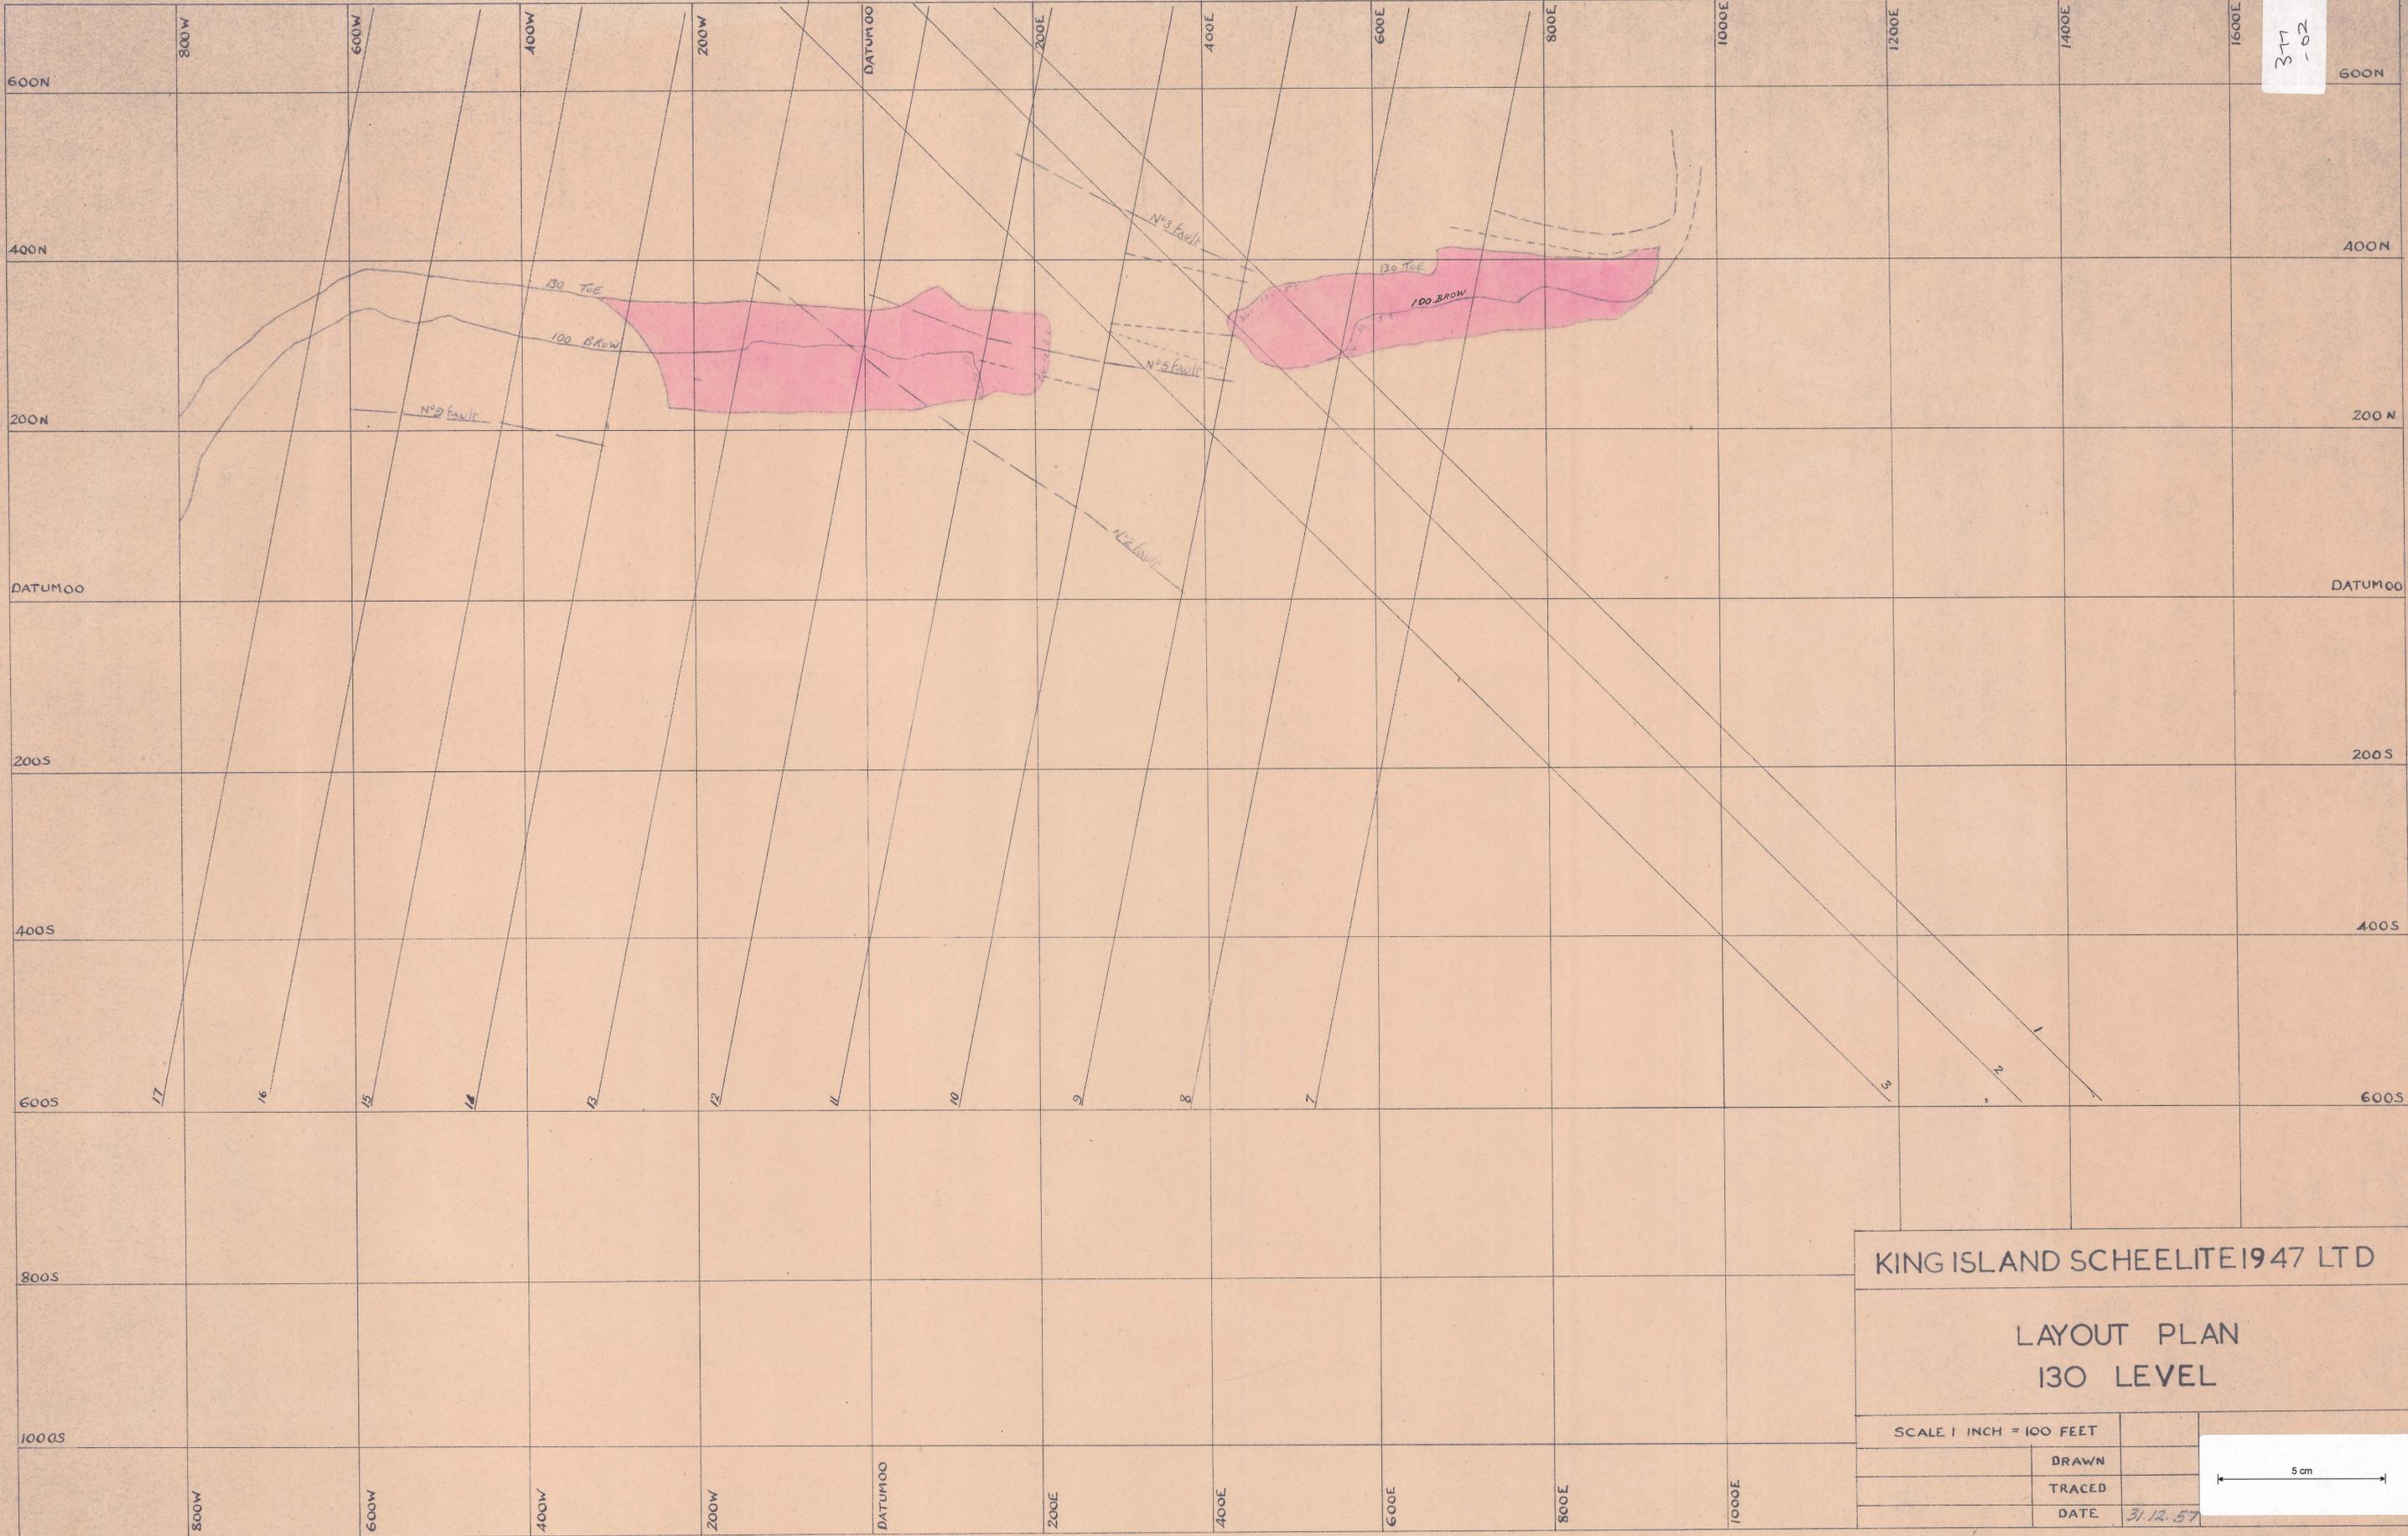

KING ISLAND SCHEELITE 1947 LTD

LAYOUT PLAN
130 LEVEL

SCALE 1 INCH = 100 FEET

DRAWN	
TRACED	
DATE	31.12.57

5 cm