


317-63

317-63

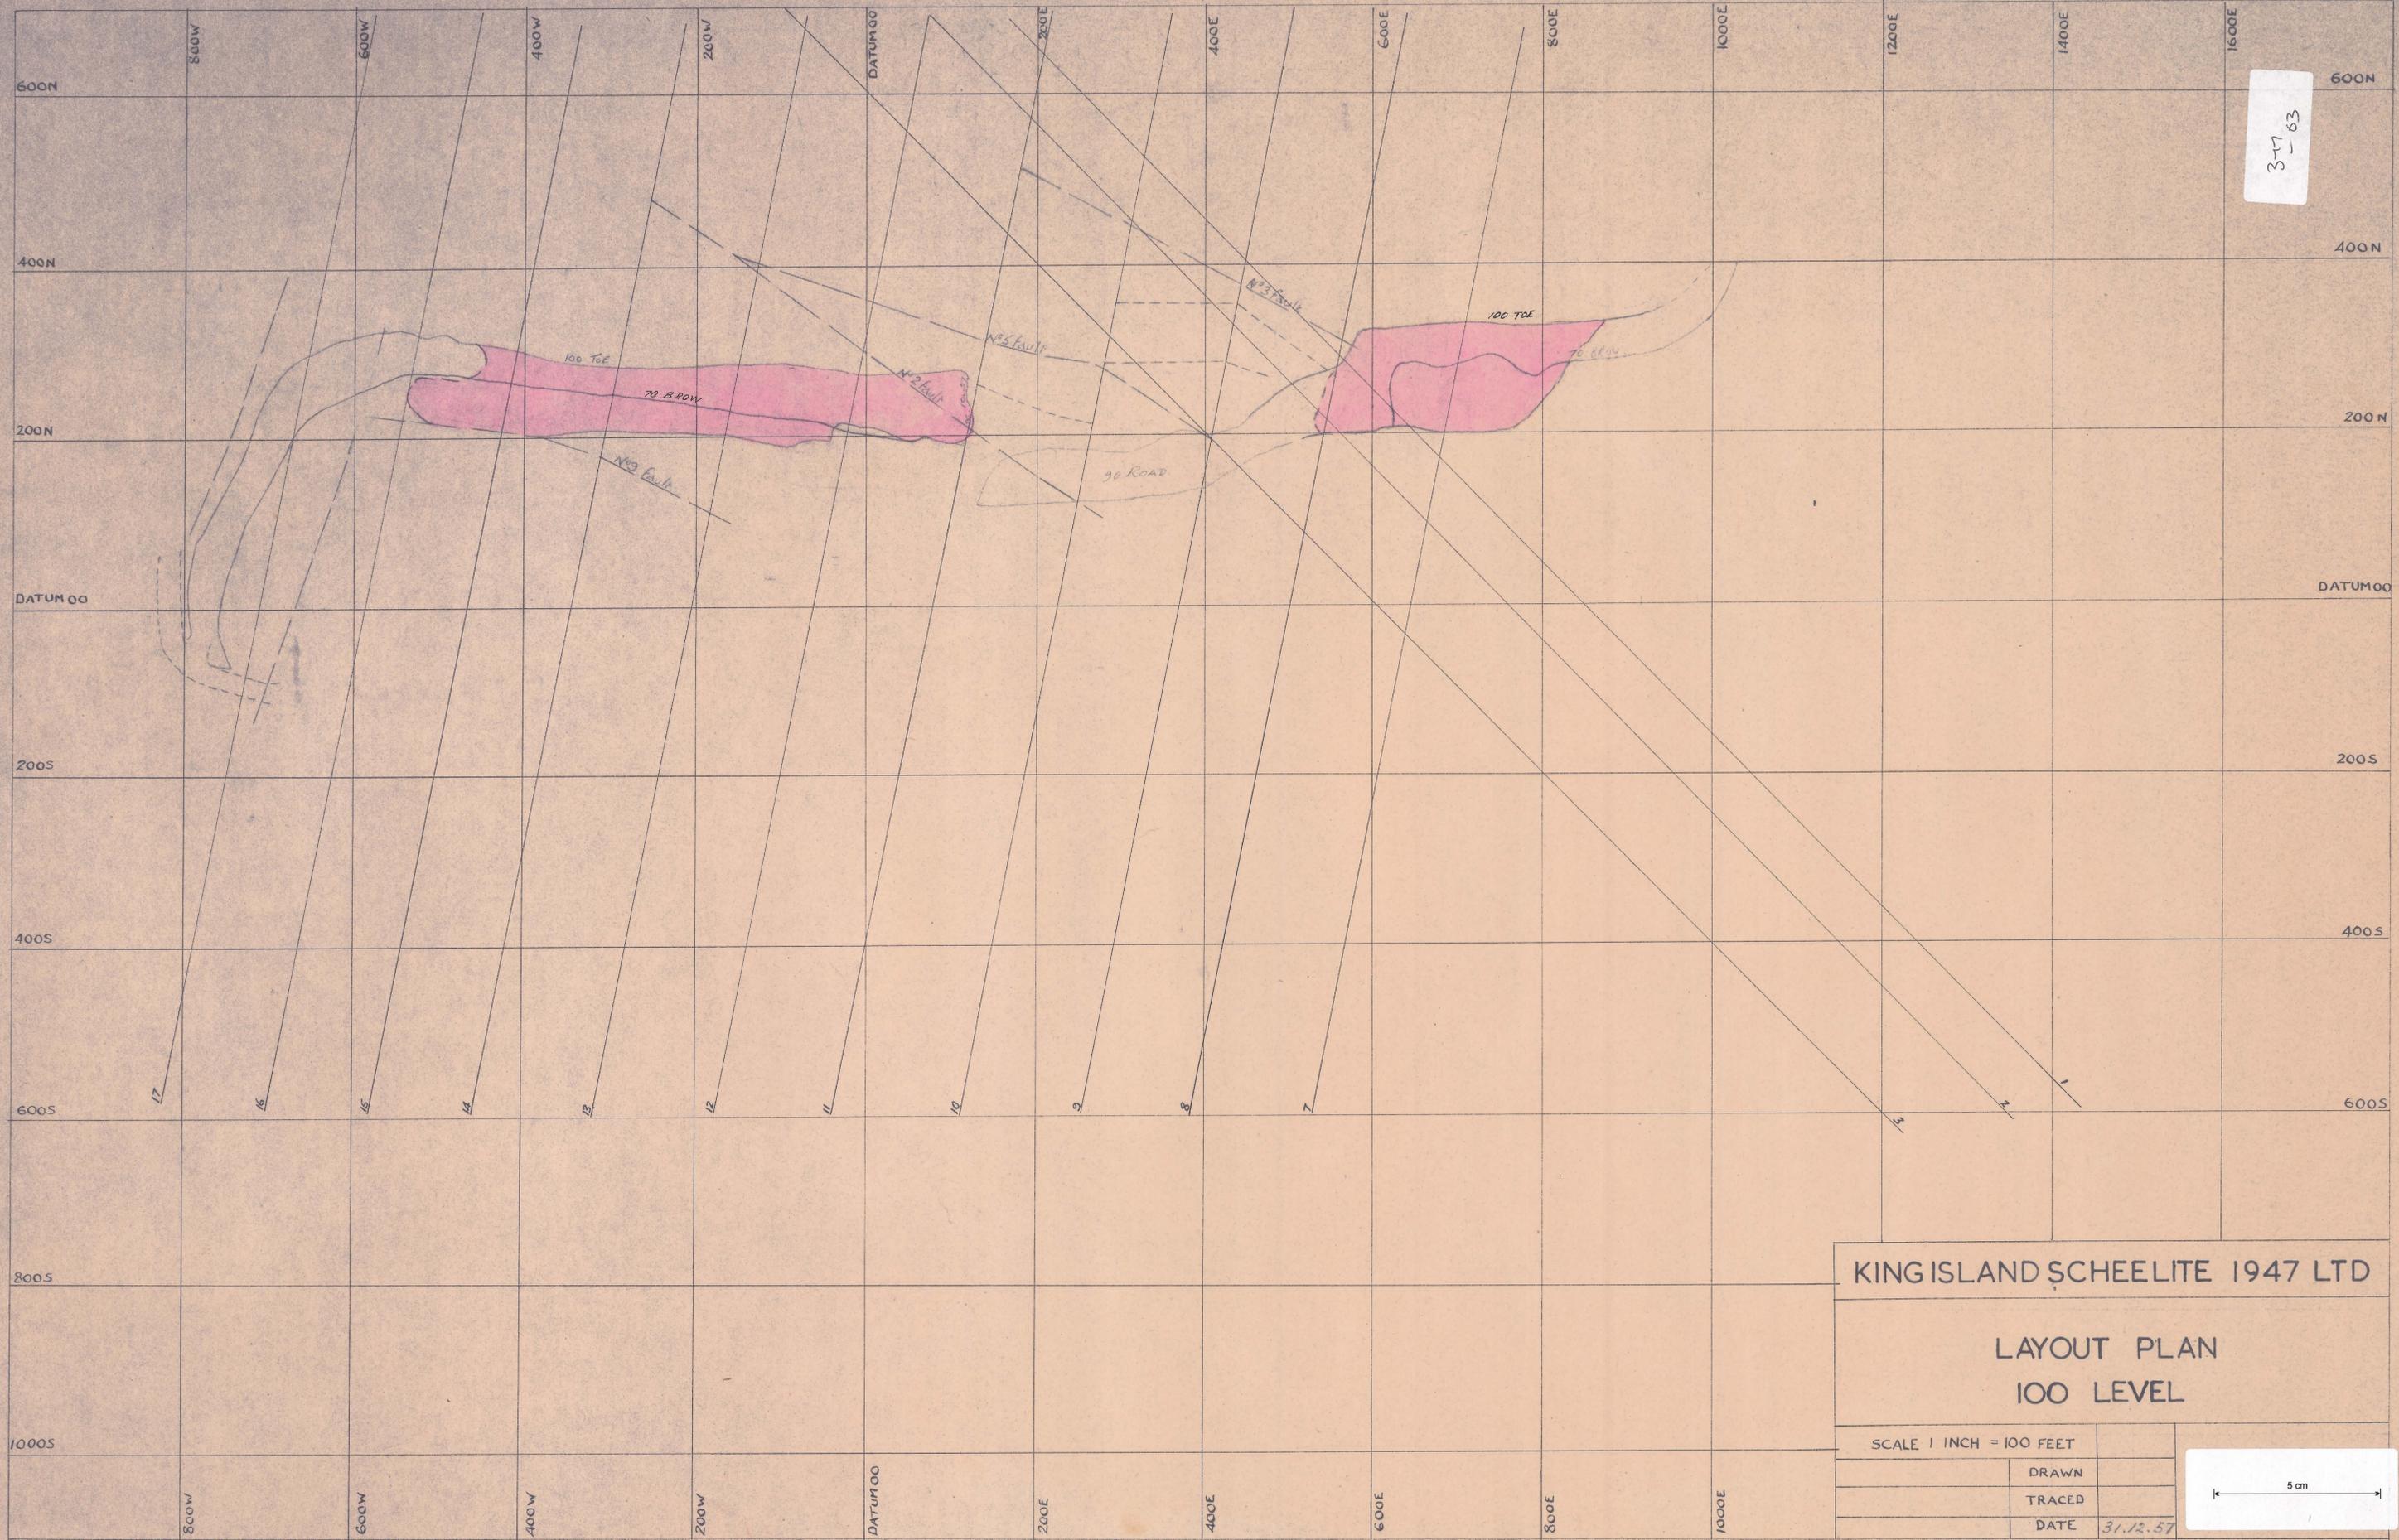

KING ISLAND SCHEELITE 1947 LTD

LAYOUT PLAN
100 LEVEL

SCALE 1 INCH = 100 FEET

DRAWN

TRACED

DATE

31.12.57

