


311
-05

311
-05

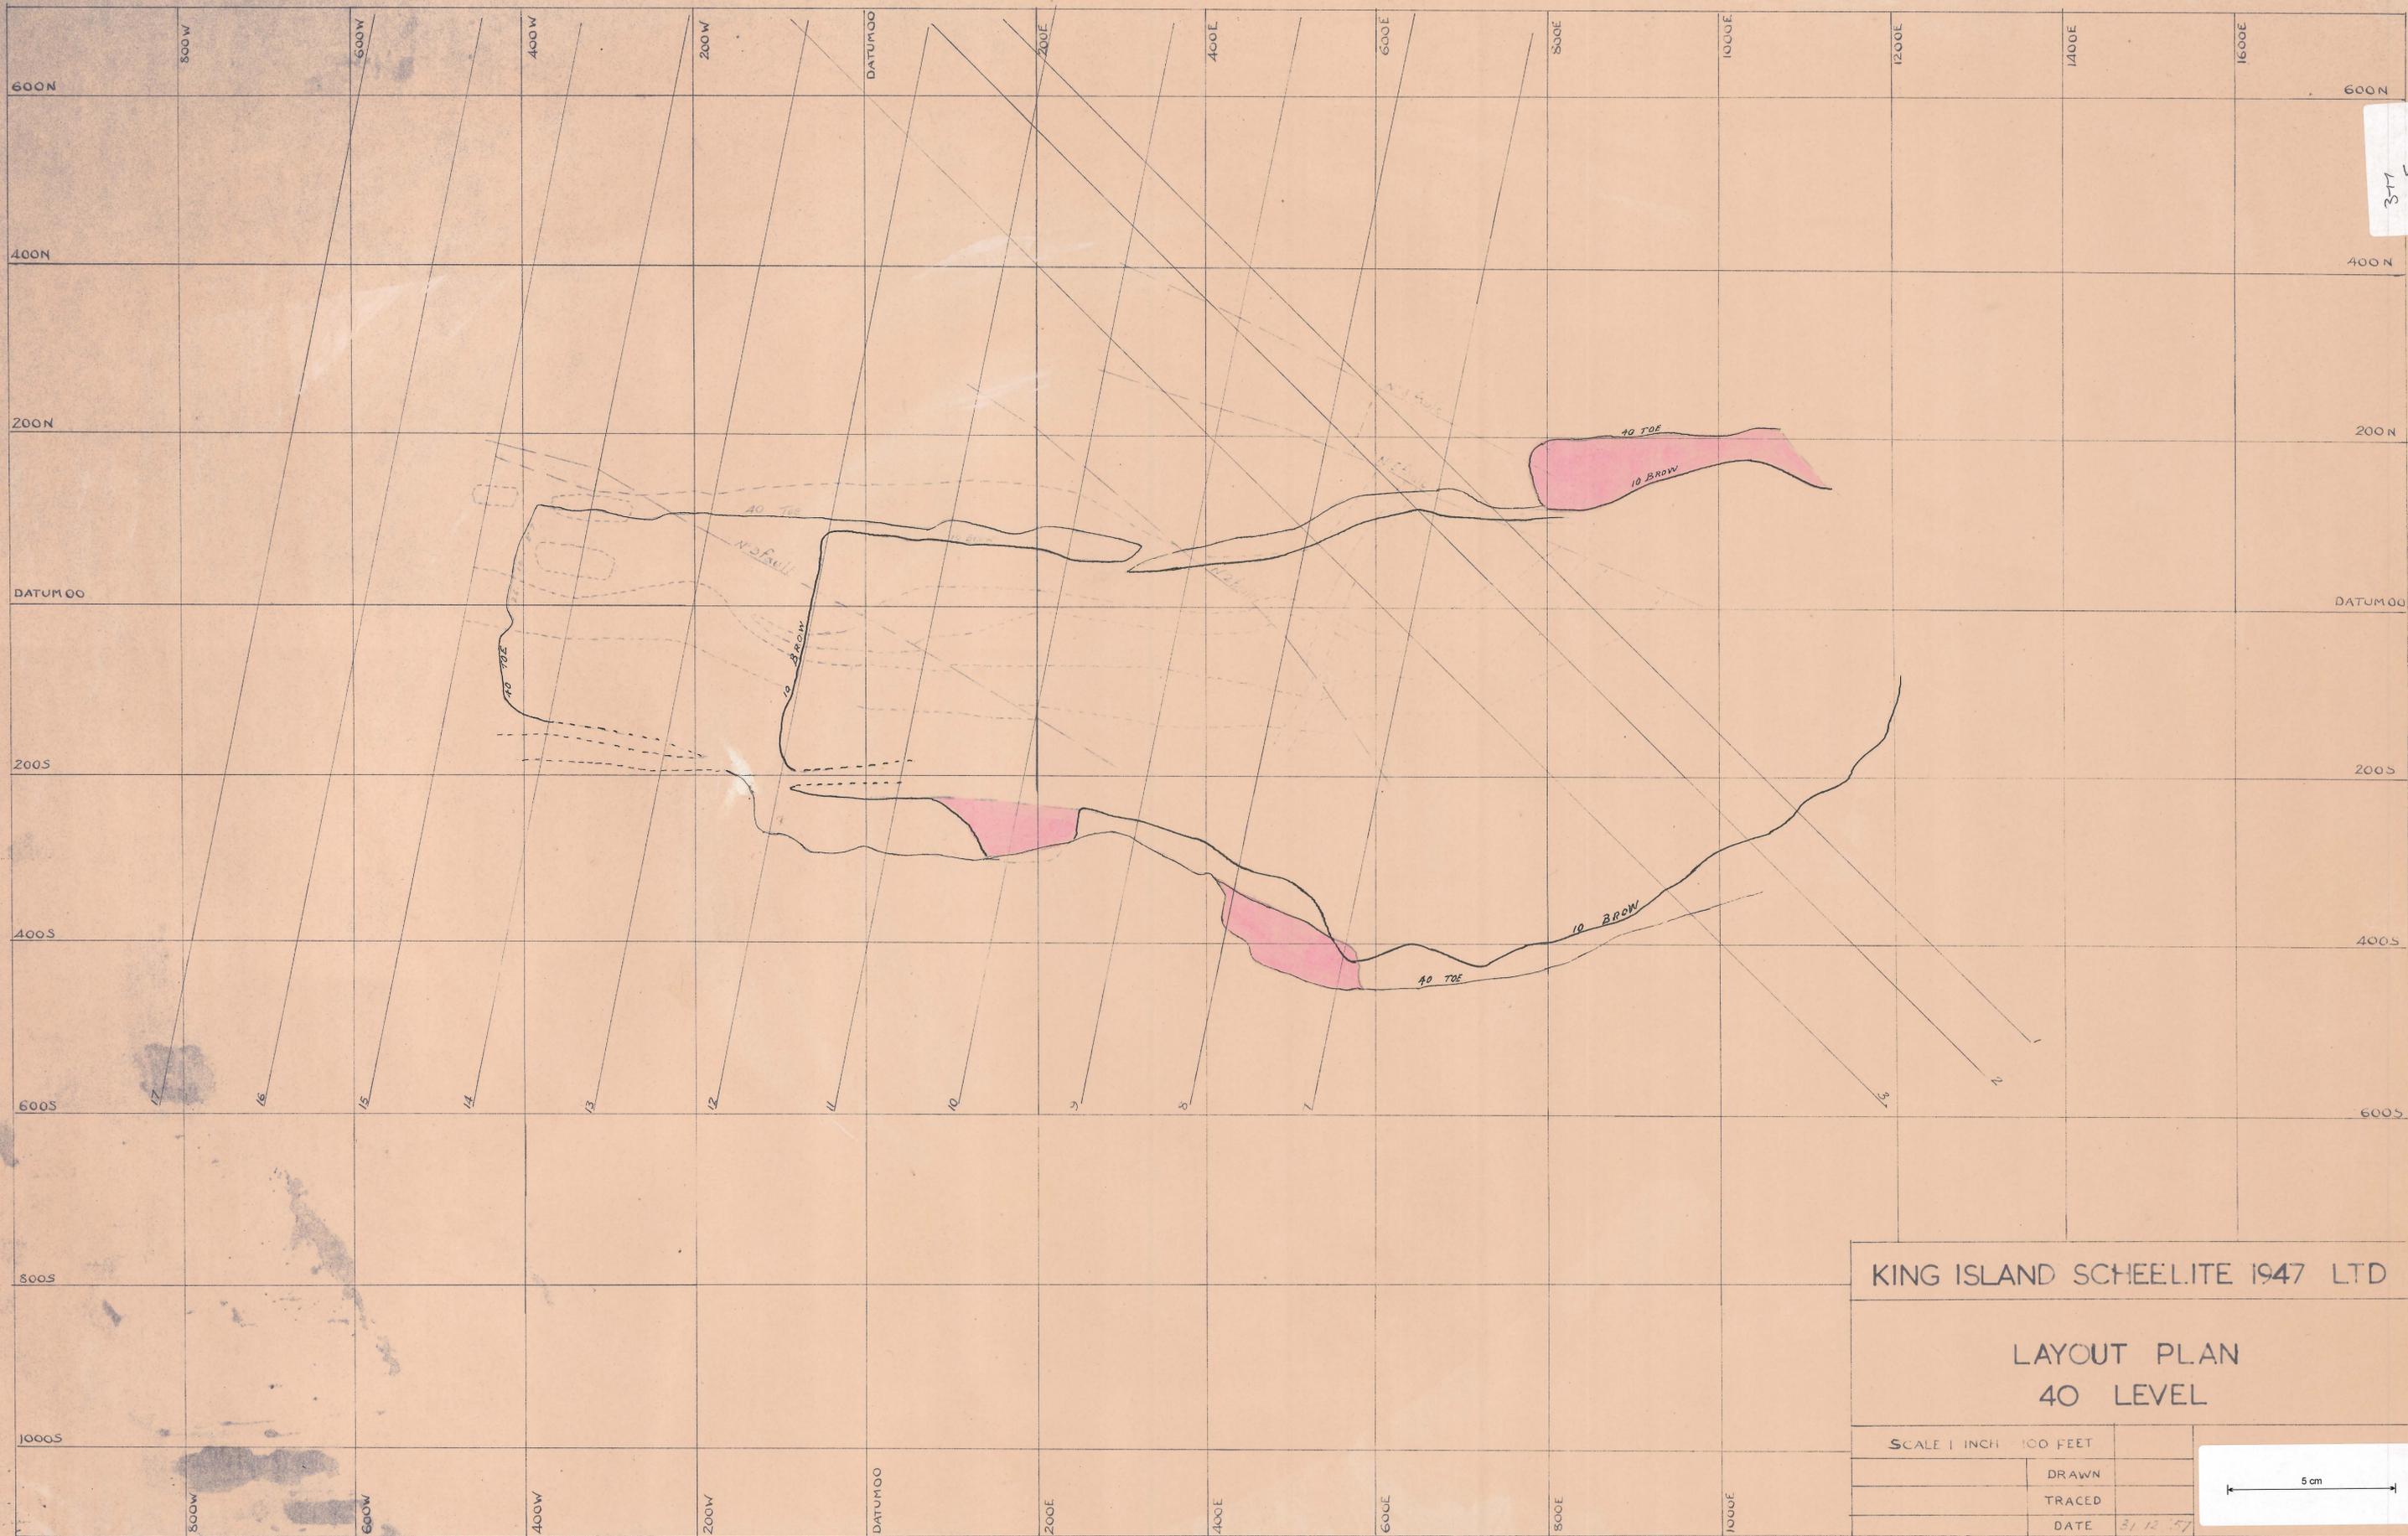

KING ISLAND SCHEELITE 1947 LTD

LAYOUT PLAN
40 LEVEL

SCALE 1 INCH = 100 FEET	
DRAWN	
TRACED	
DATE	3/12/57

5 cm