


311
-87

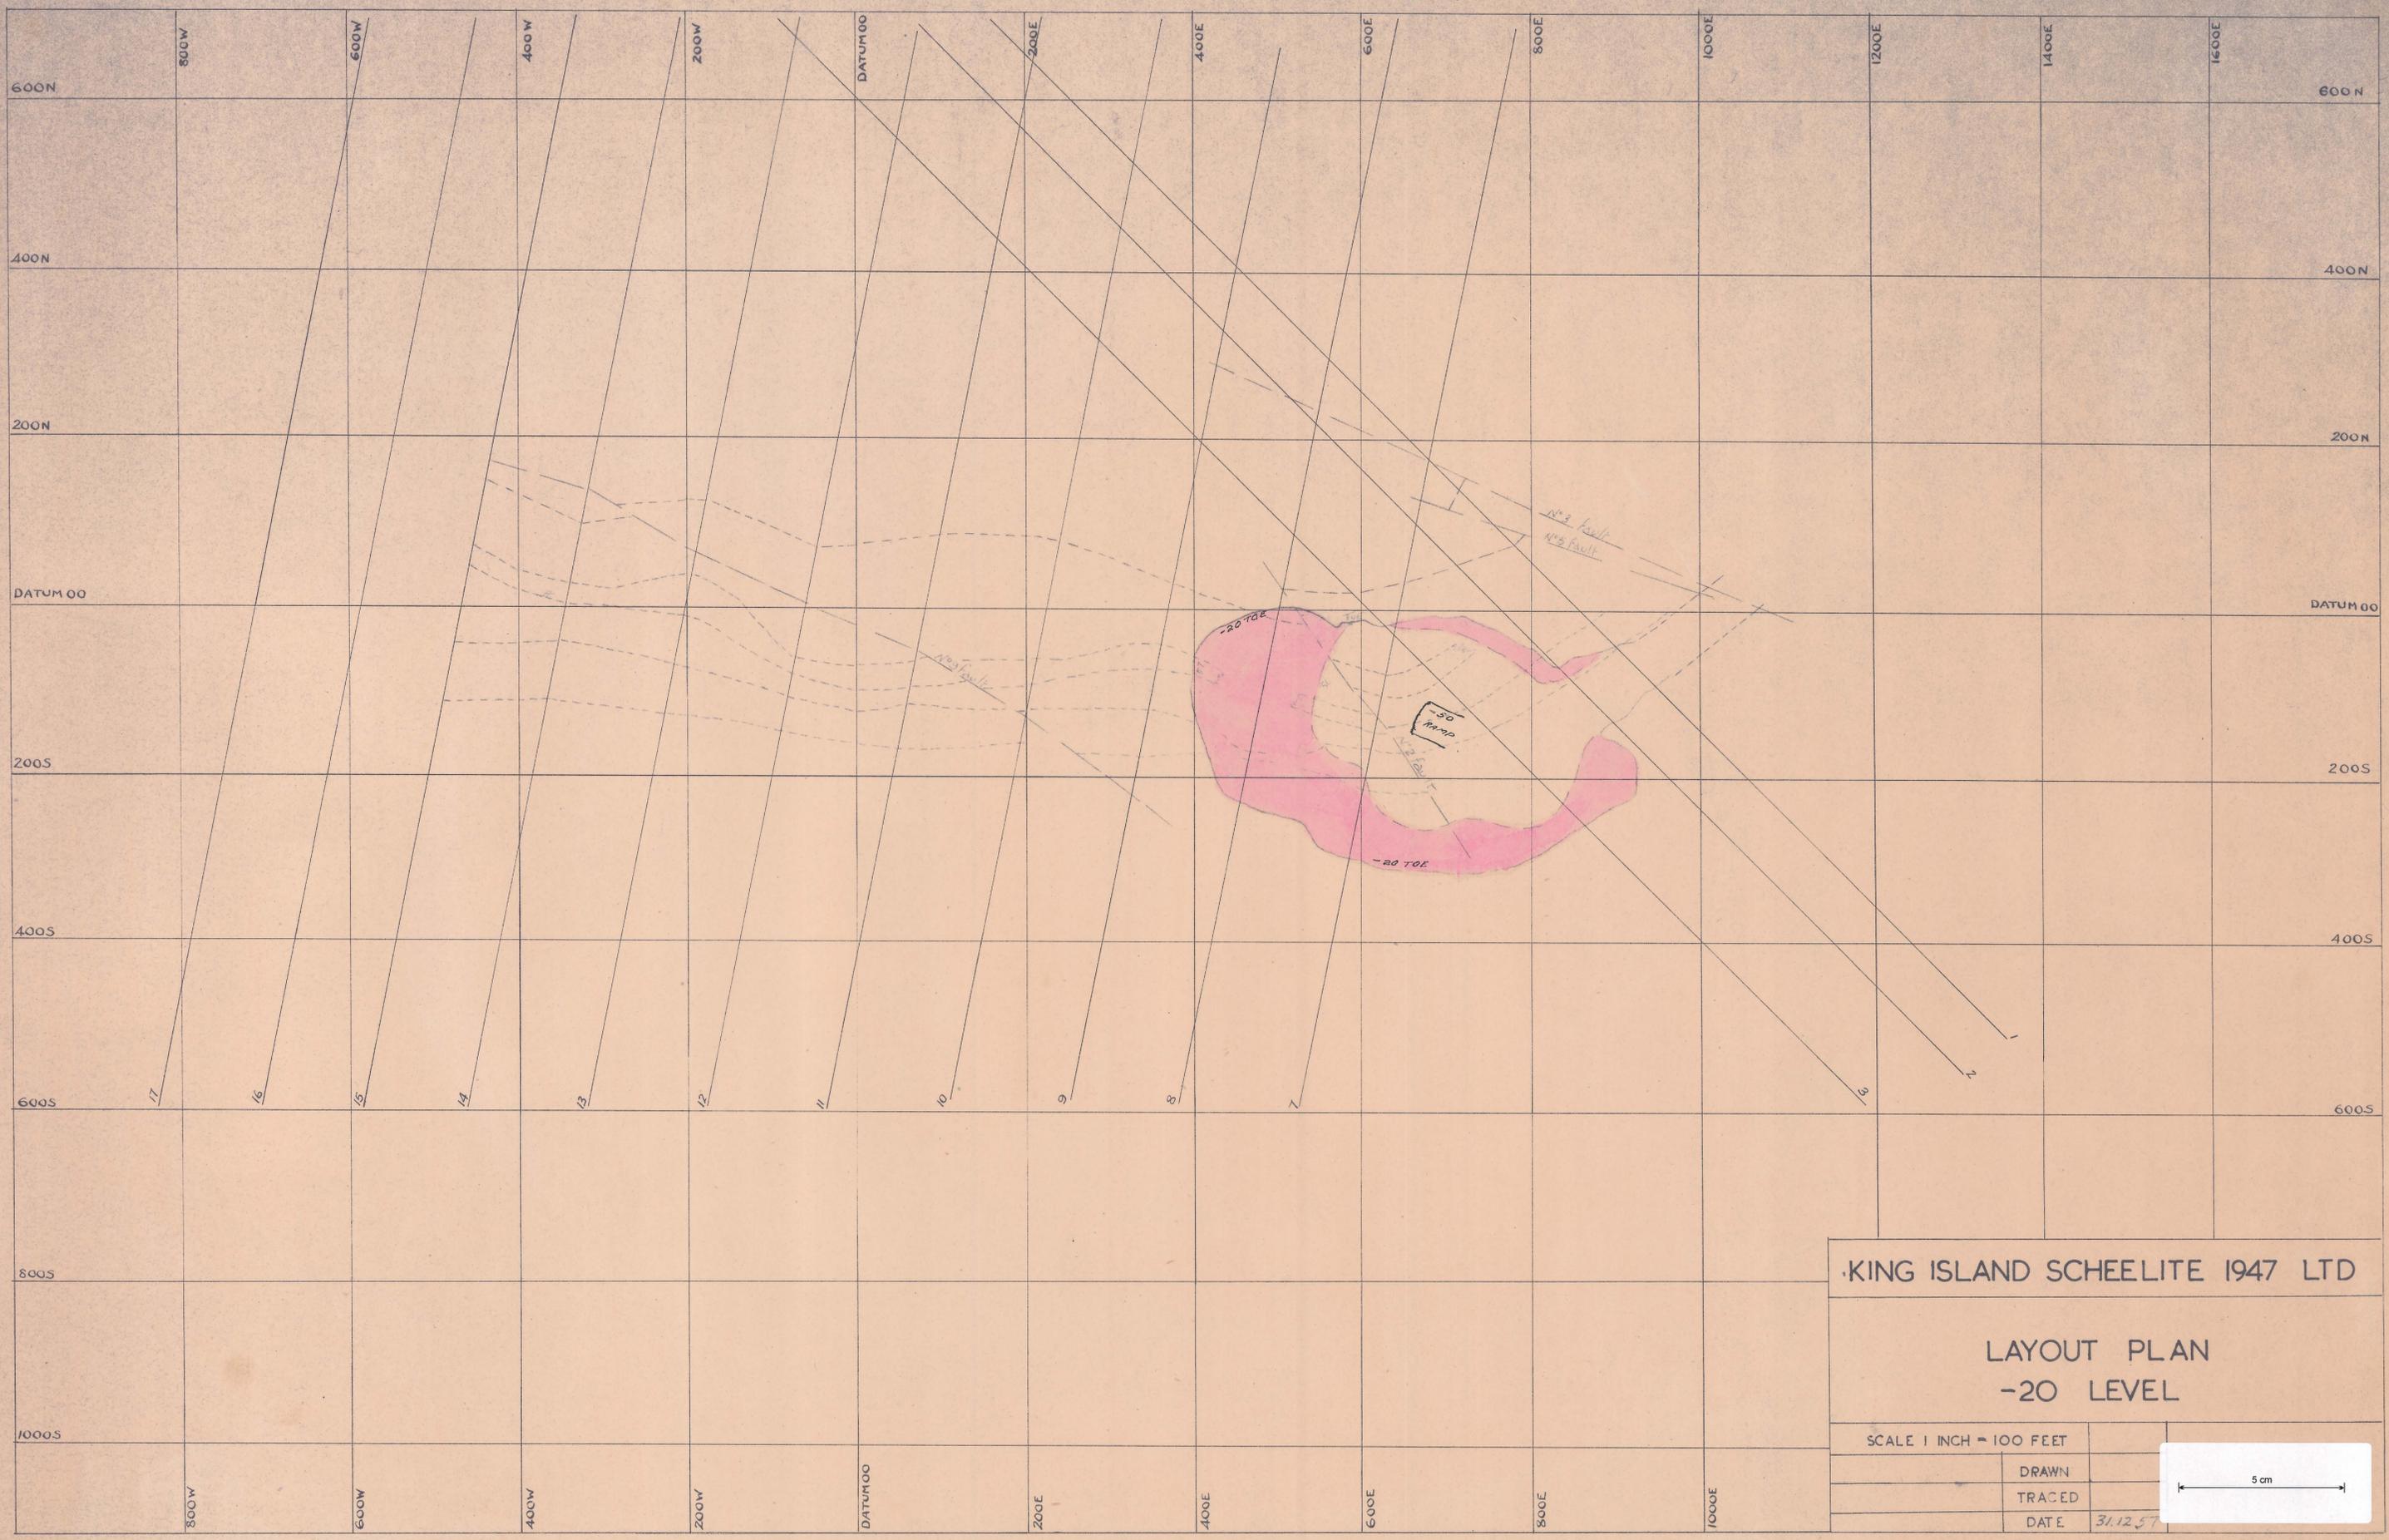

KING ISLAND SCHEELITE 1947 LTD

LAYOUT PLAN
-20 LEVEL

SCALE 1 INCH = 100 FEET

DRAWN	
TRACED	
DATE	31.12.57

5 cm

311
-87