


374
-10

374
-10

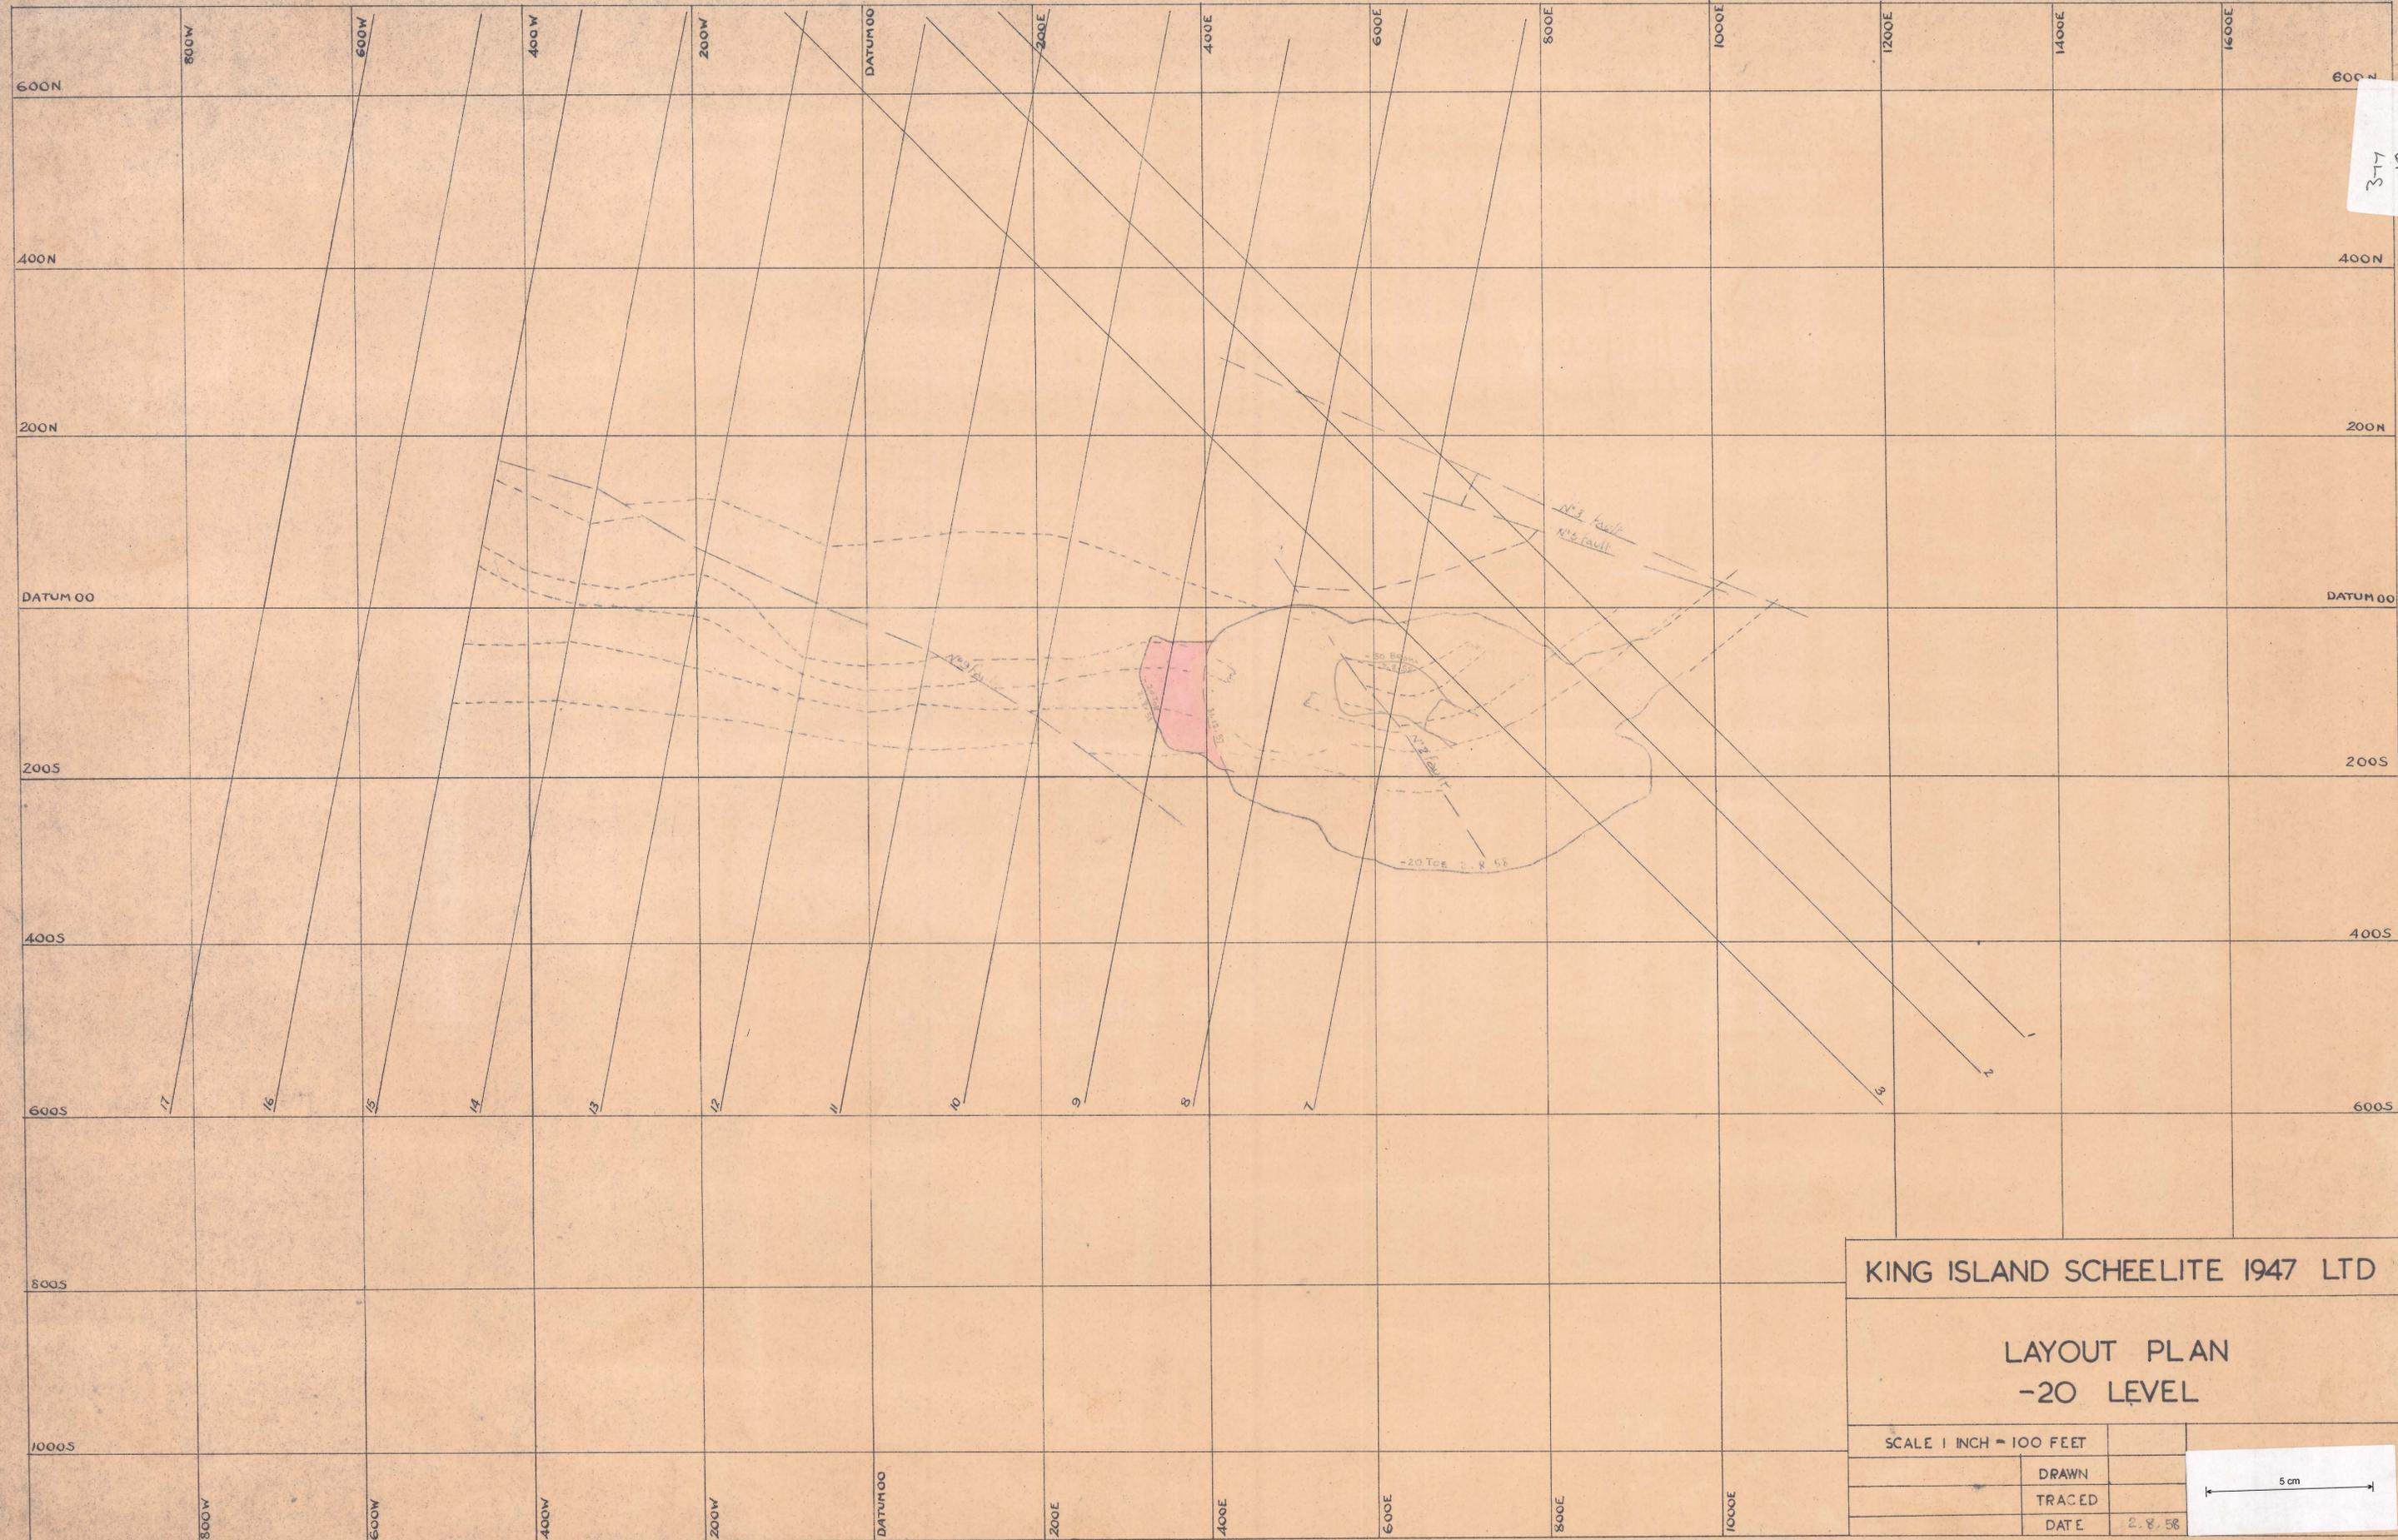

KING ISLAND SCHEELITE 1947 LTD

LAYOUT PLAN
-20 LEVEL

SCALE 1 INCH = 100 FEET	
DRAWN	
TRACED	
DATE	2.8.58

