


317  
-11


317  
-11

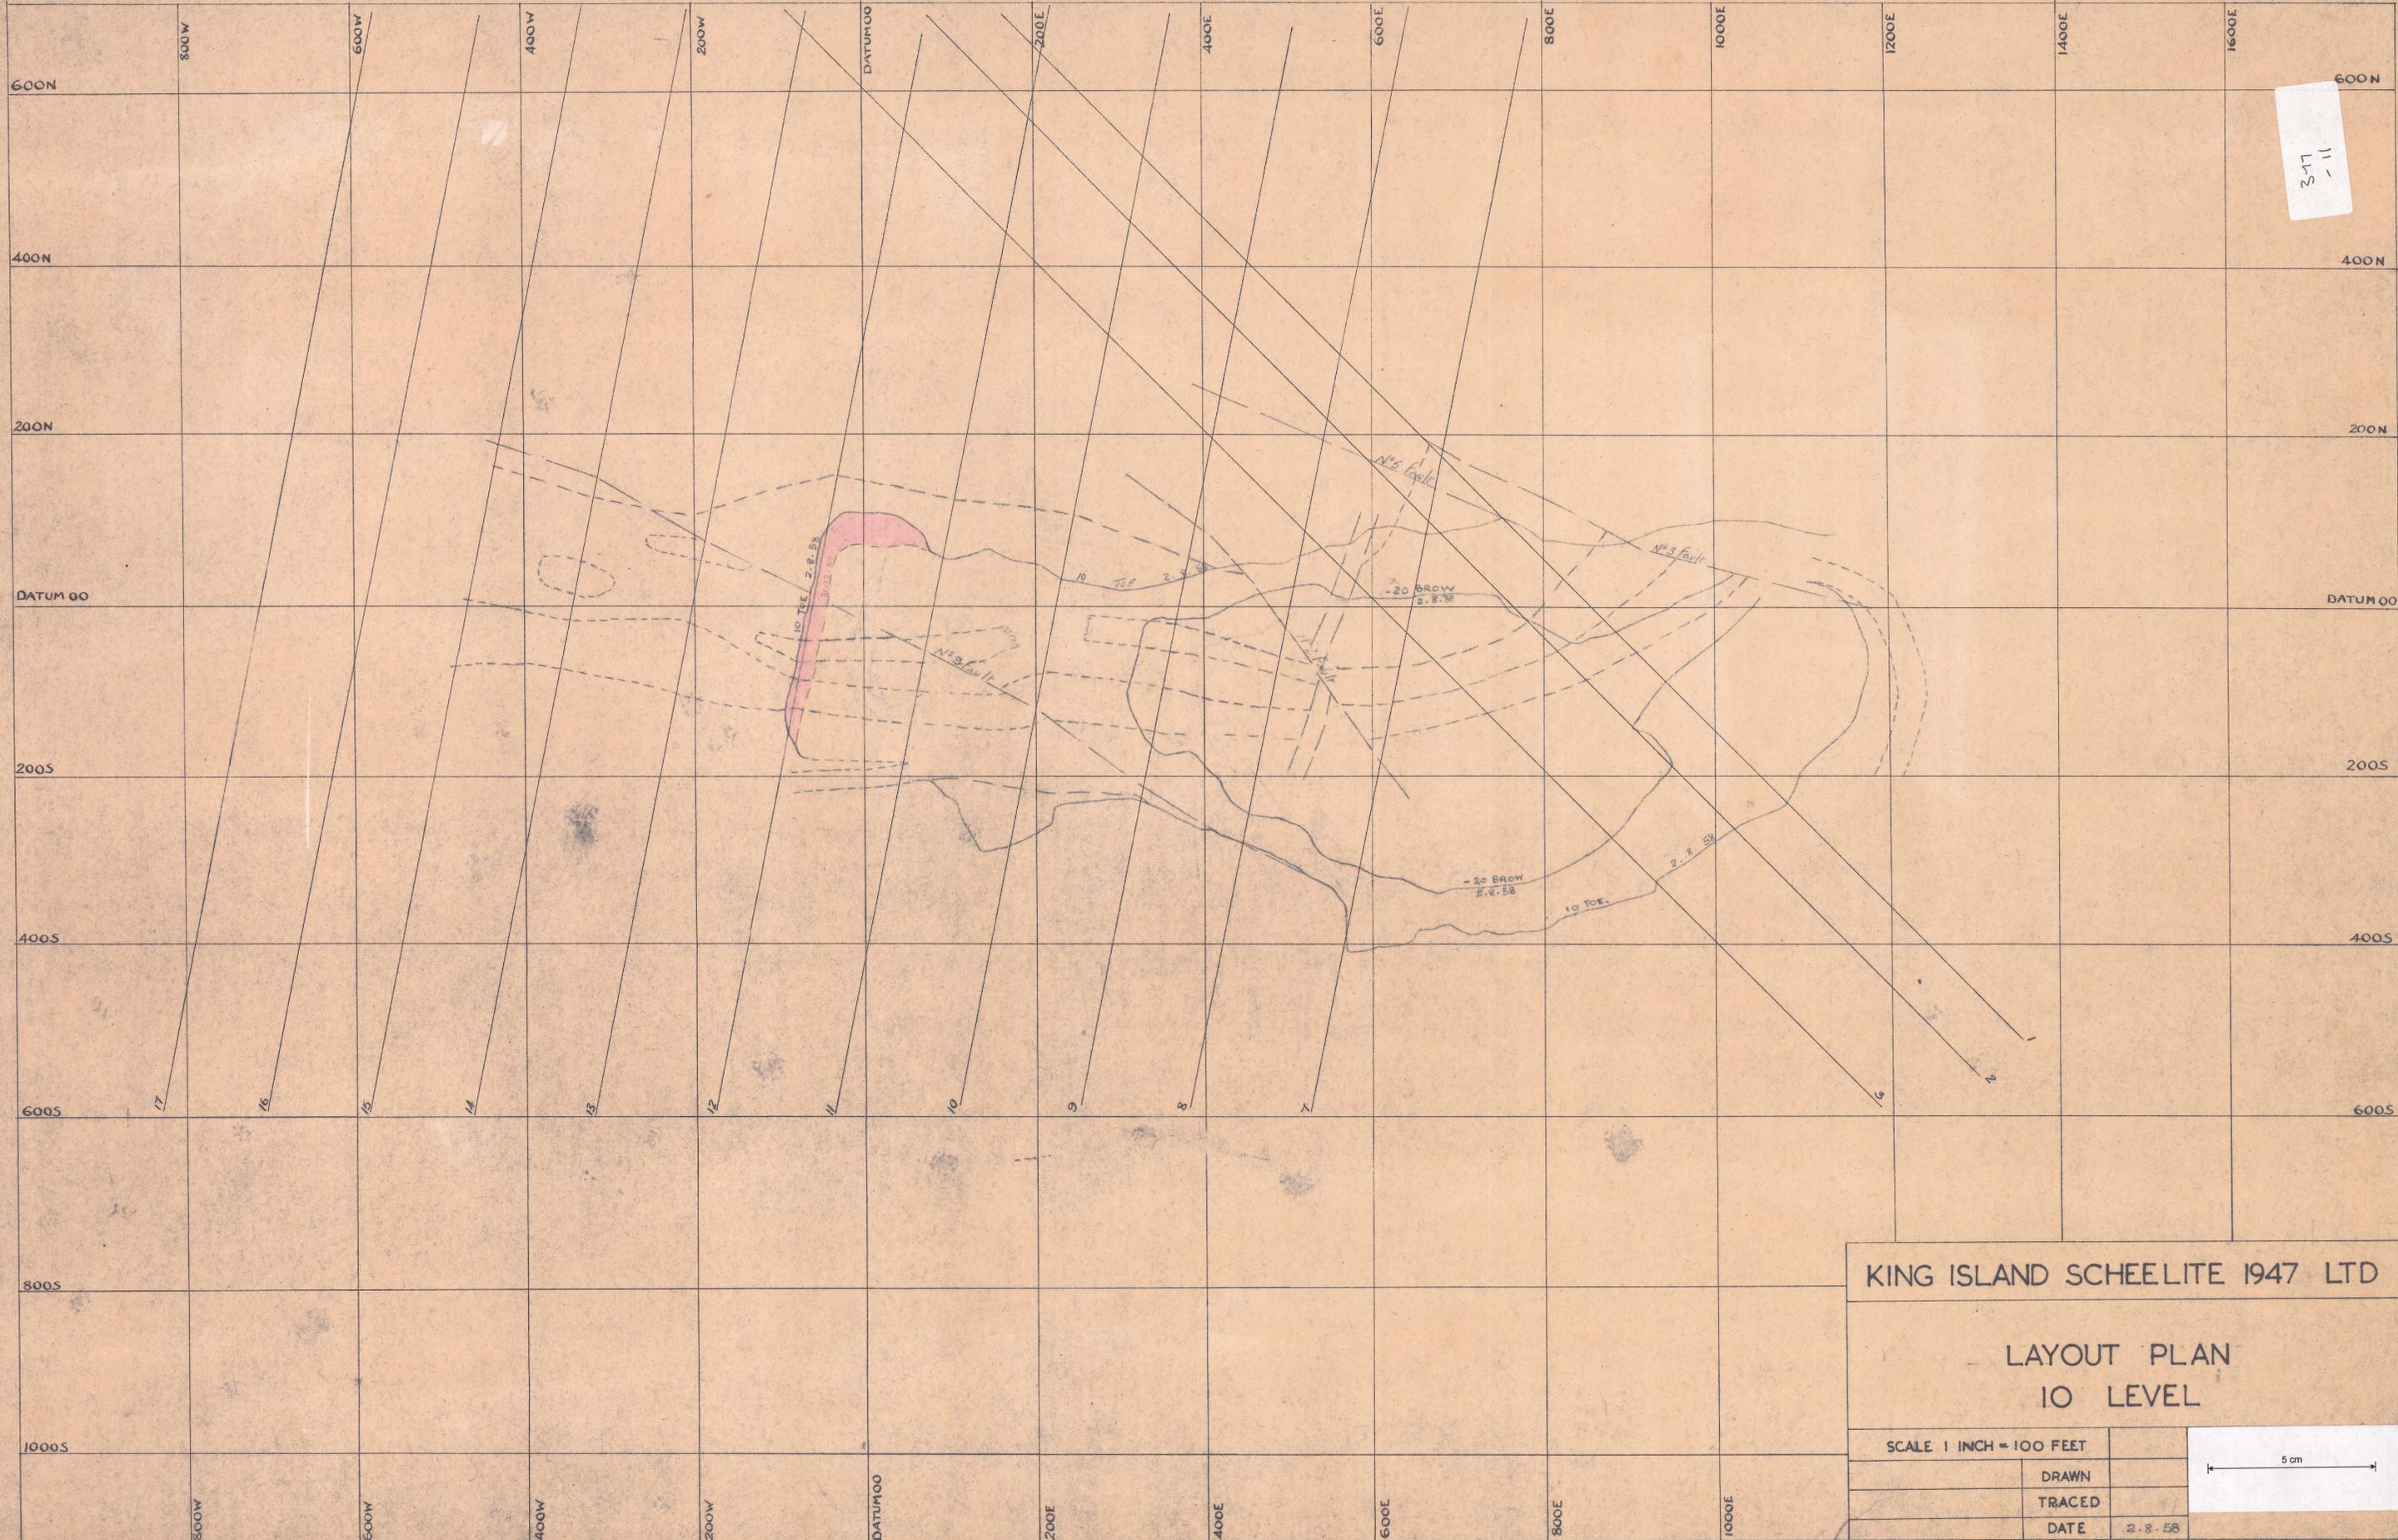

KING ISLAND SCHEELITE 1947 LTD

LAYOUT PLAN  
10 LEVEL

SCALE 1 INCH = 100 FEET

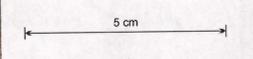

DRAWN

TRACED

DATE

2.8.58