


21-418

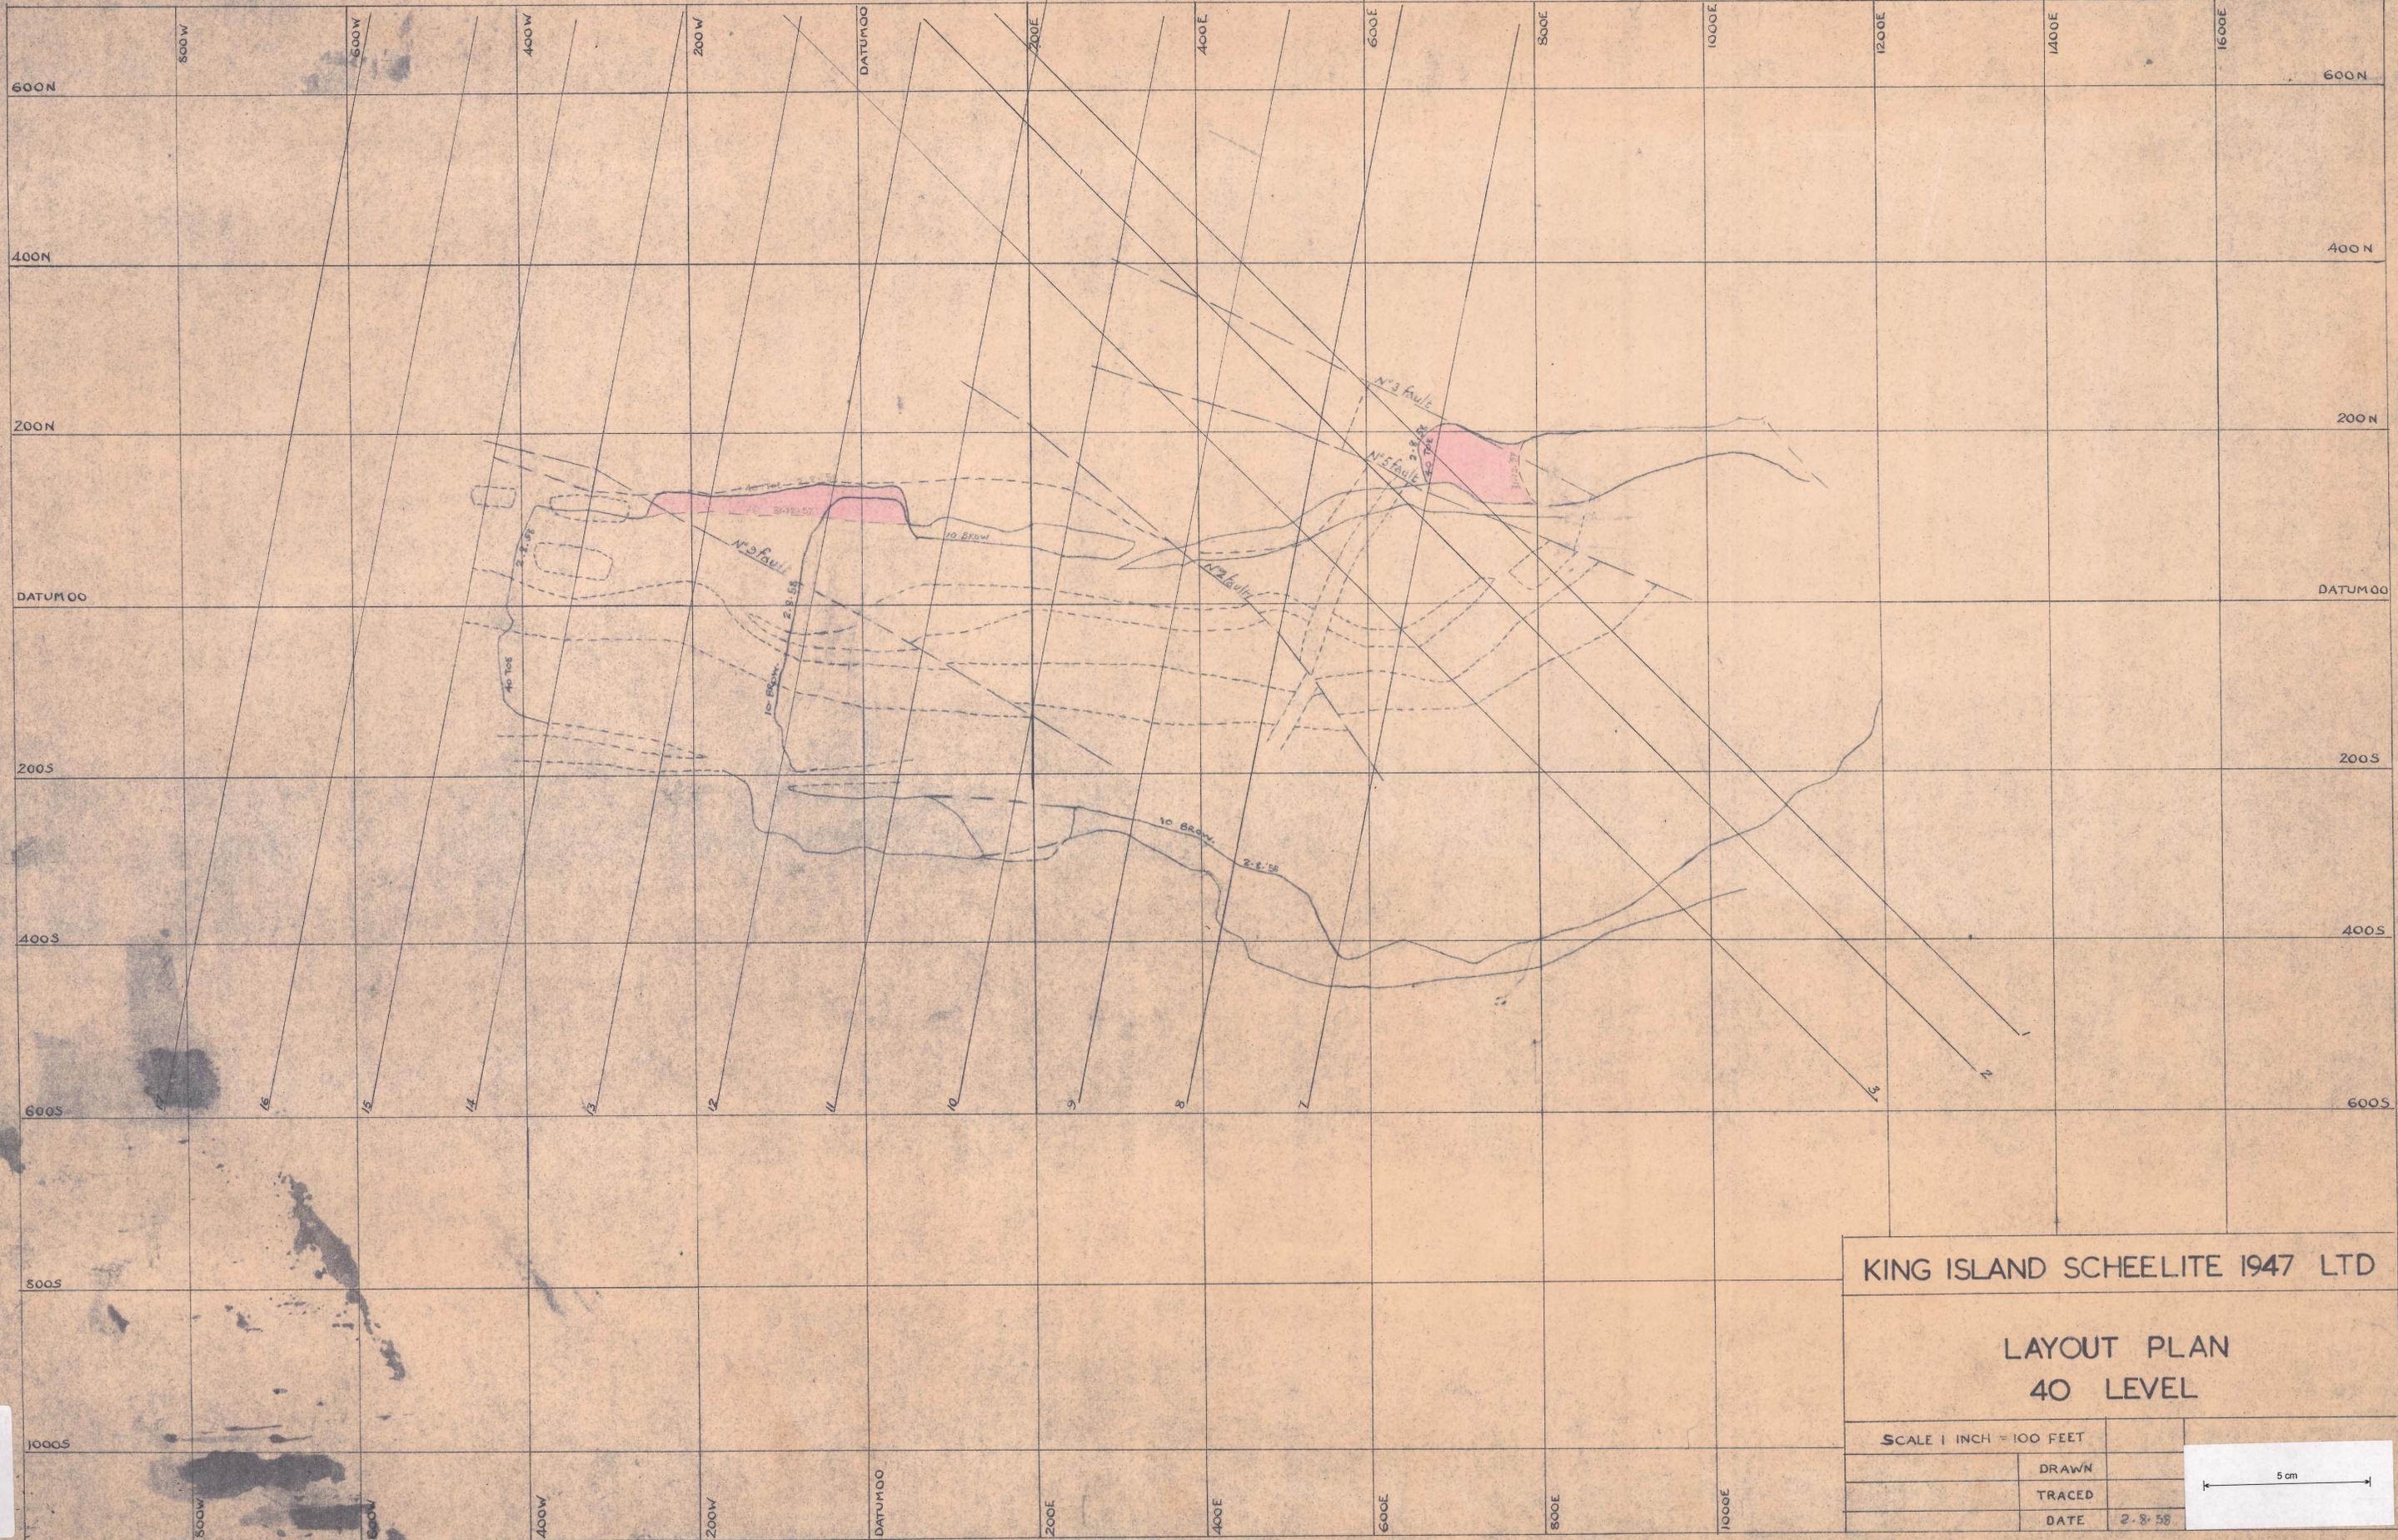


KING ISLAND SCHEELITE 1947 LTD

LAYOUT PLAN
40 LEVEL

SCALE 1 INCH = 100 FEET

DRAWN	
TRACED	
DATE	2-8-58

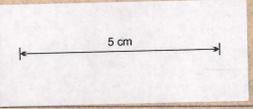

21-418