


377  
- 89

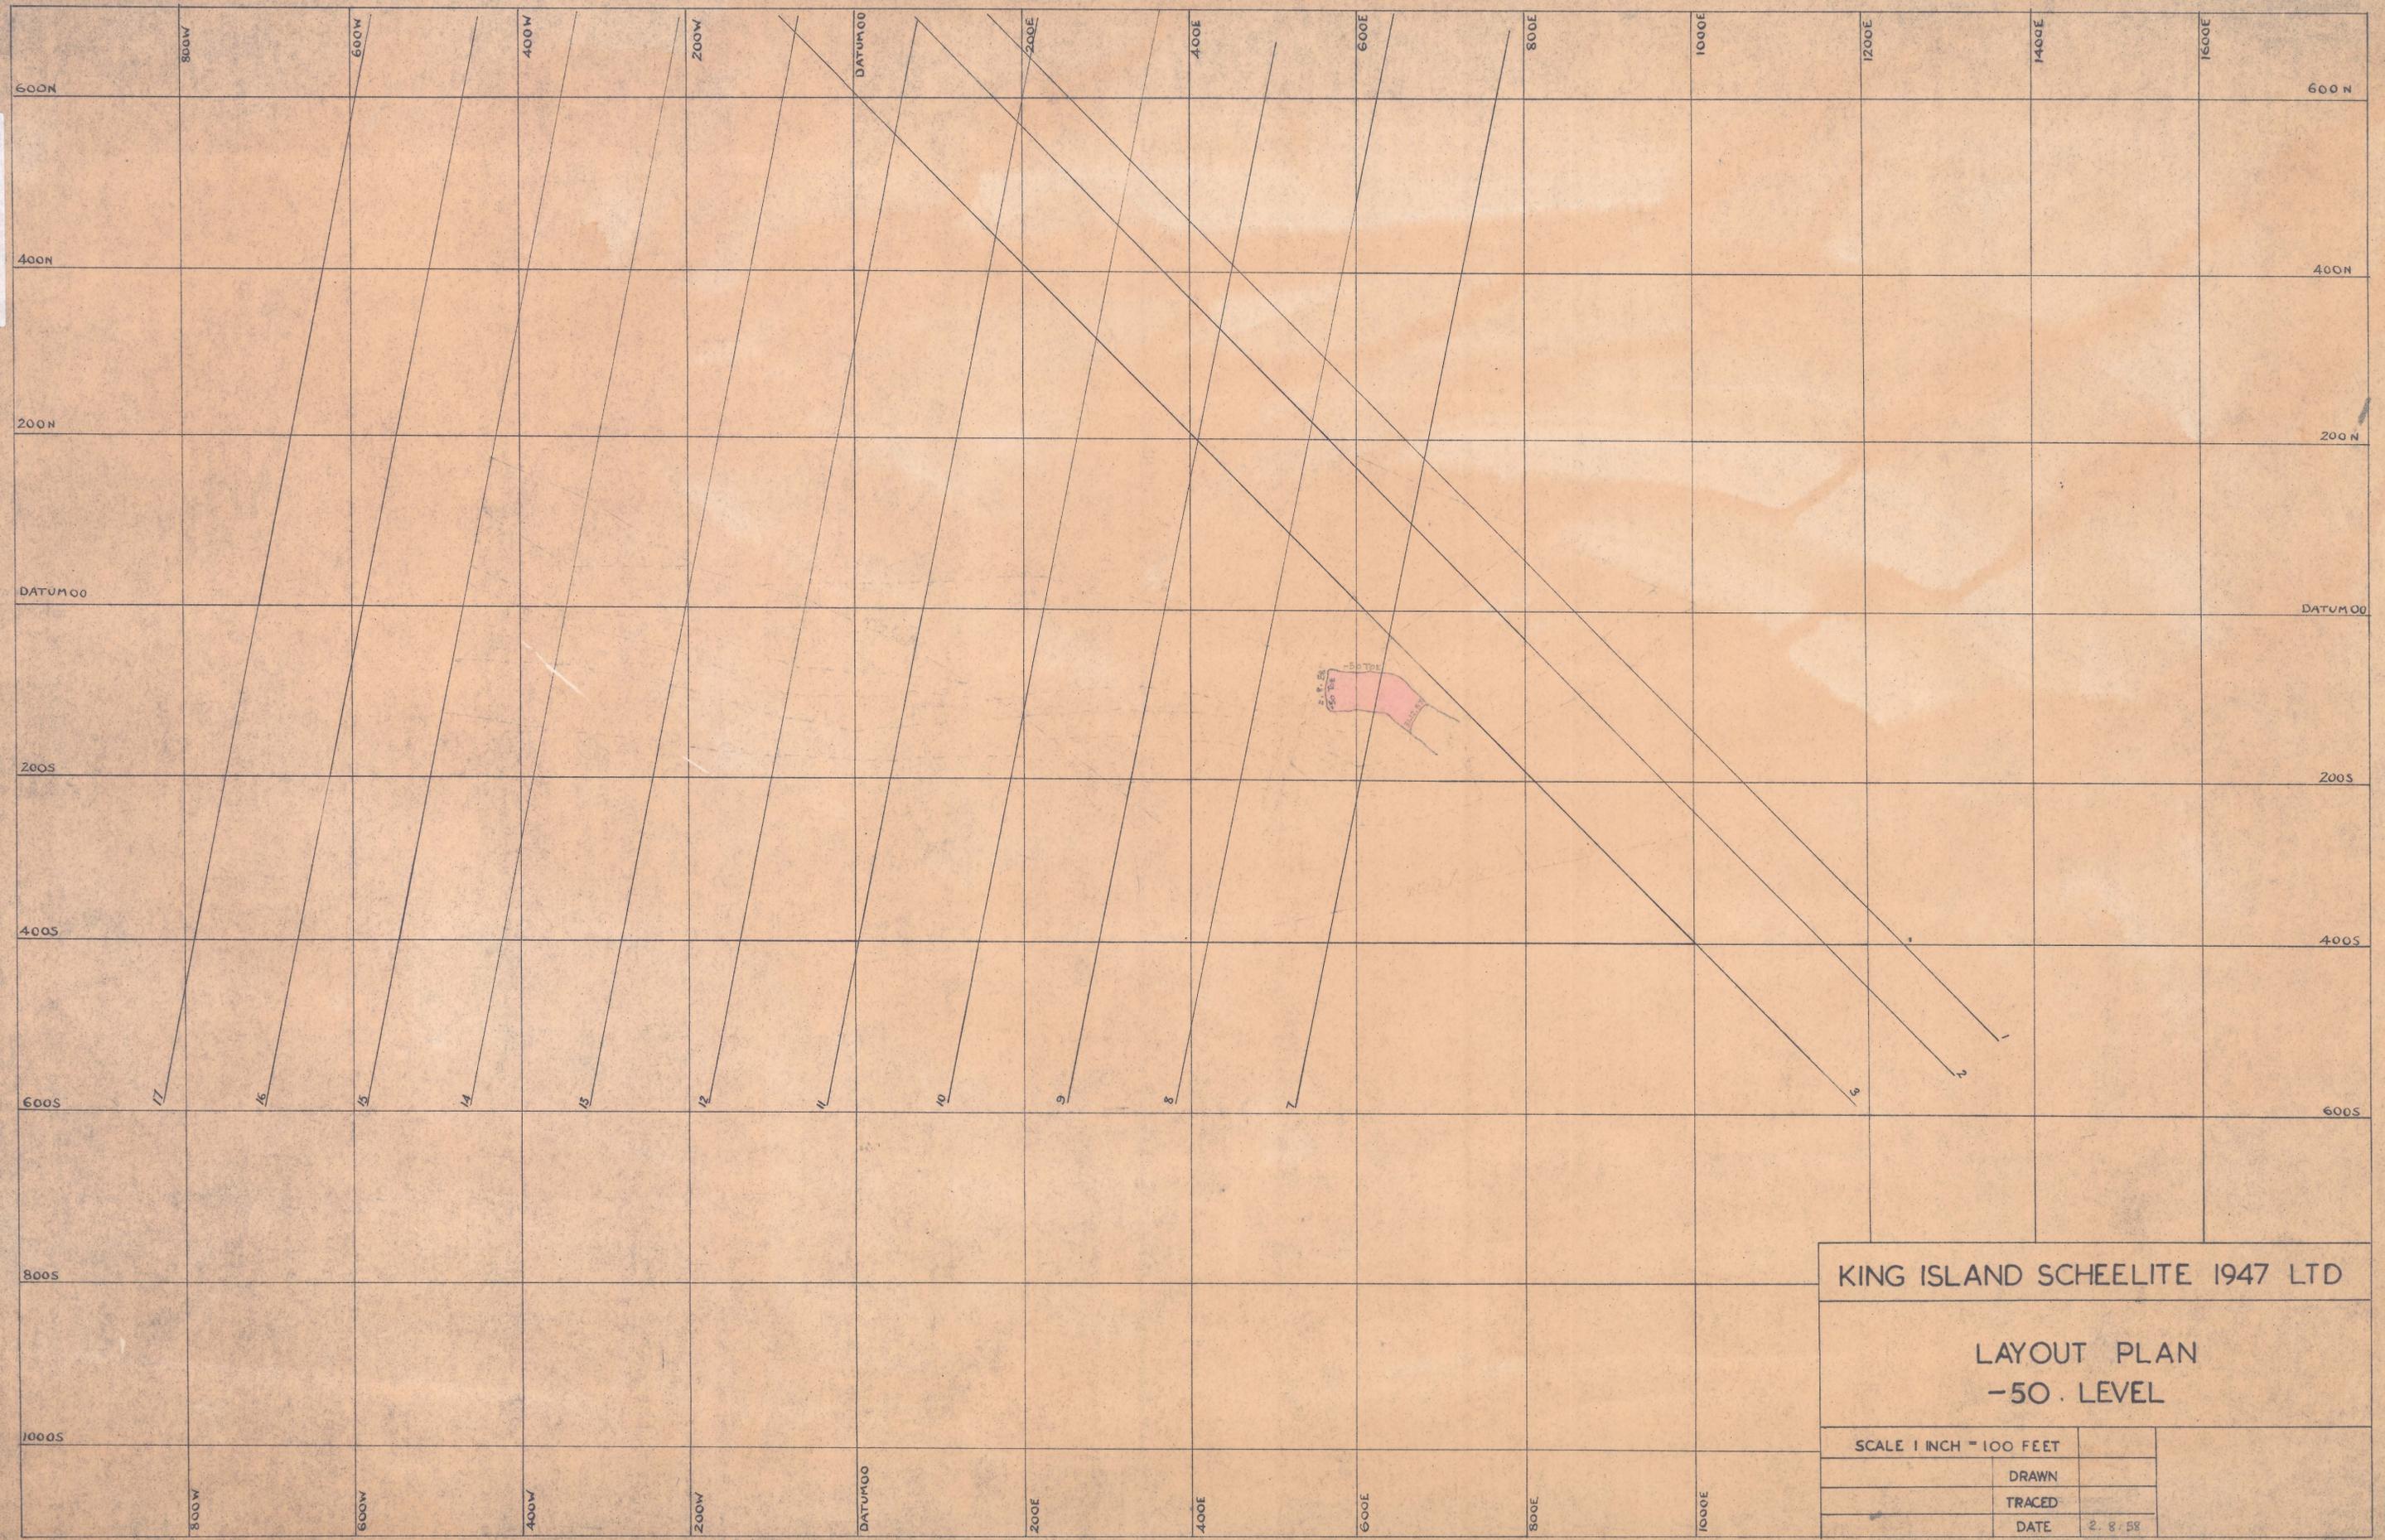

KING ISLAND SCHEELITE 1947 LTD	
LAYOUT PLAN -50 . LEVEL	
SCALE 1 INCH = 100 FEET	
DRAWN	
TRACED	
DATE	2. 8. 58