


3-12-34

3-12-34

5 cm

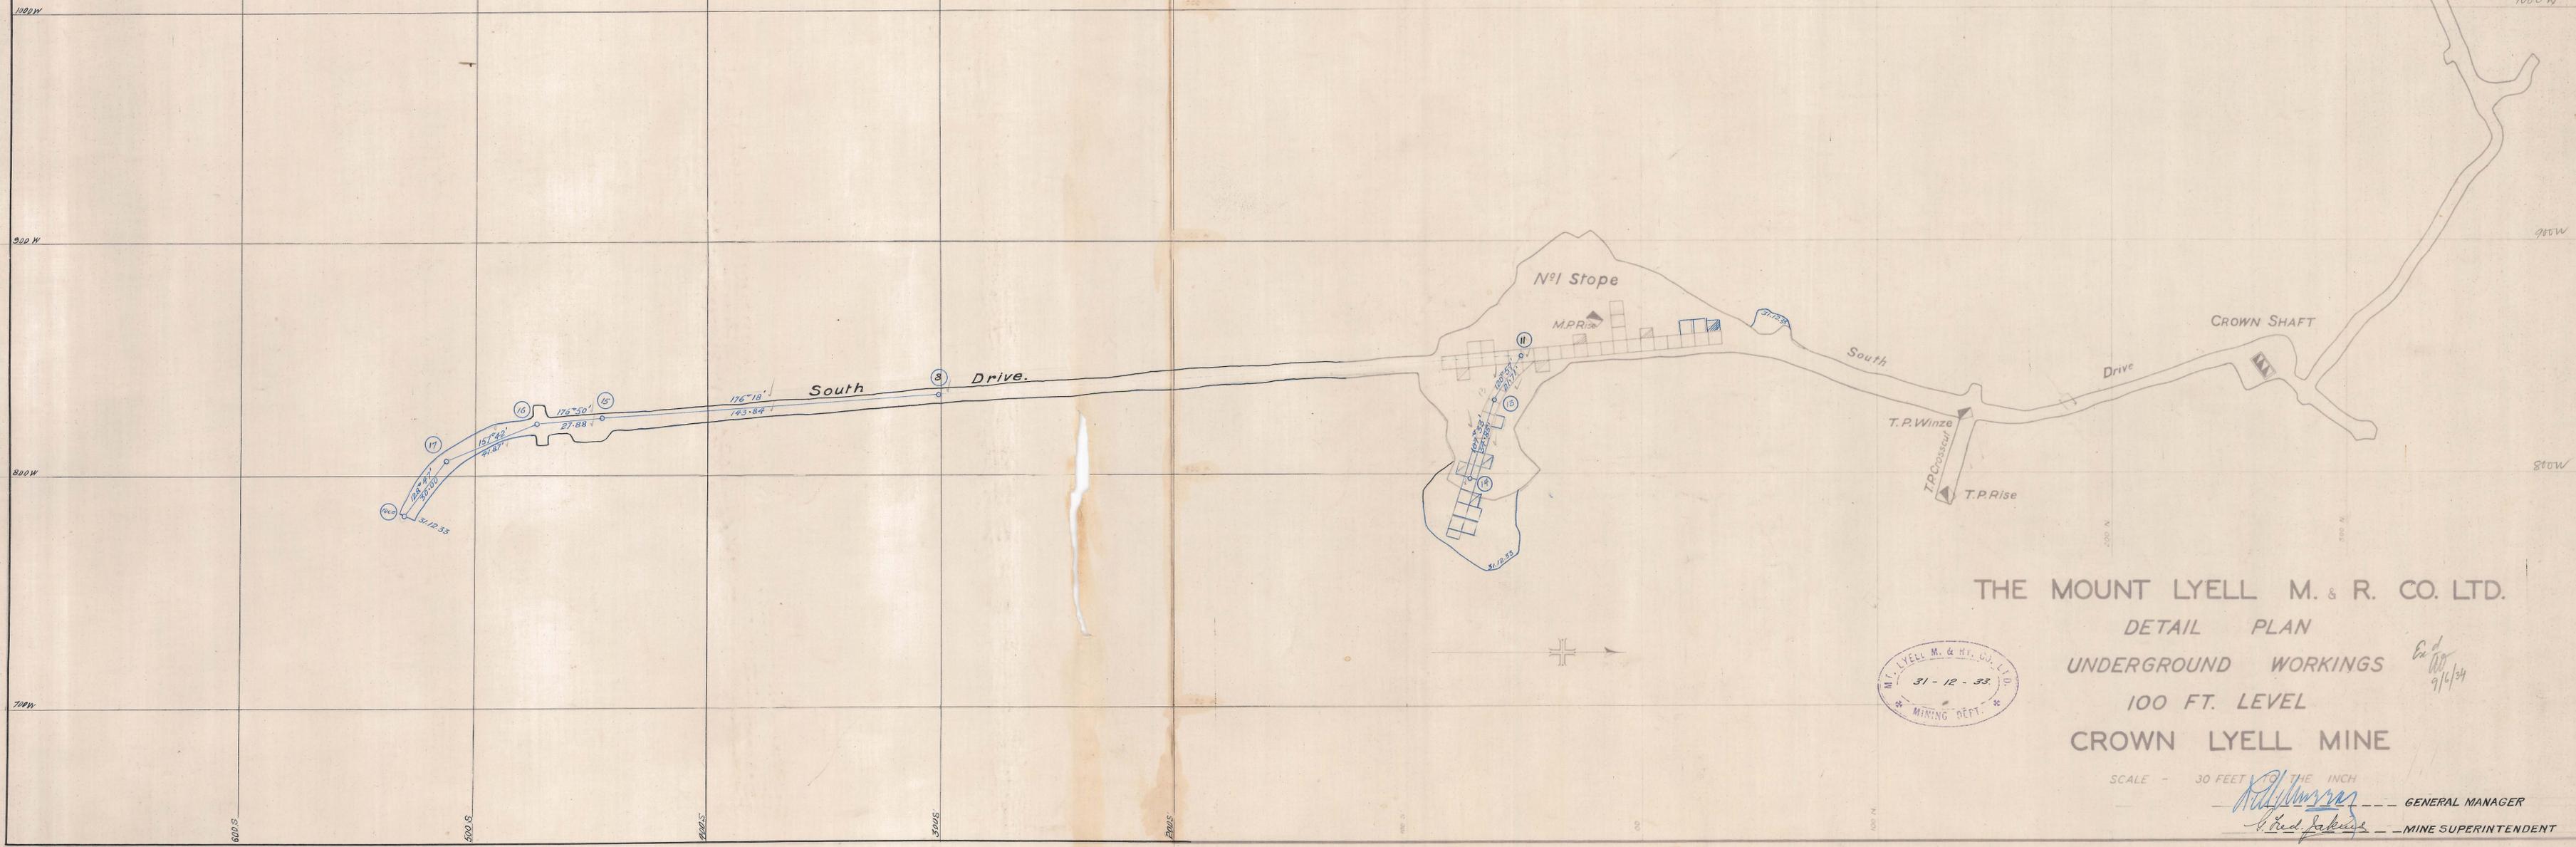

THE MOUNT LYELL M. & R. CO. LTD.  
 DETAIL PLAN  
 UNDERGROUND WORKINGS  
 100 FT. LEVEL  
 CROWN LYELL MINE



SCALE - 30 FEET TO THE INCH

*W. J. Murray* GENERAL MANAGER  
*W. J. Murray* MINE SUPERINTENDENT

*Ed. [unclear]*  
 9/16/34