


20-8-5

378  
- 02

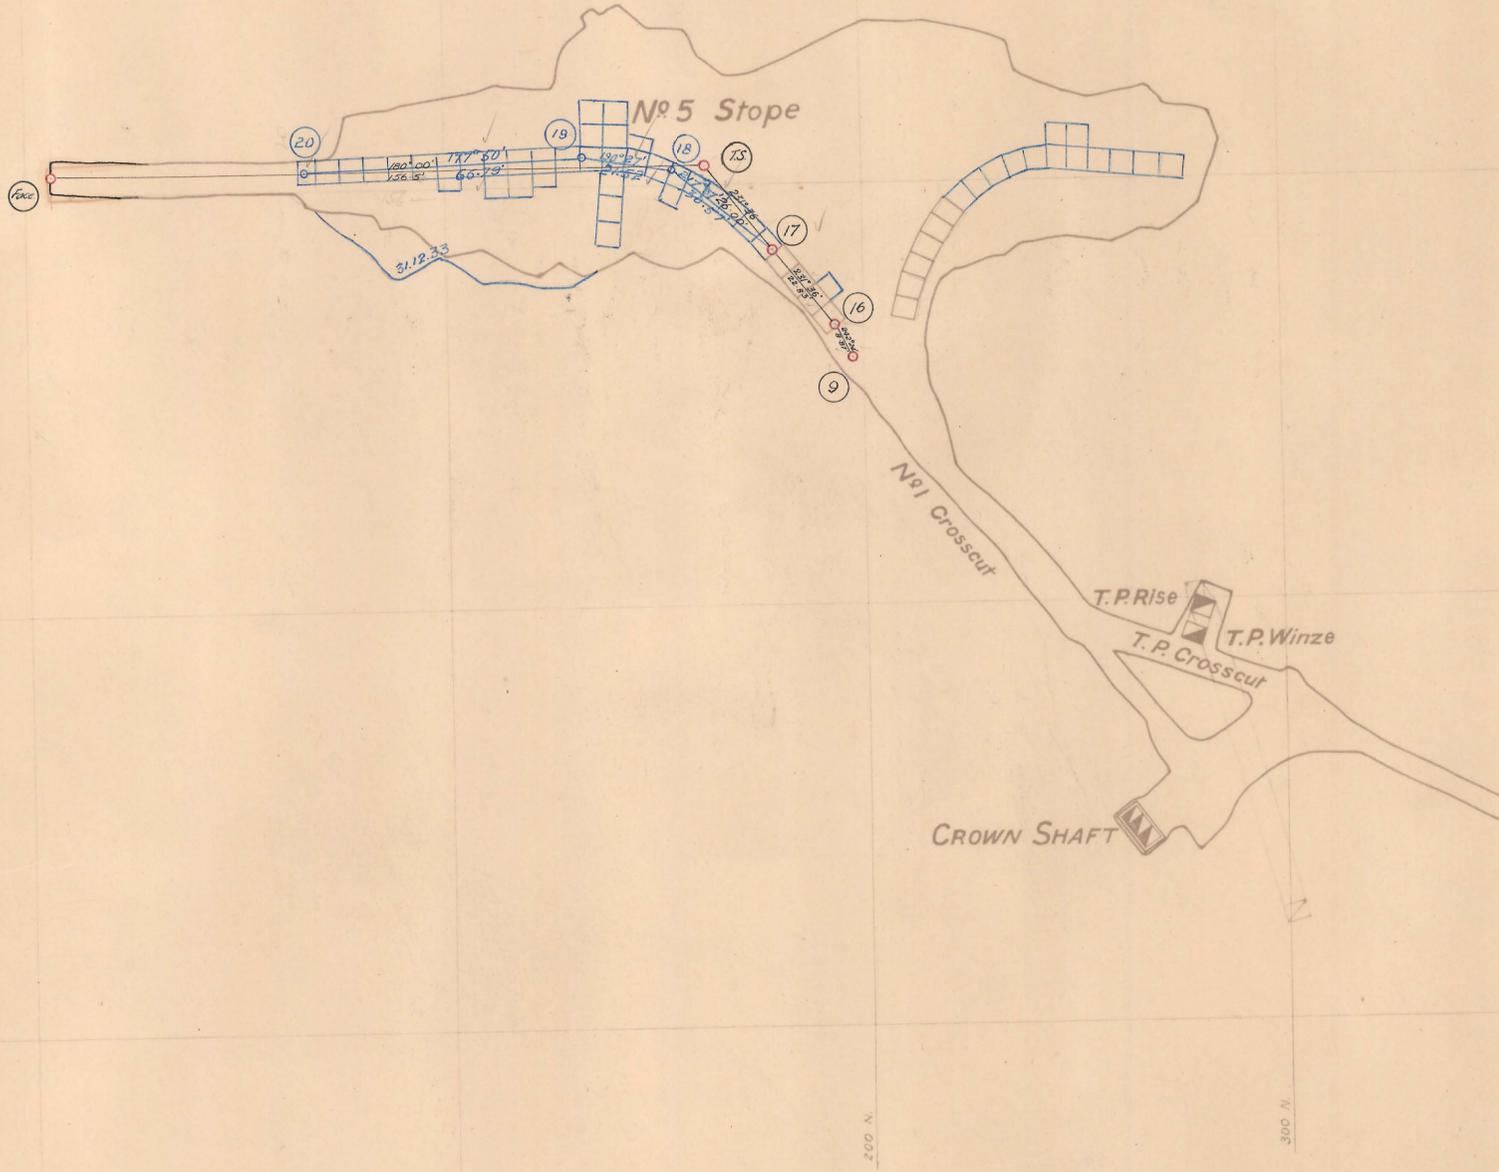

THE MOUNT LYELL M. & R. CO. LTD.

DETAIL PLAN

UNDERGROUND WORKINGS


500 FT. LEVEL

CROWN LYELL MINE



SCALE - 30 FEET TO THE INCH

*R. Williams* GENERAL MANAGER.  
*G. Red. Jakins* MINE SUPERINTENDENT.

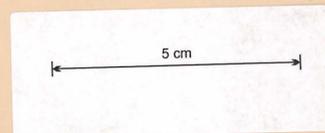

*Cal*  
*31-12-33*  
*007/1/34*