


3-18  
-04

3-18  
-04

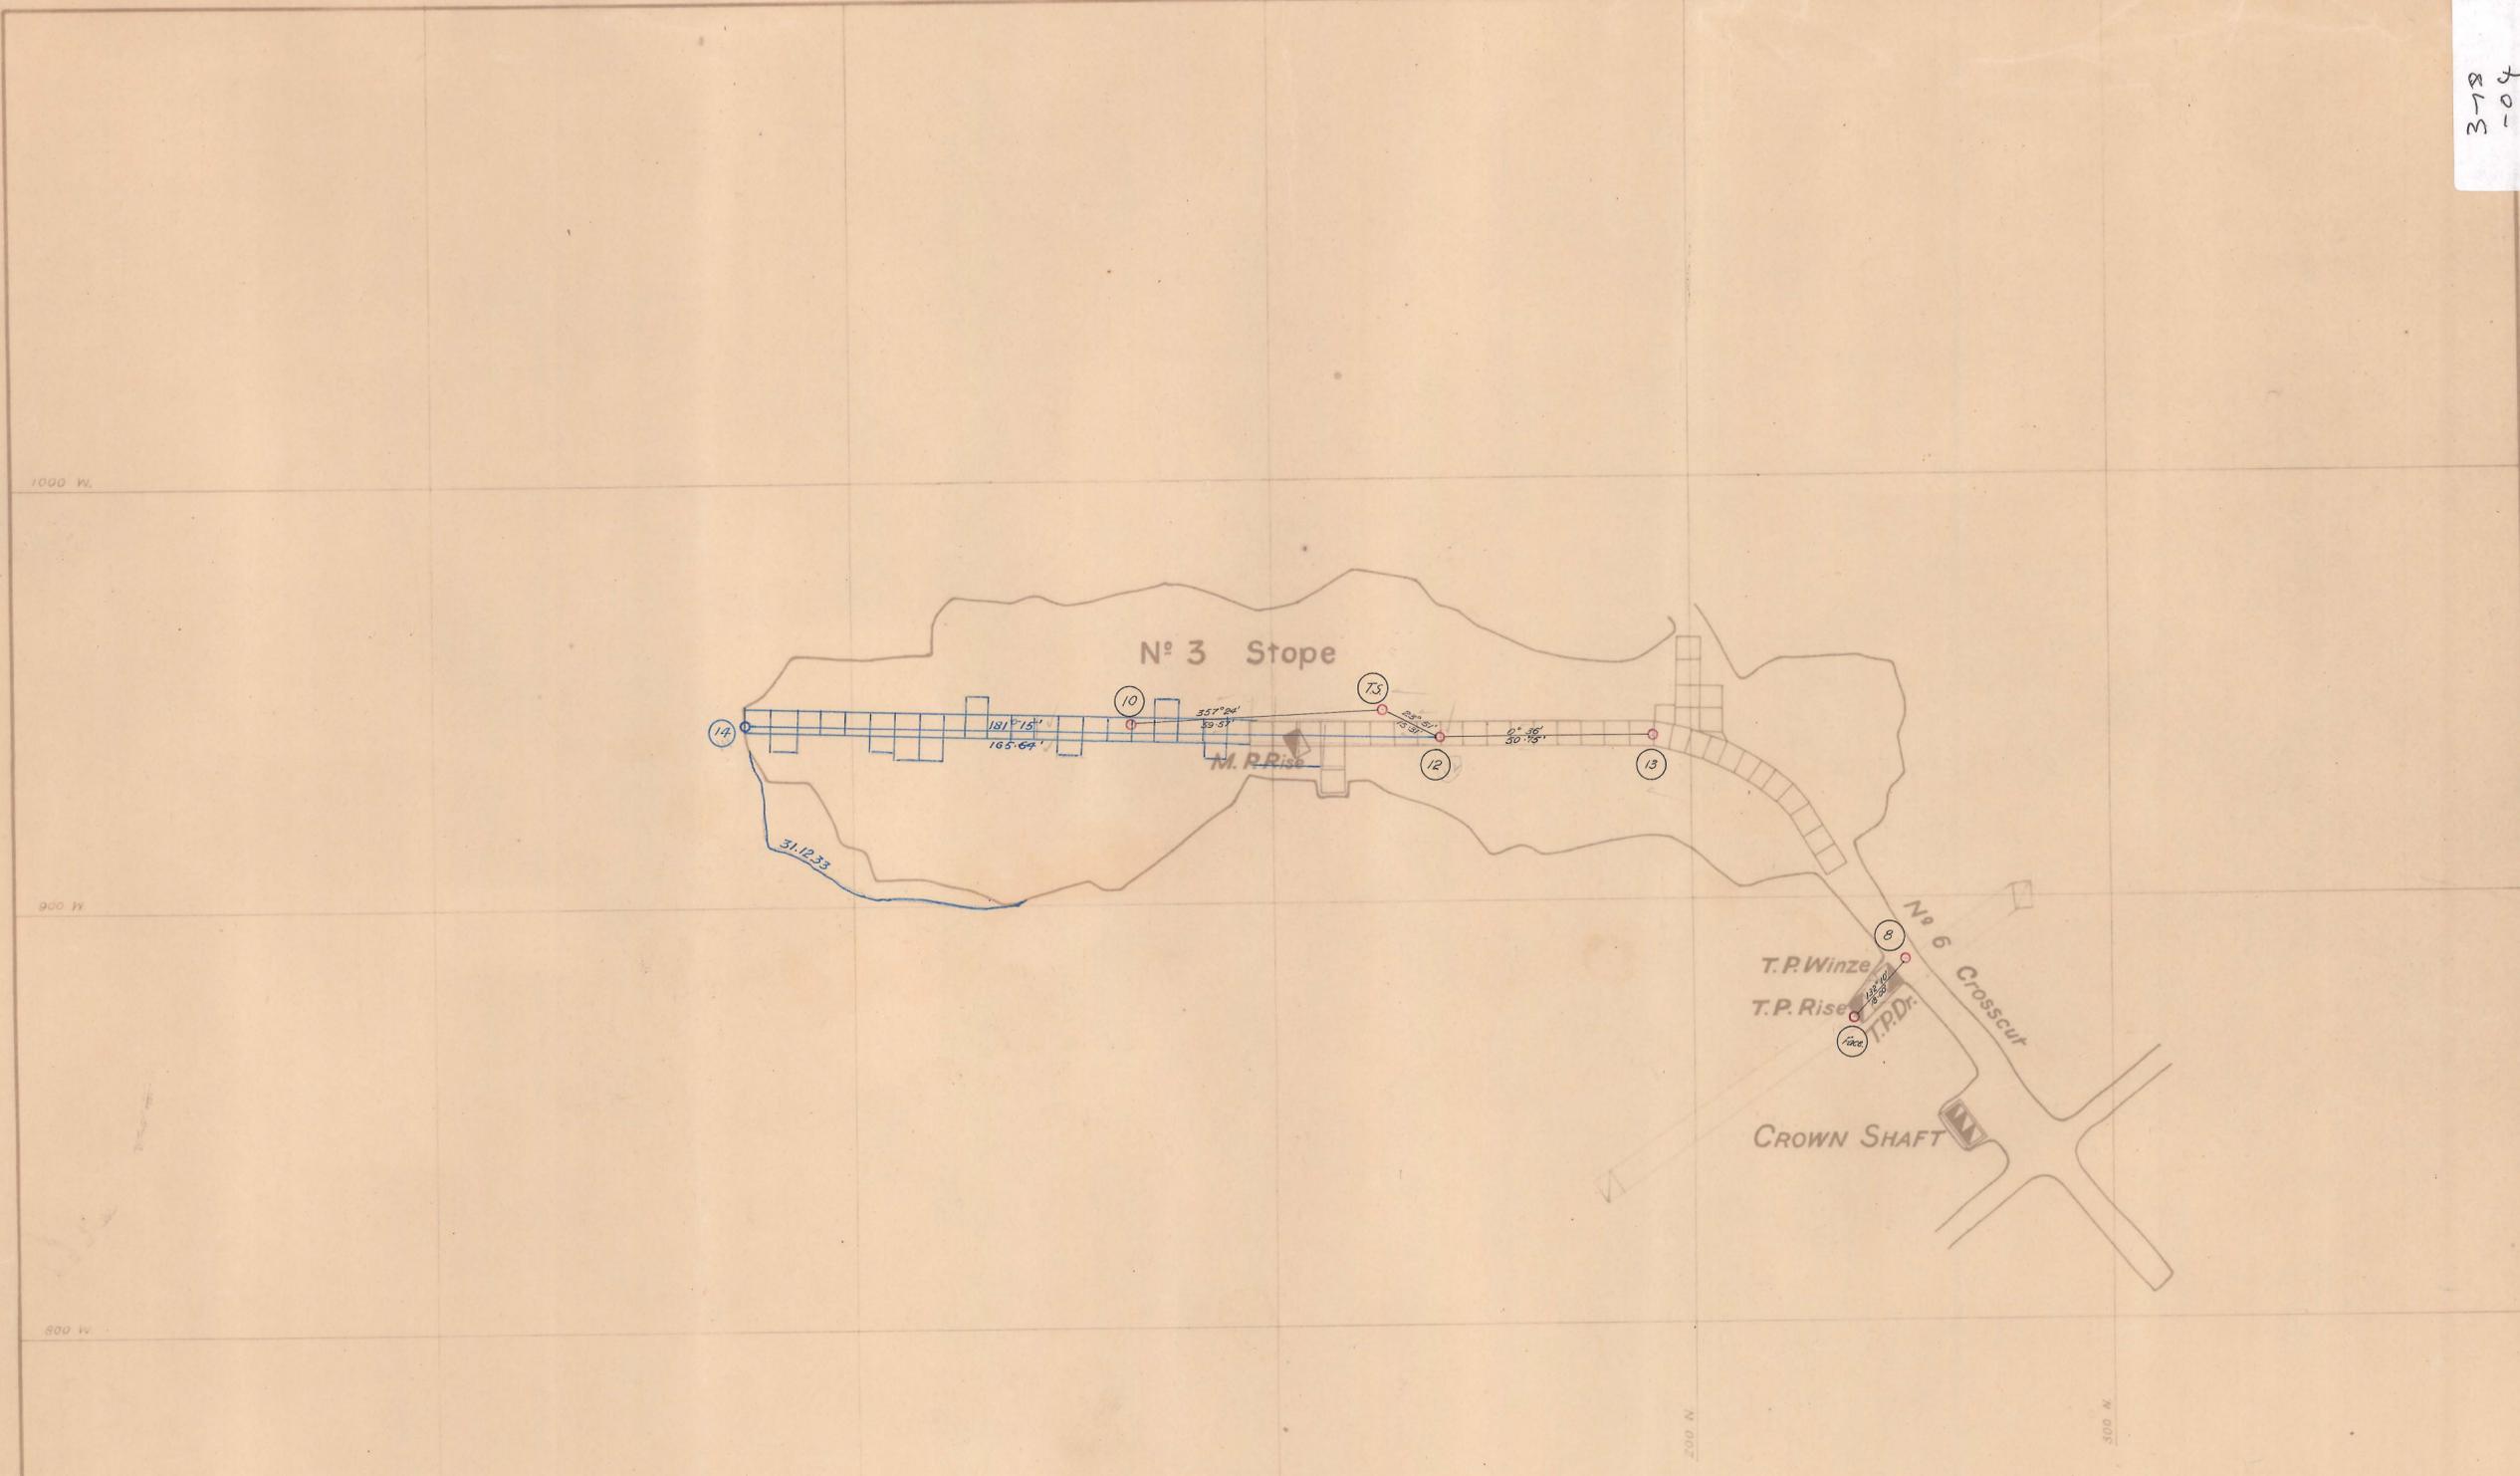


THE MOUNT LYELL M. & R. CO. LTD.

DETAIL PLAN

UNDERGROUND WORKINGS

300 FT. LEVEL

CROWN LYELL MINE

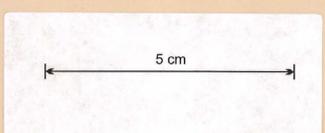

SCALE - 30 FEET TO ONE INCH

*R. J. Murray* GENERAL MANAGER.  
*G. Fred. Jakins* MINE SUPERINTENDENT.

*Ed  
 11/17/34  
 9/1/34*