


318-05

318-05

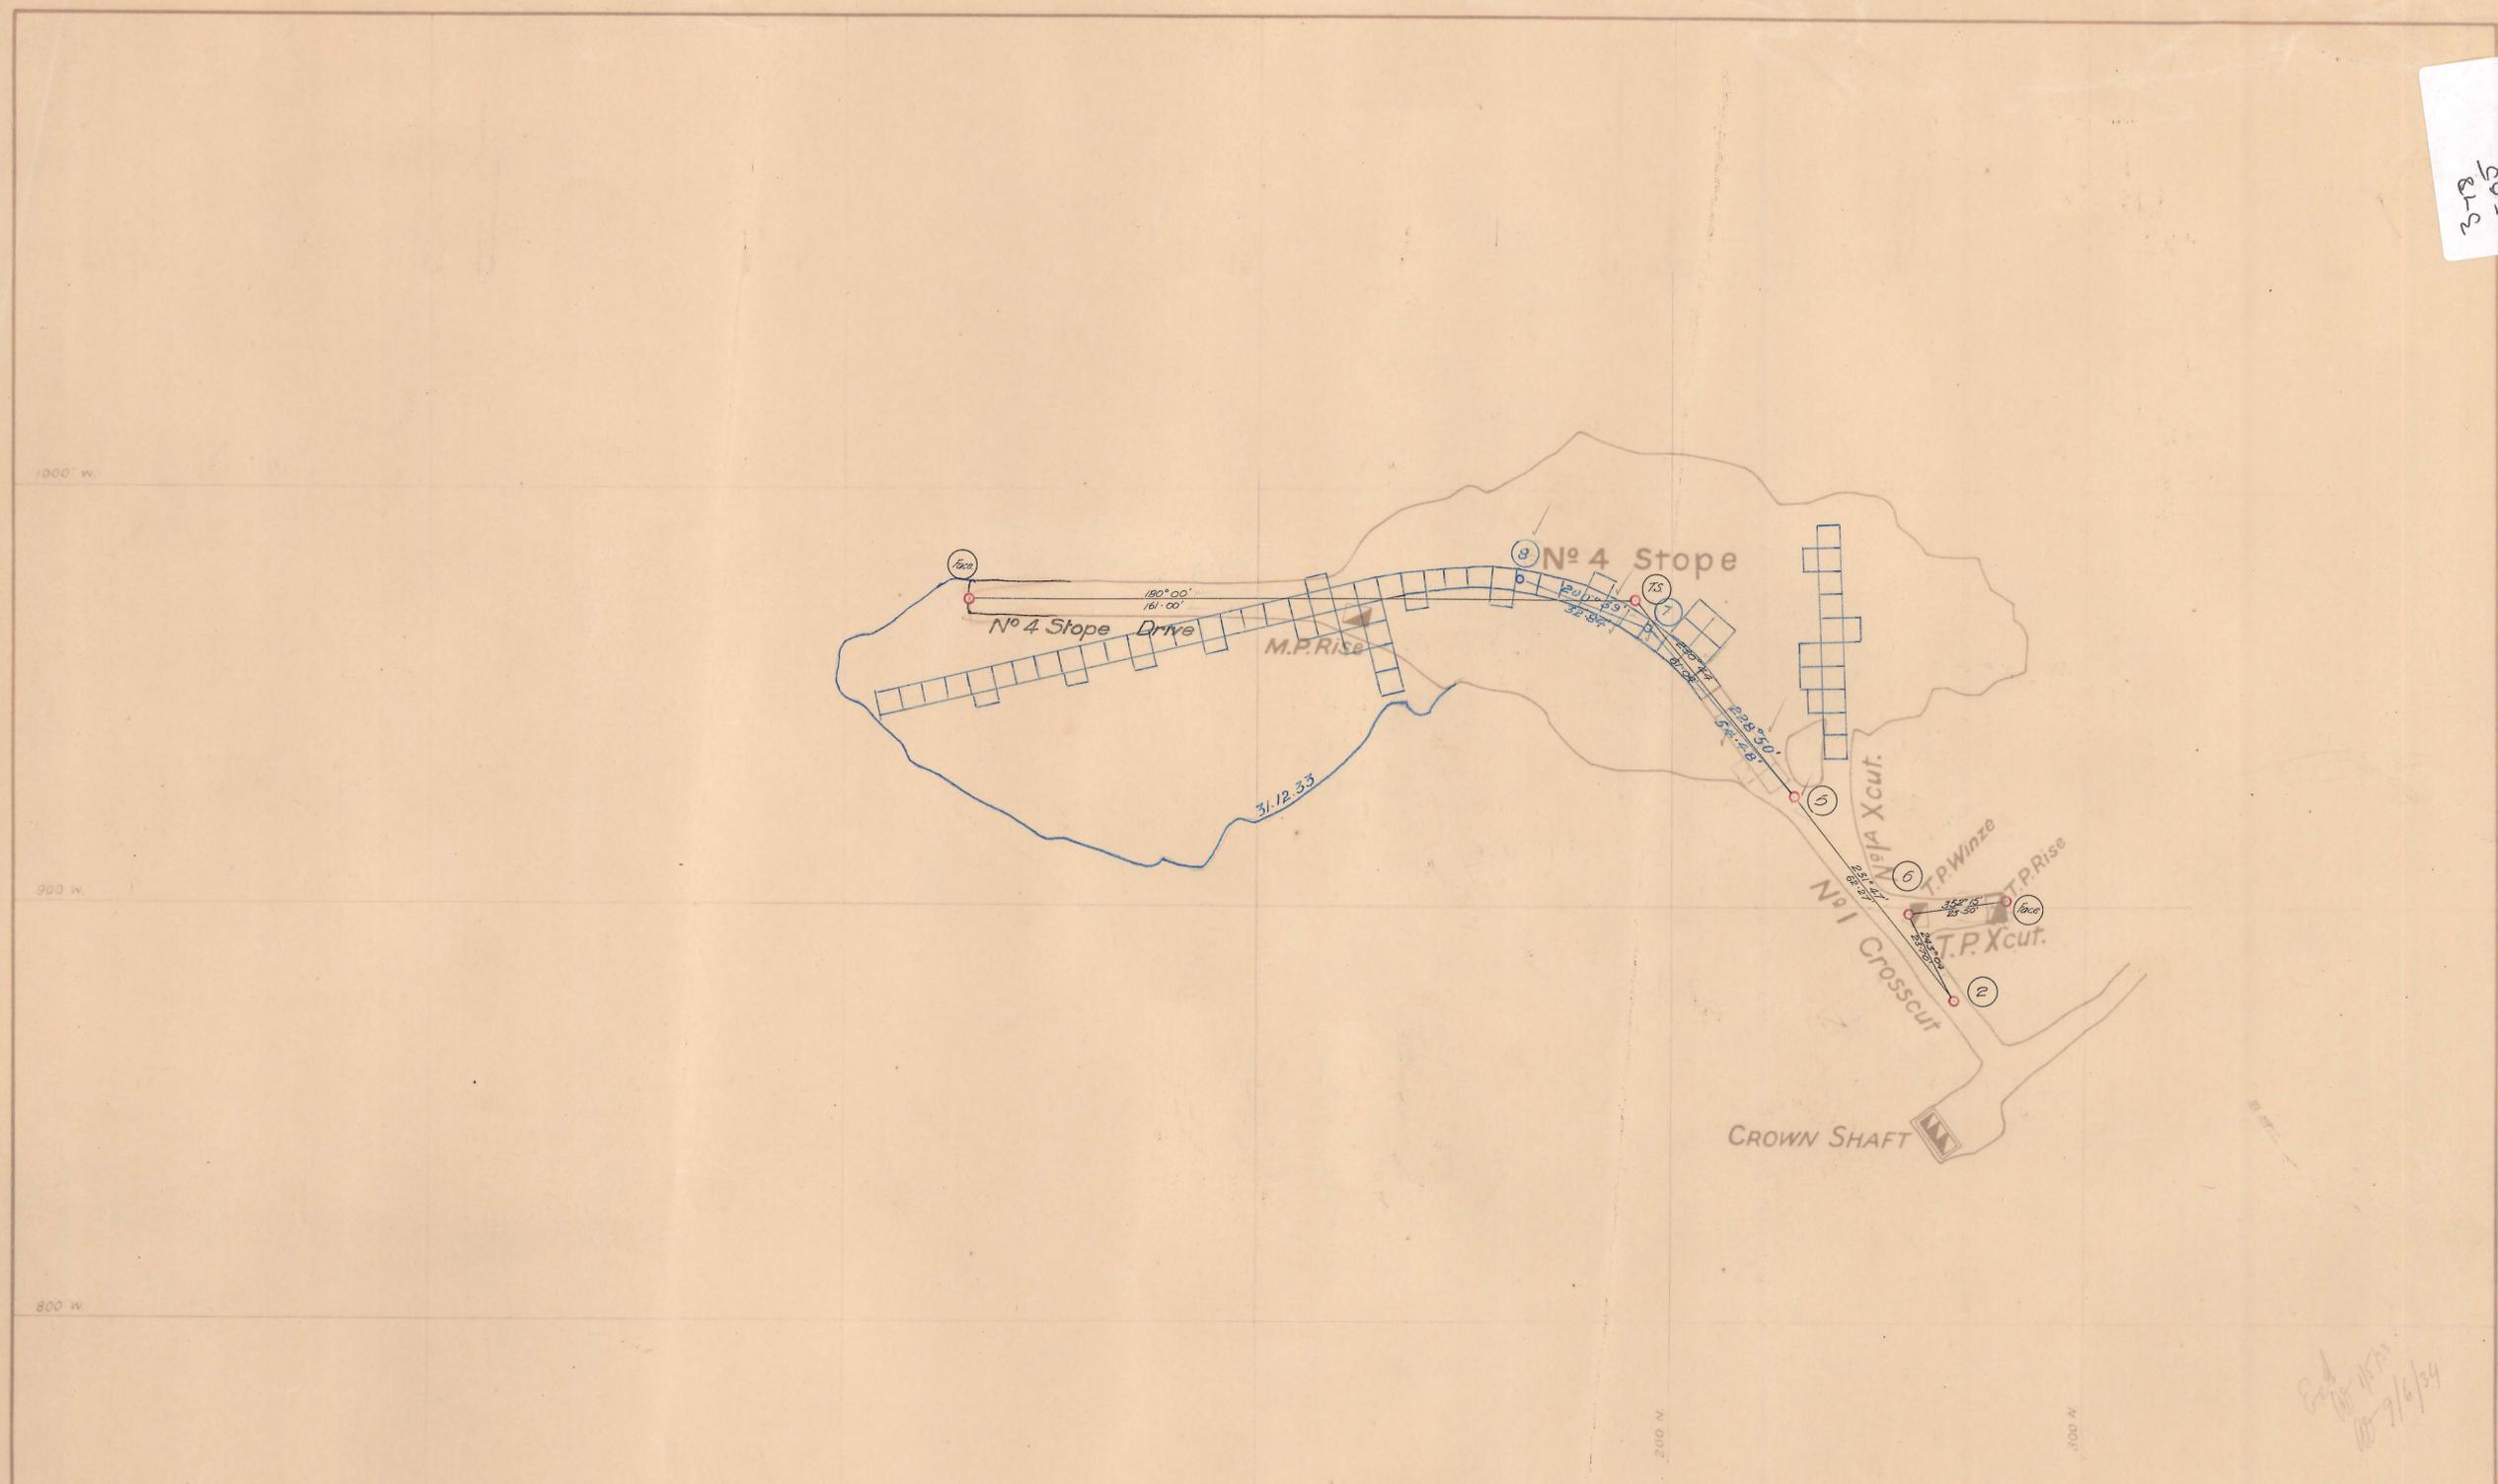

31-12-33  
7/6/34

THE MOUNT LYELL M. & R. CO. LTD.

DETAIL PLAN

UNDERGROUND WORKINGS


400 FT. LEVEL

CROWN LYELL MINE



SCALE - 30 FEET TO THE INCH

*R. J. Murray* GENERAL MANAGER.  
*G. Fred. Jenkins* MINE SUPERINTENDENT.

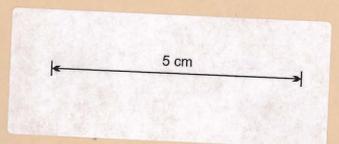

1000 W.  
 900 W.  
 800 W.  
 700 W.

200 W.

300 W.

100 W.