


378-115

378-115

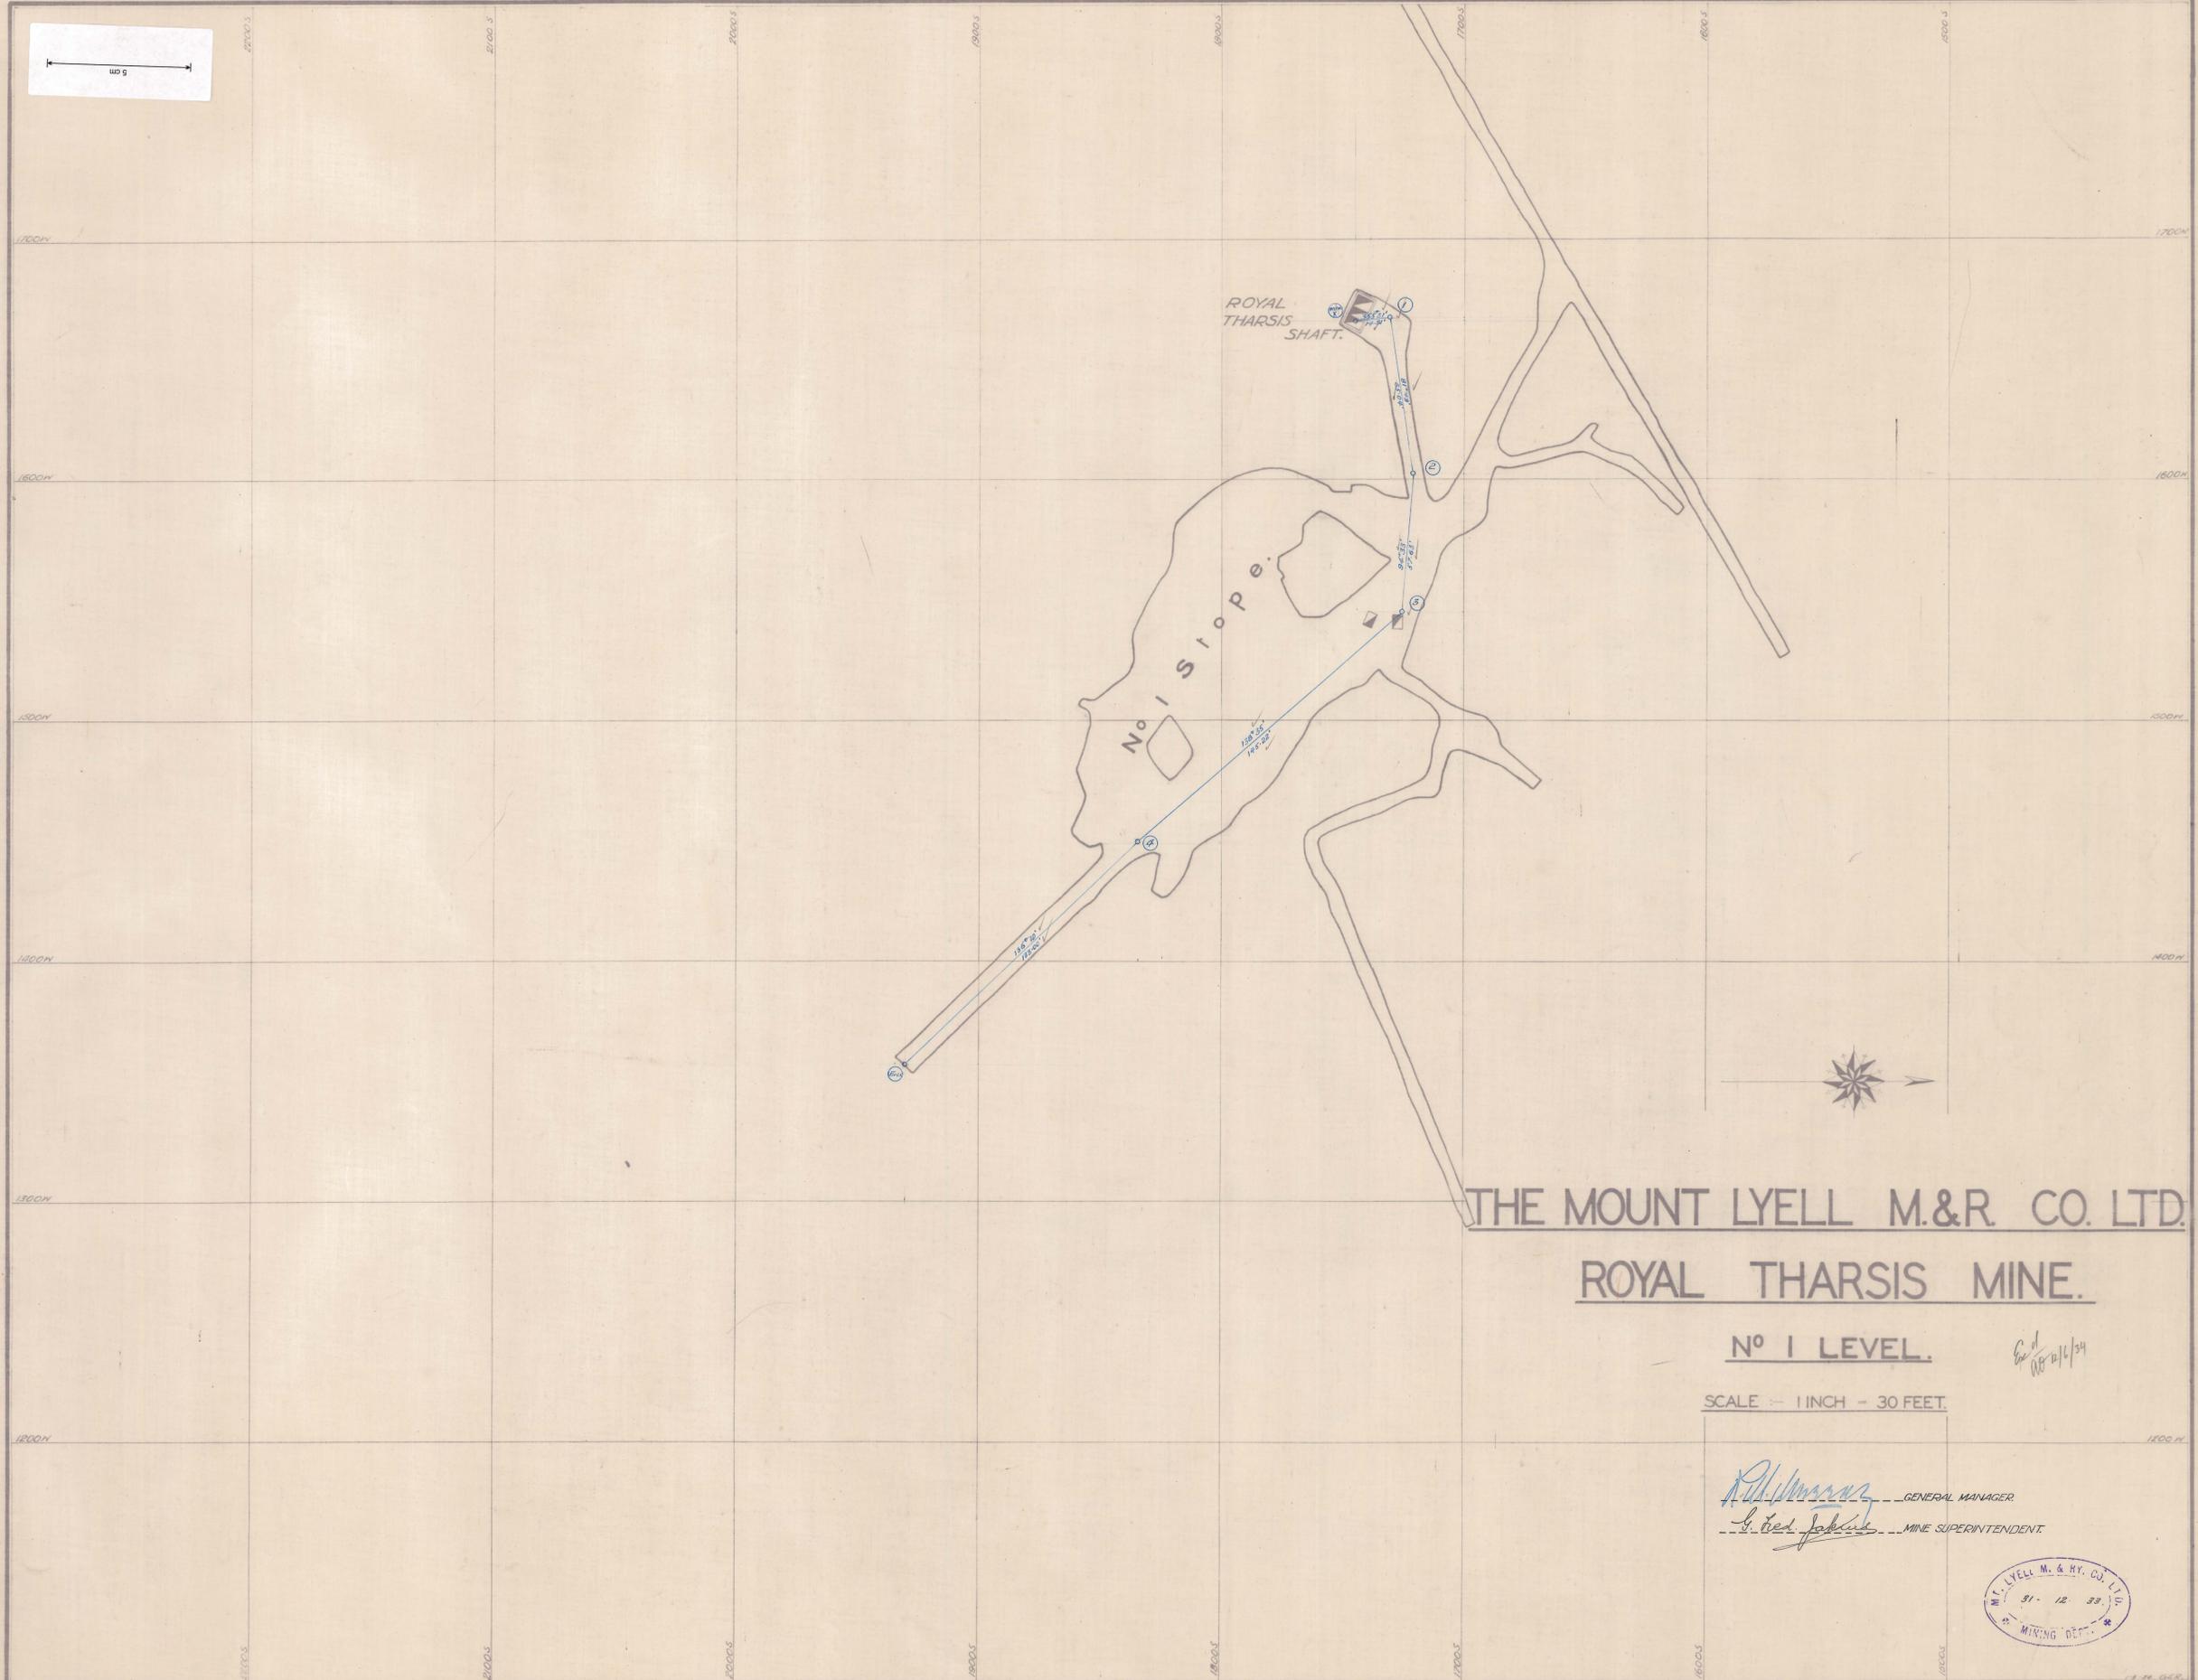

THE MOUNT LYELL M.&R. CO. LTD.
ROYAL THARSIS MINE.

No 1 LEVEL. *Ed. 1/11/54*
 SCALE - 1 INCH - 30 FEET.

R. Williams GENERAL MANAGER
E. J. Johnson MINE SUPERINTENDENT

