

MOUNT LYELL M. & R. CO. LTD.


Mine Department.

NORTH LYELL MINE.

Section on Line BB Looking North.

Brought up to Dec 31st 1932.

Scale 1" = 30'

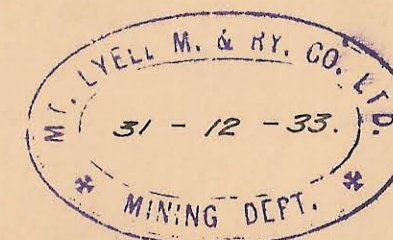

R. H. W. W. W. General Manager
S. J. J. J. Mine Superintendent