


3-19-32



3-19-32

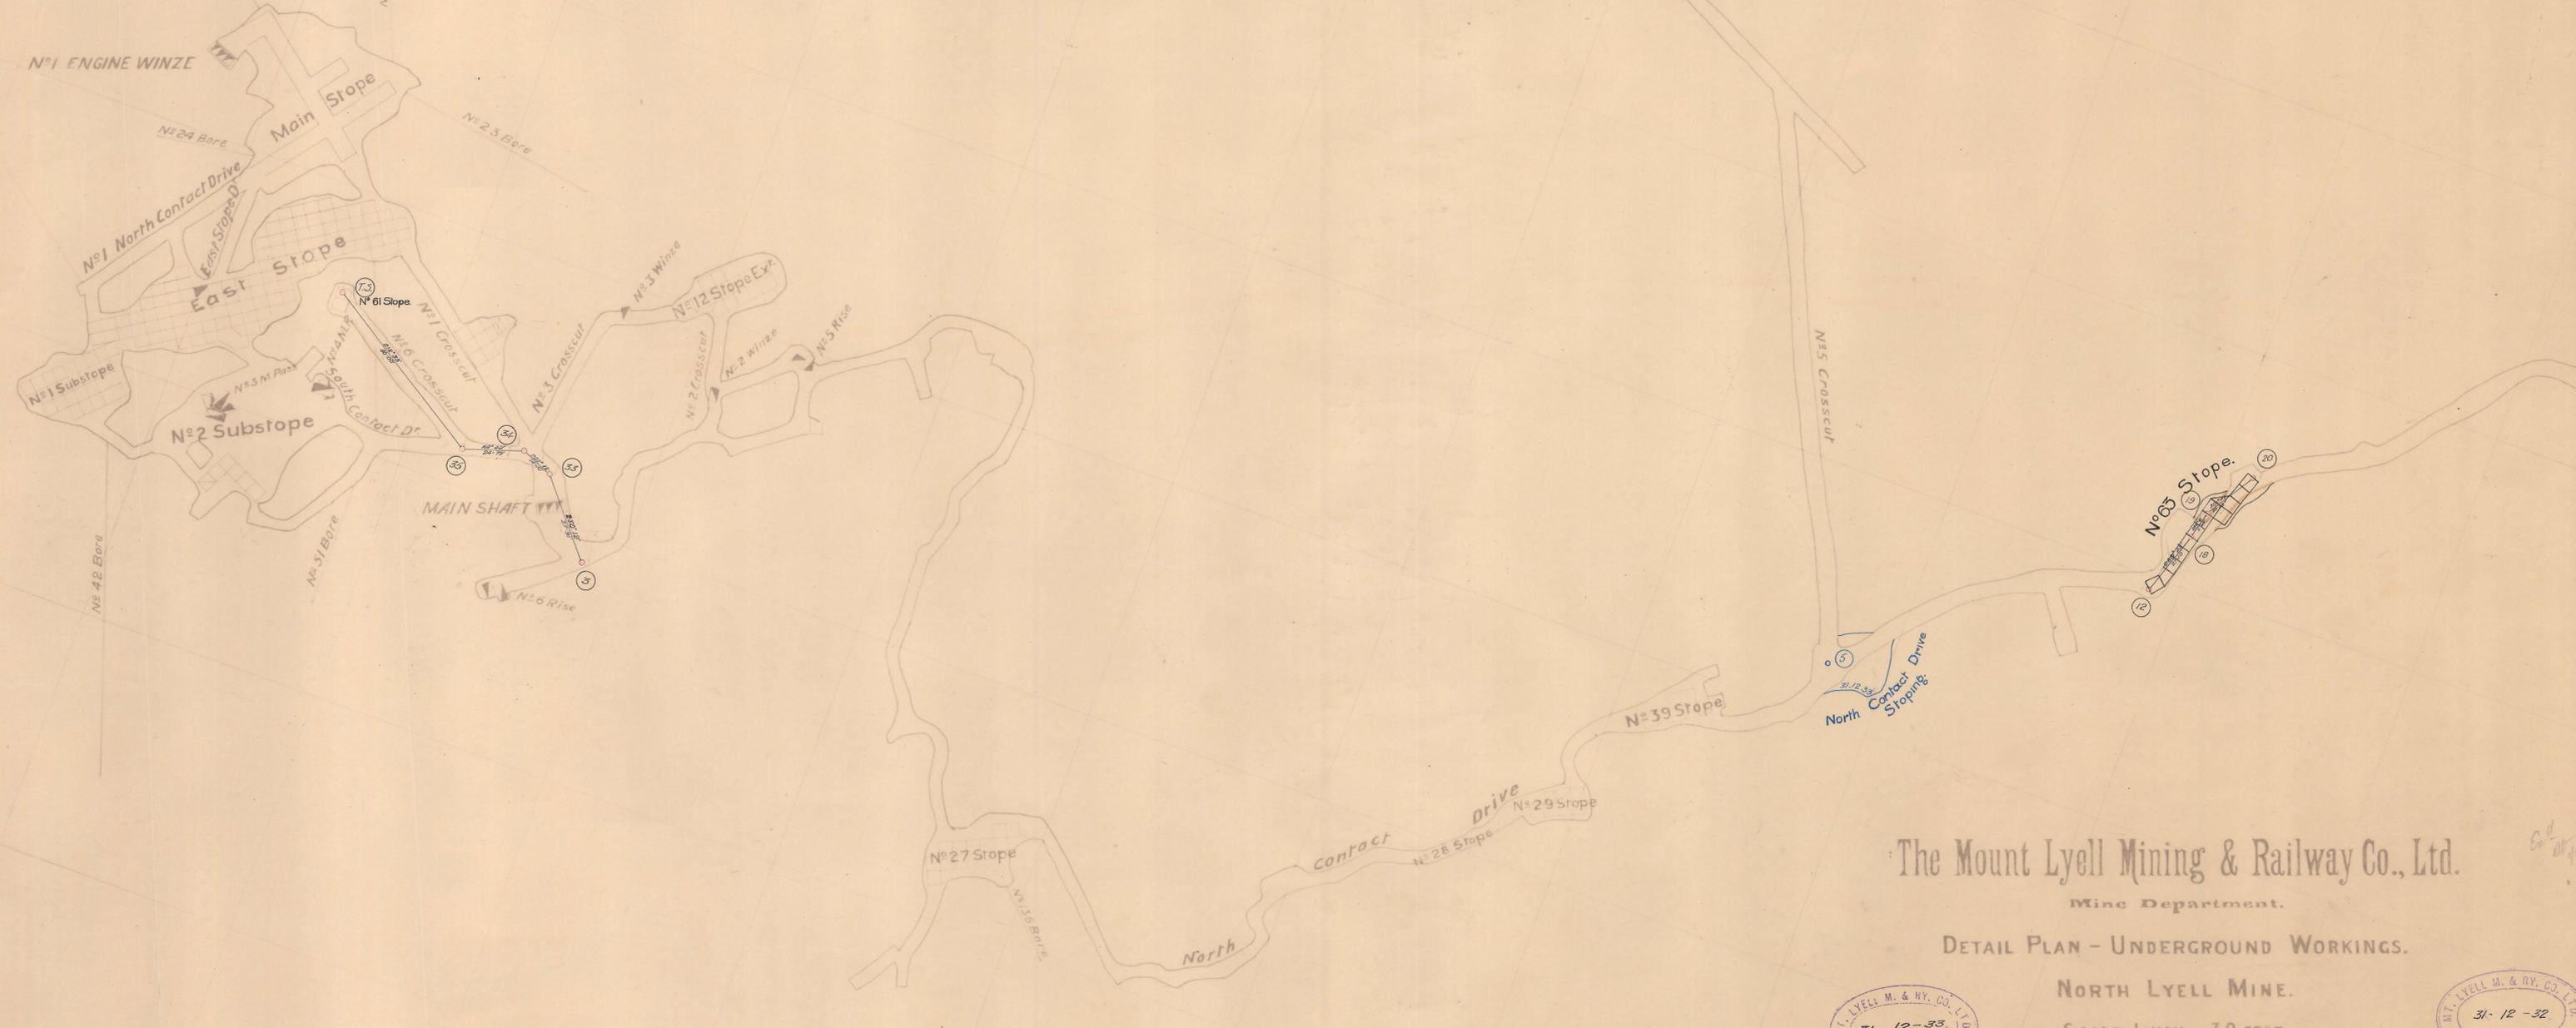

500' LEVEL

The Mount Lyell Mining & Railway Co., Ltd.

Mine Department.

DETAIL PLAN - UNDERGROUND WORKINGS.

NORTH LYELL MINE.

SCALE - 1 INCH = 30 FEET.

Brought up to 31st Dec. 1932



W. J. Murray GENERAL MANAGER.
C. Red. J. J. J. MINE SUPERINTENDENT.

Ed. at 1/12/32