




3-3

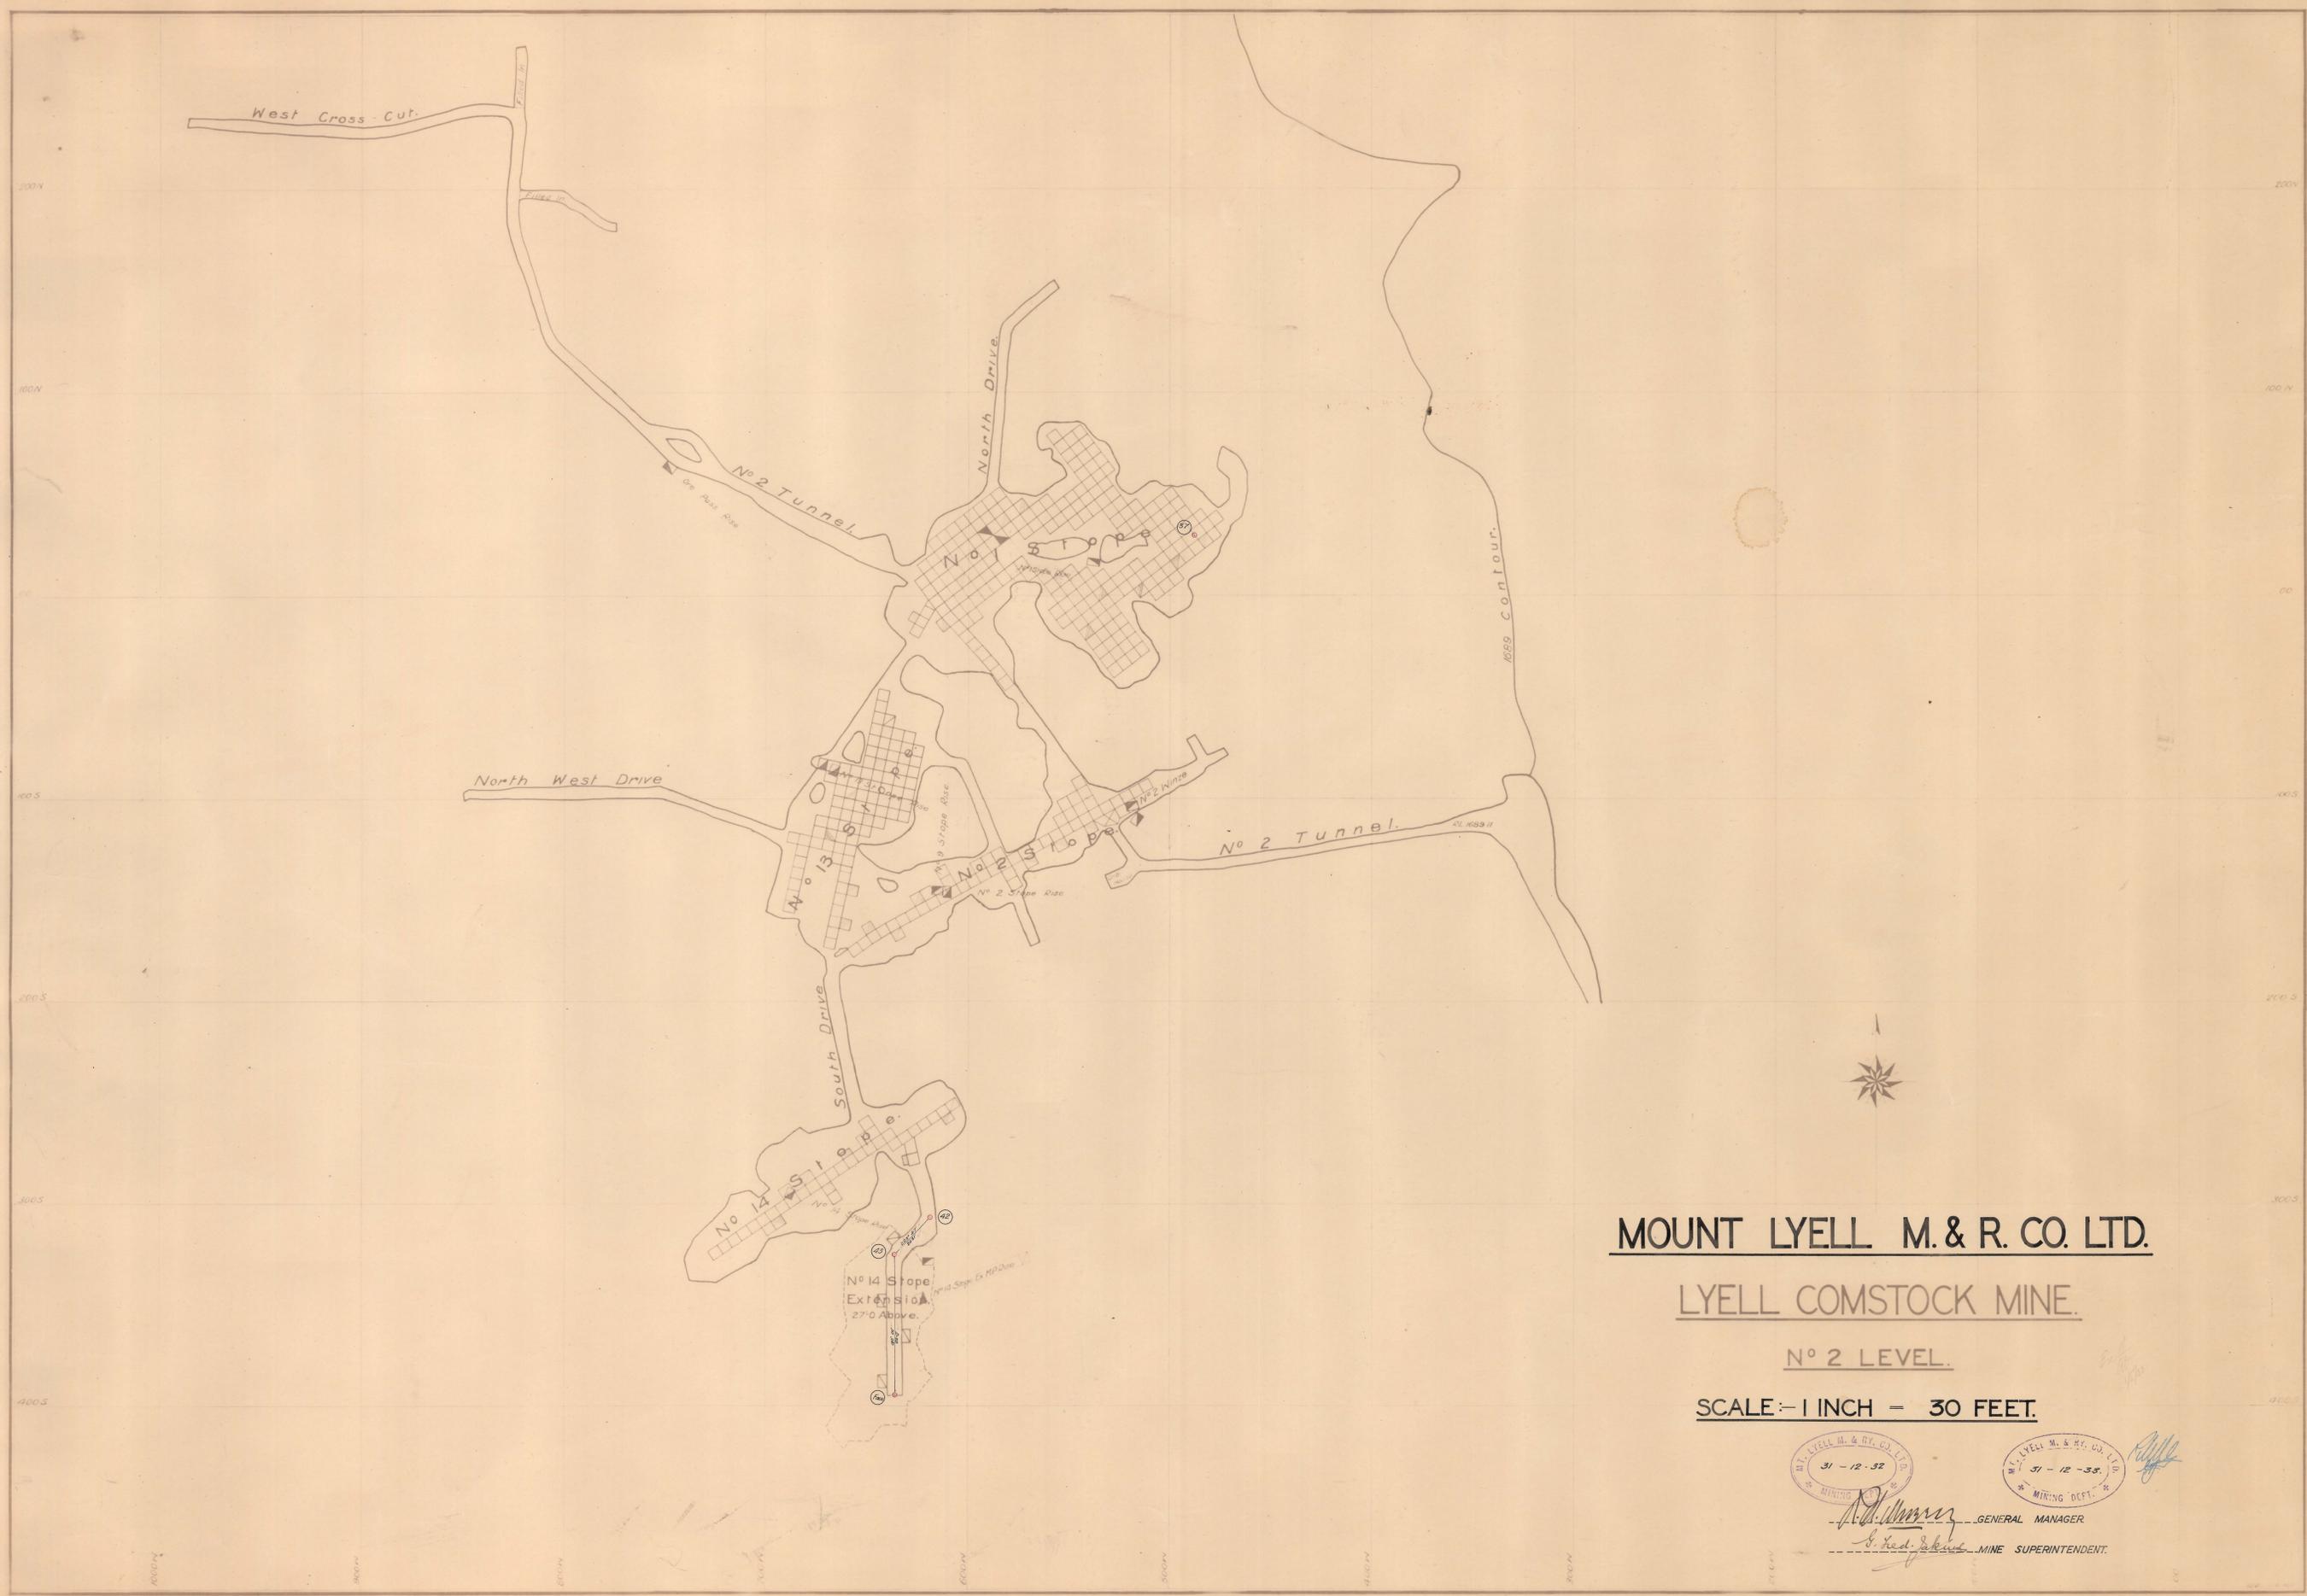

MOUNT LYELL M. & R. CO. LTD.

LYELL COMSTOCK MINE.

No. 2 LEVEL.

SCALE: 1 INCH = 30 FEET.



[Signature] GENERAL MANAGER
[Signature] MINE SUPERINTENDENT