


318
-25

318
-25

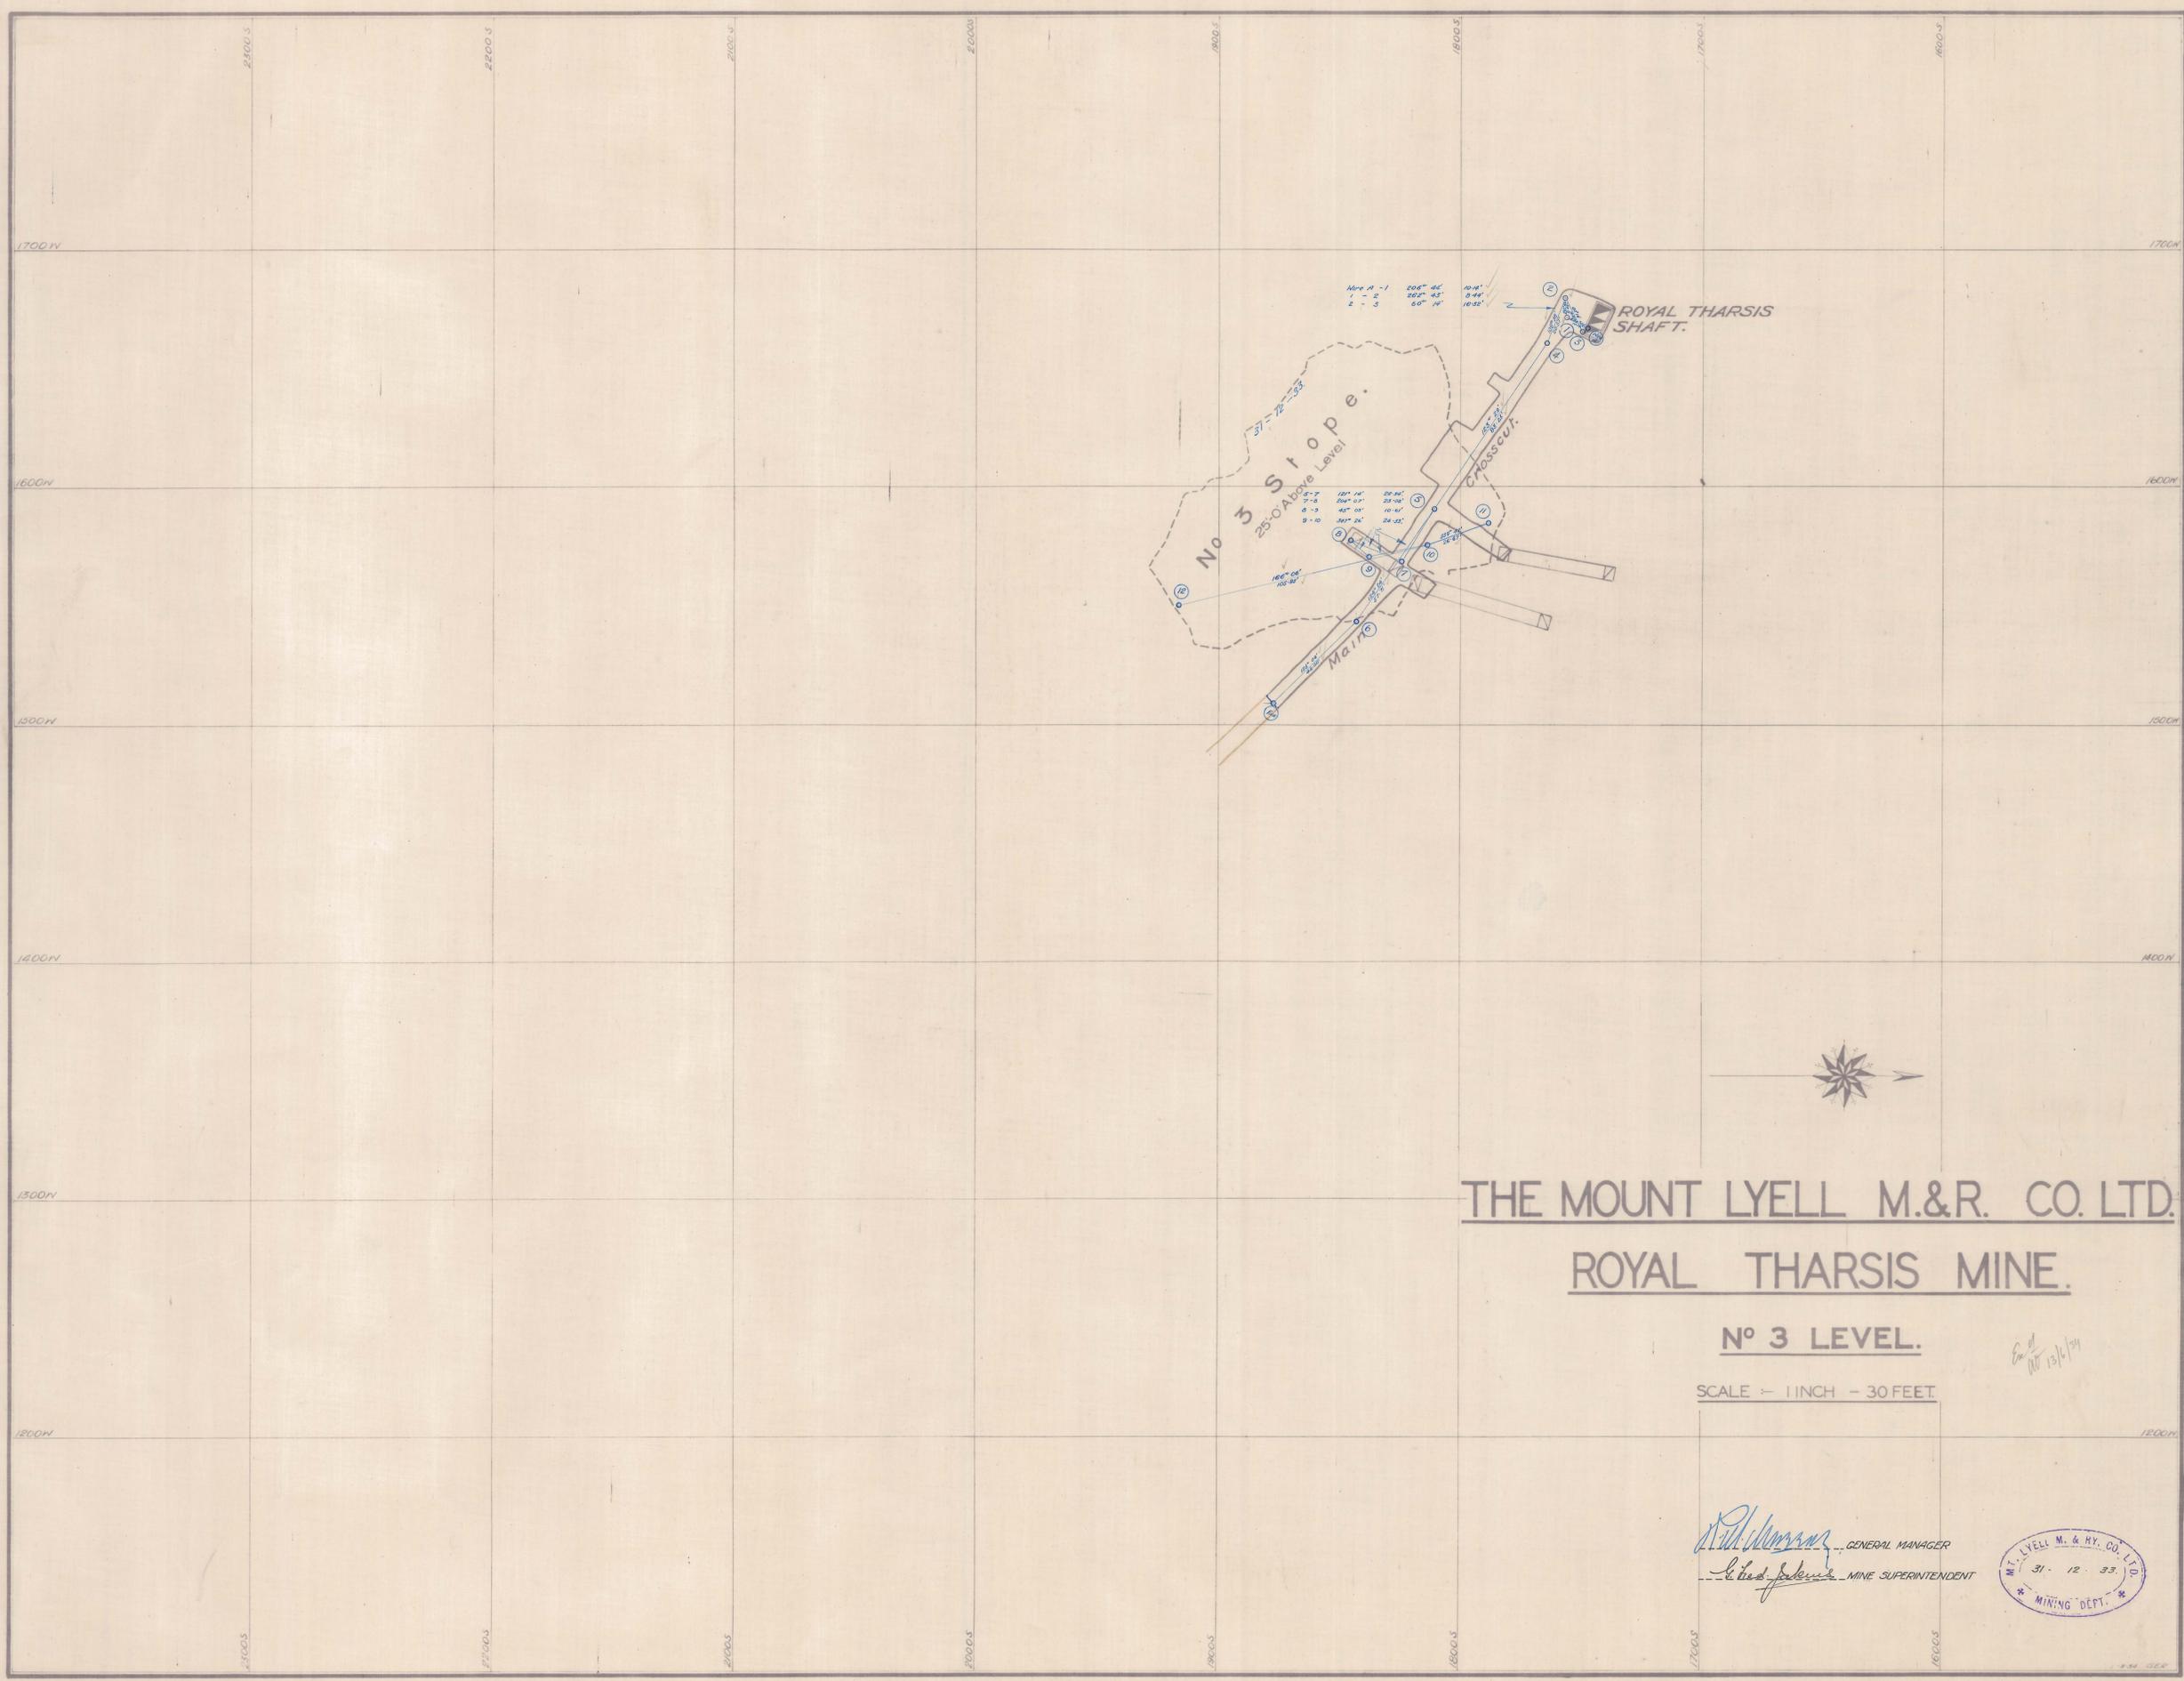

THE MOUNT LYELL M.&R. CO. LTD.
ROYAL THARSIS MINE.

Nº 3 LEVEL.

SCALE = 1 INCH = 30 FEET

R. P. Morrison GENERAL MANAGER
C. G. Johnson MINE SUPERINTENDENT

