
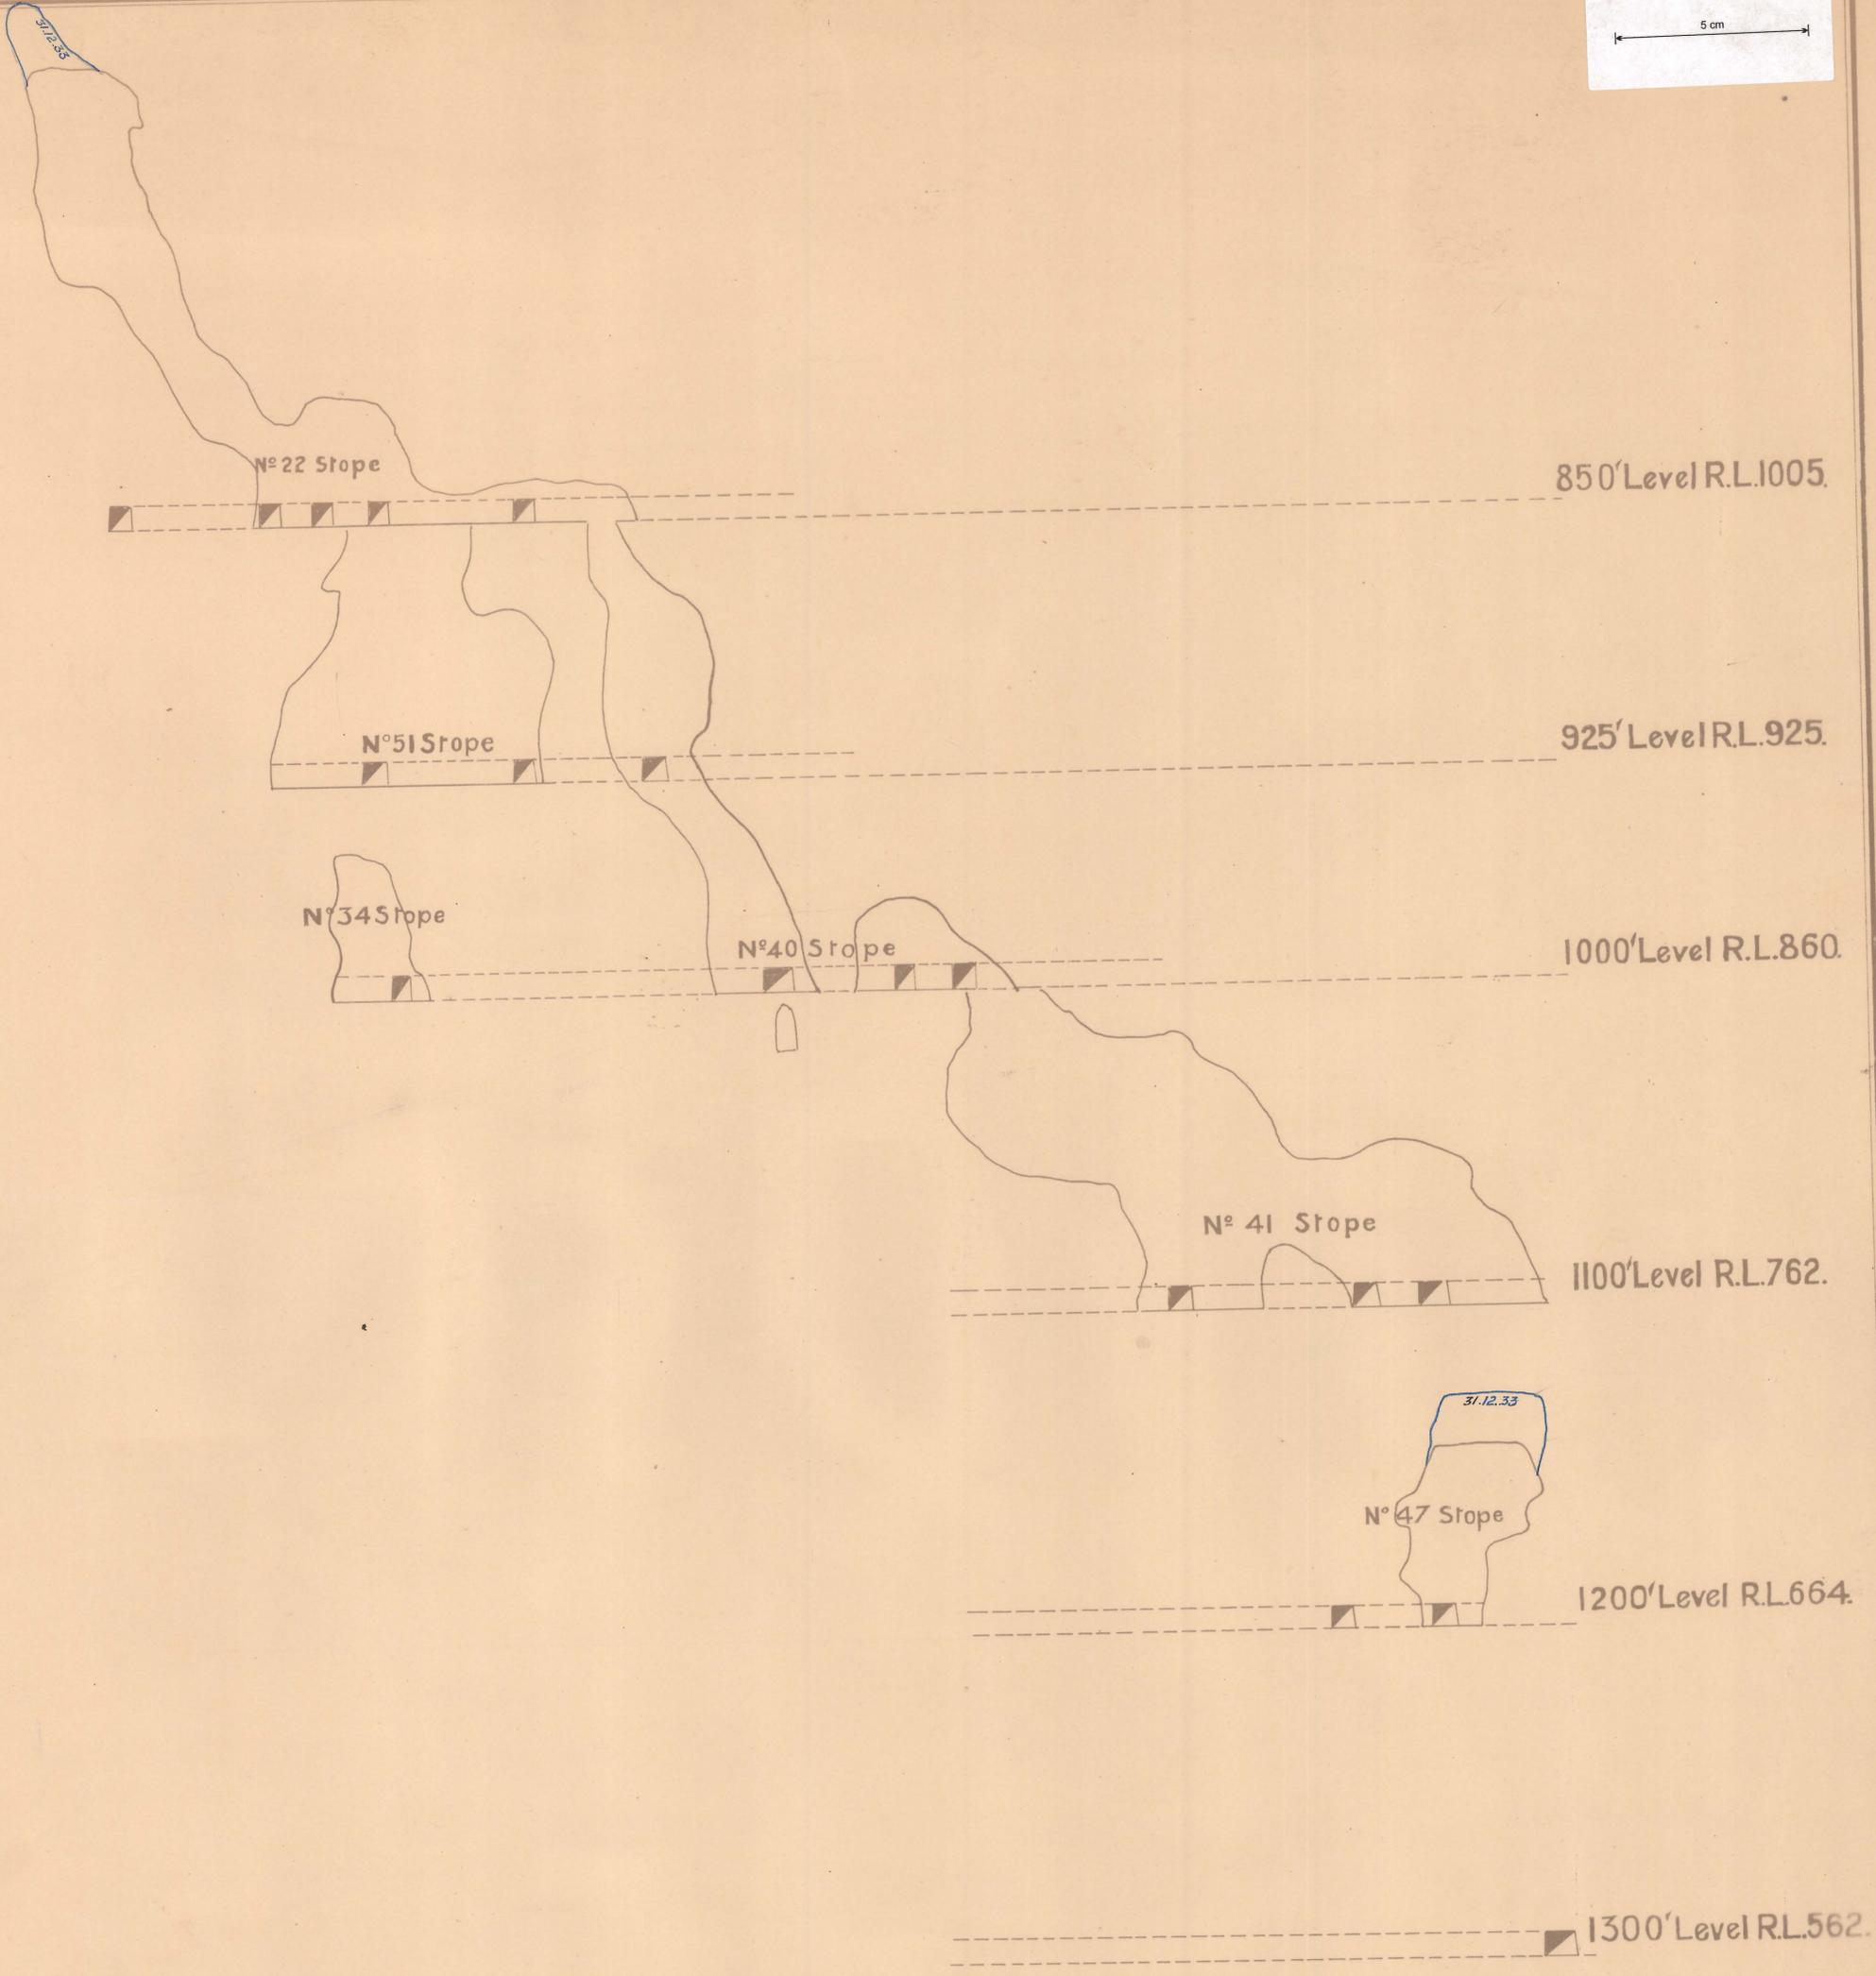


3-78  
-26

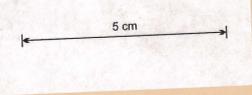

# MOUNT LYELL M & R CO. LTD.

Mine Department  
NORTH LYELL MINE

Section on Line **DD** looking North  
Brought up to Dec. 31<sup>st</sup> 1933  
Scale 1" = 30'



*R. J. ...* General Manager  
*L. ...* Mine Superintendent

3-78  
-26