
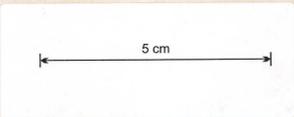


381
- 01

381
- 01

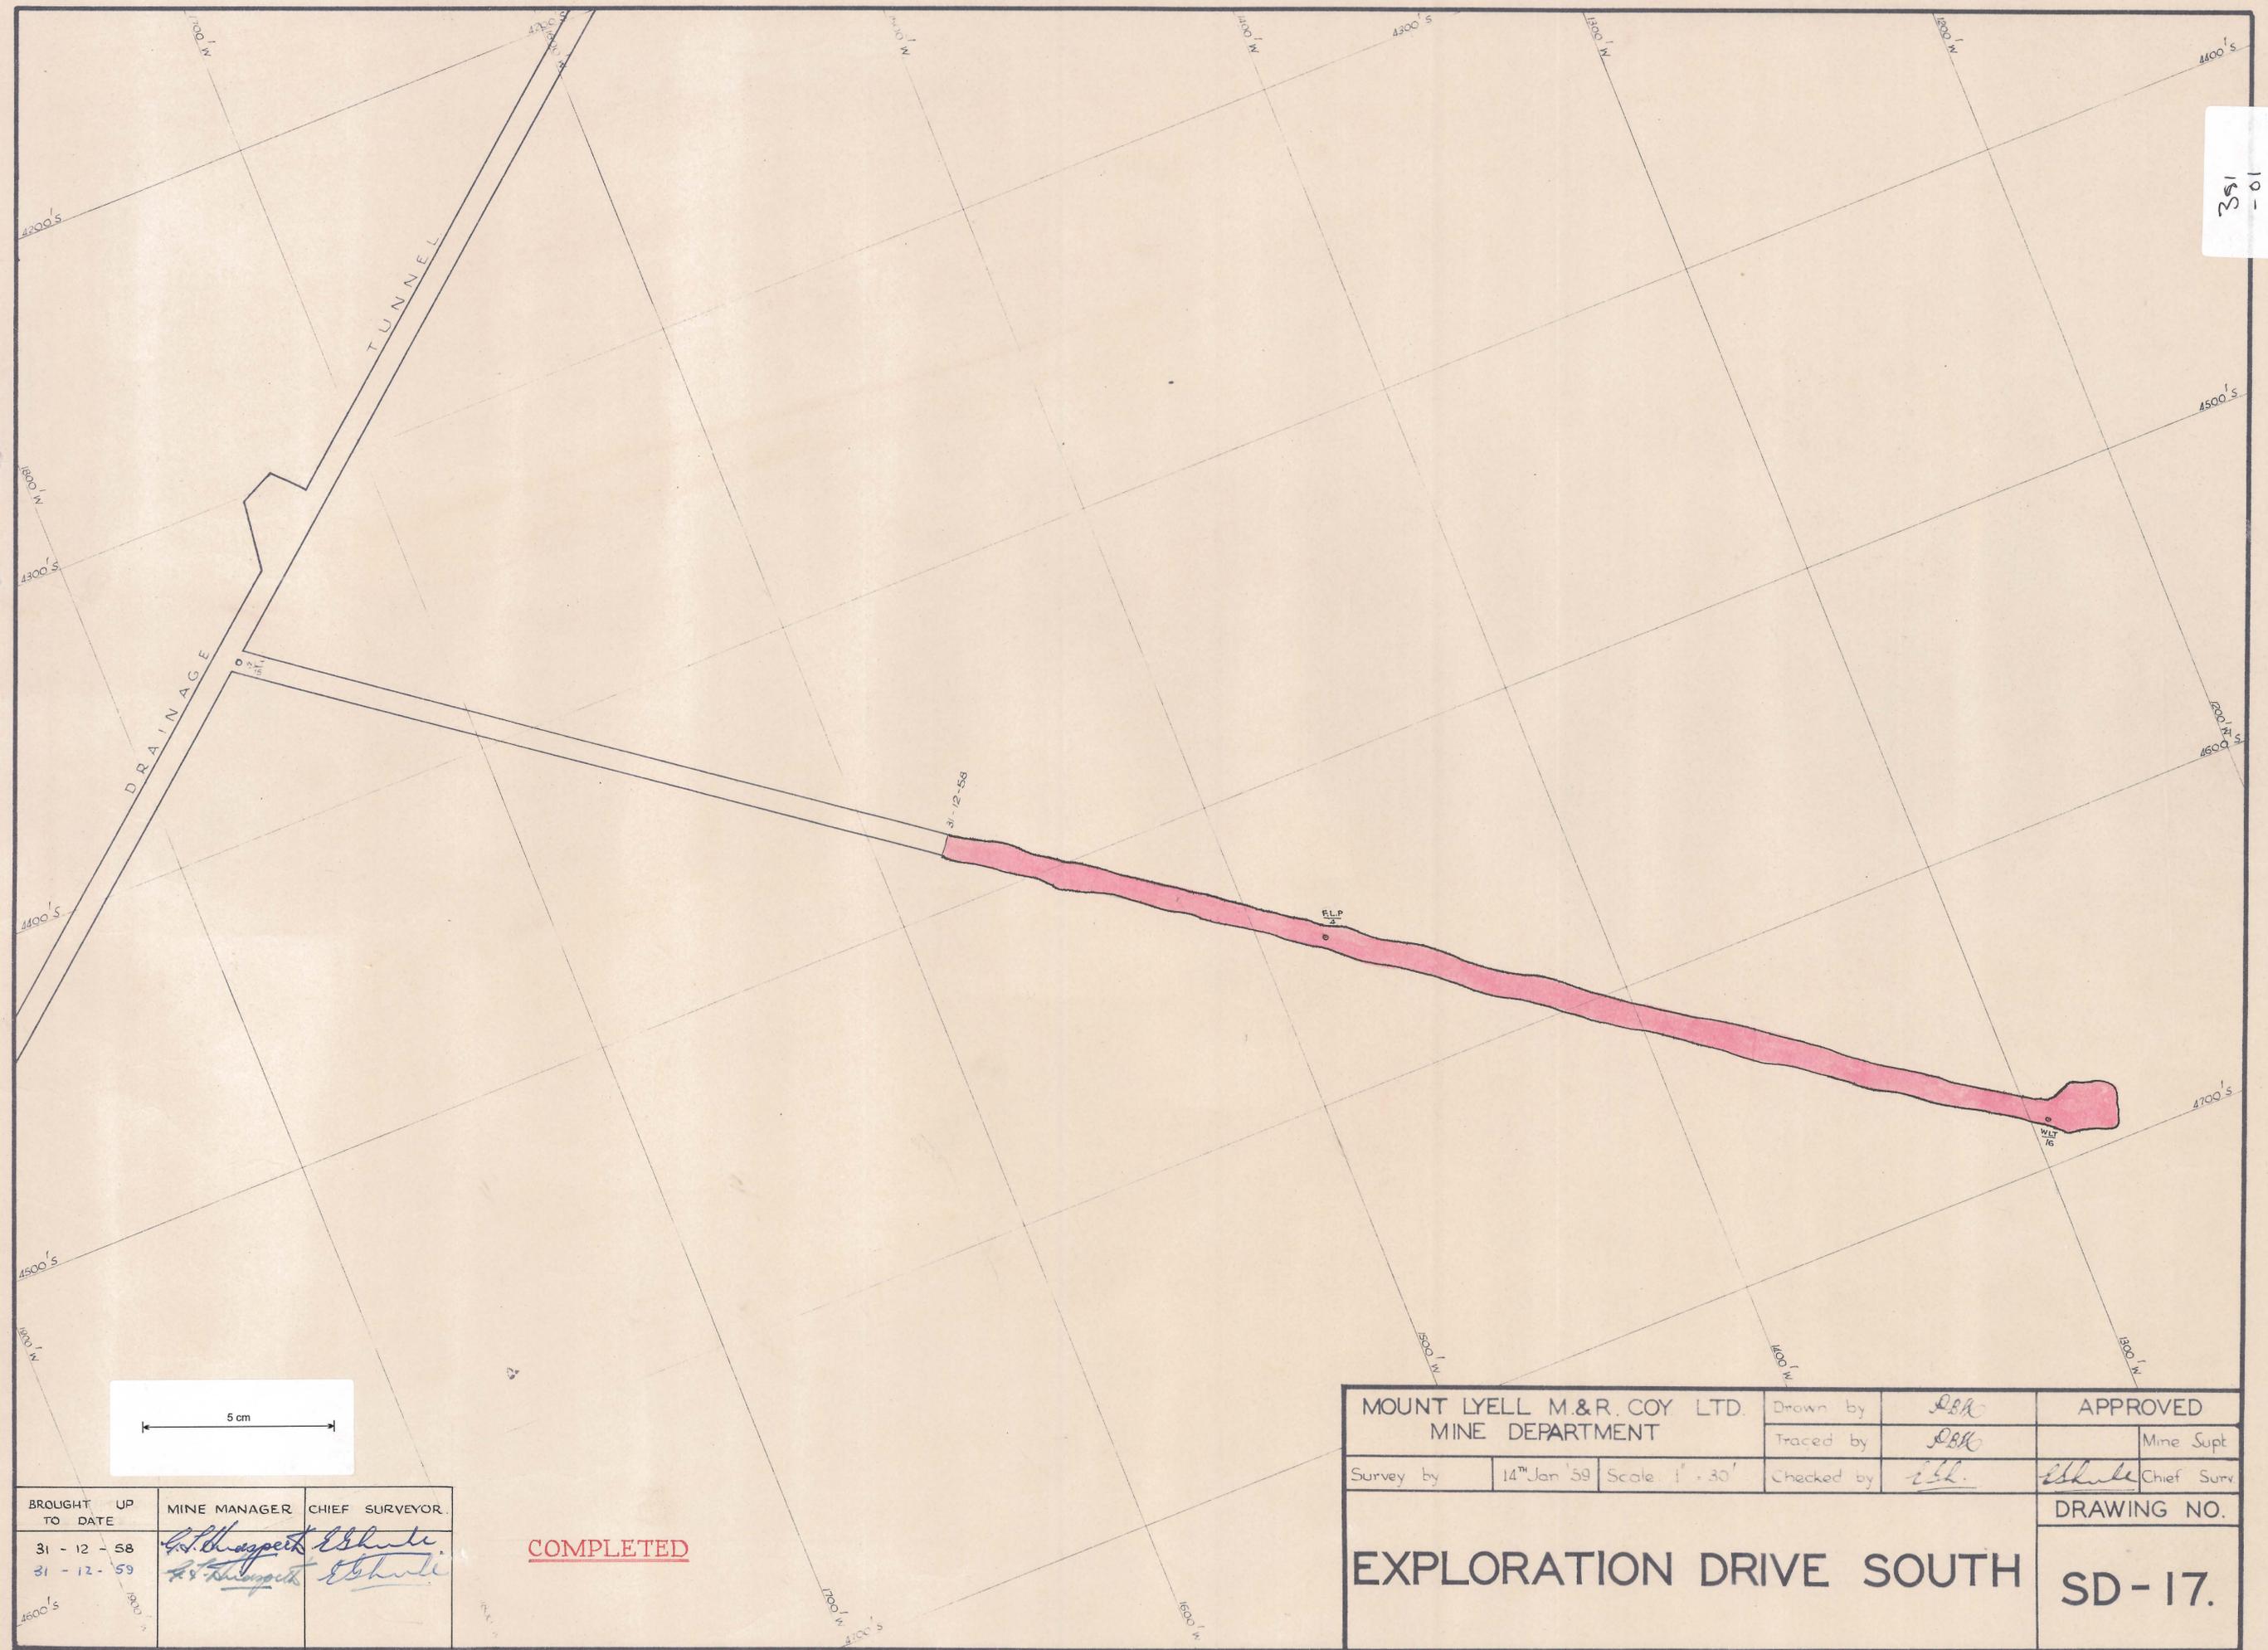

BROUGHT UP TO DATE	MINE MANAGER	CHIEF SURVEYOR
31 - 12 - 58	<i>[Signature]</i>	<i>[Signature]</i>
31 - 12 - 59	<i>[Signature]</i>	<i>[Signature]</i>

COMPLETED

MOUNT LYELL M.&R. COY. LTD. MINE DEPARTMENT		Drawn by <i>[Signature]</i>	APPROVED
		Traced by <i>[Signature]</i>	Mine Supt
Survey by	14 th Jan '59	Scale 1" = 30'	Checked by <i>[Signature]</i> Chief Surv
EXPLORATION DRIVE SOUTH			DRAWING NO.
			SD-17.