


281  
-02

281  
-02

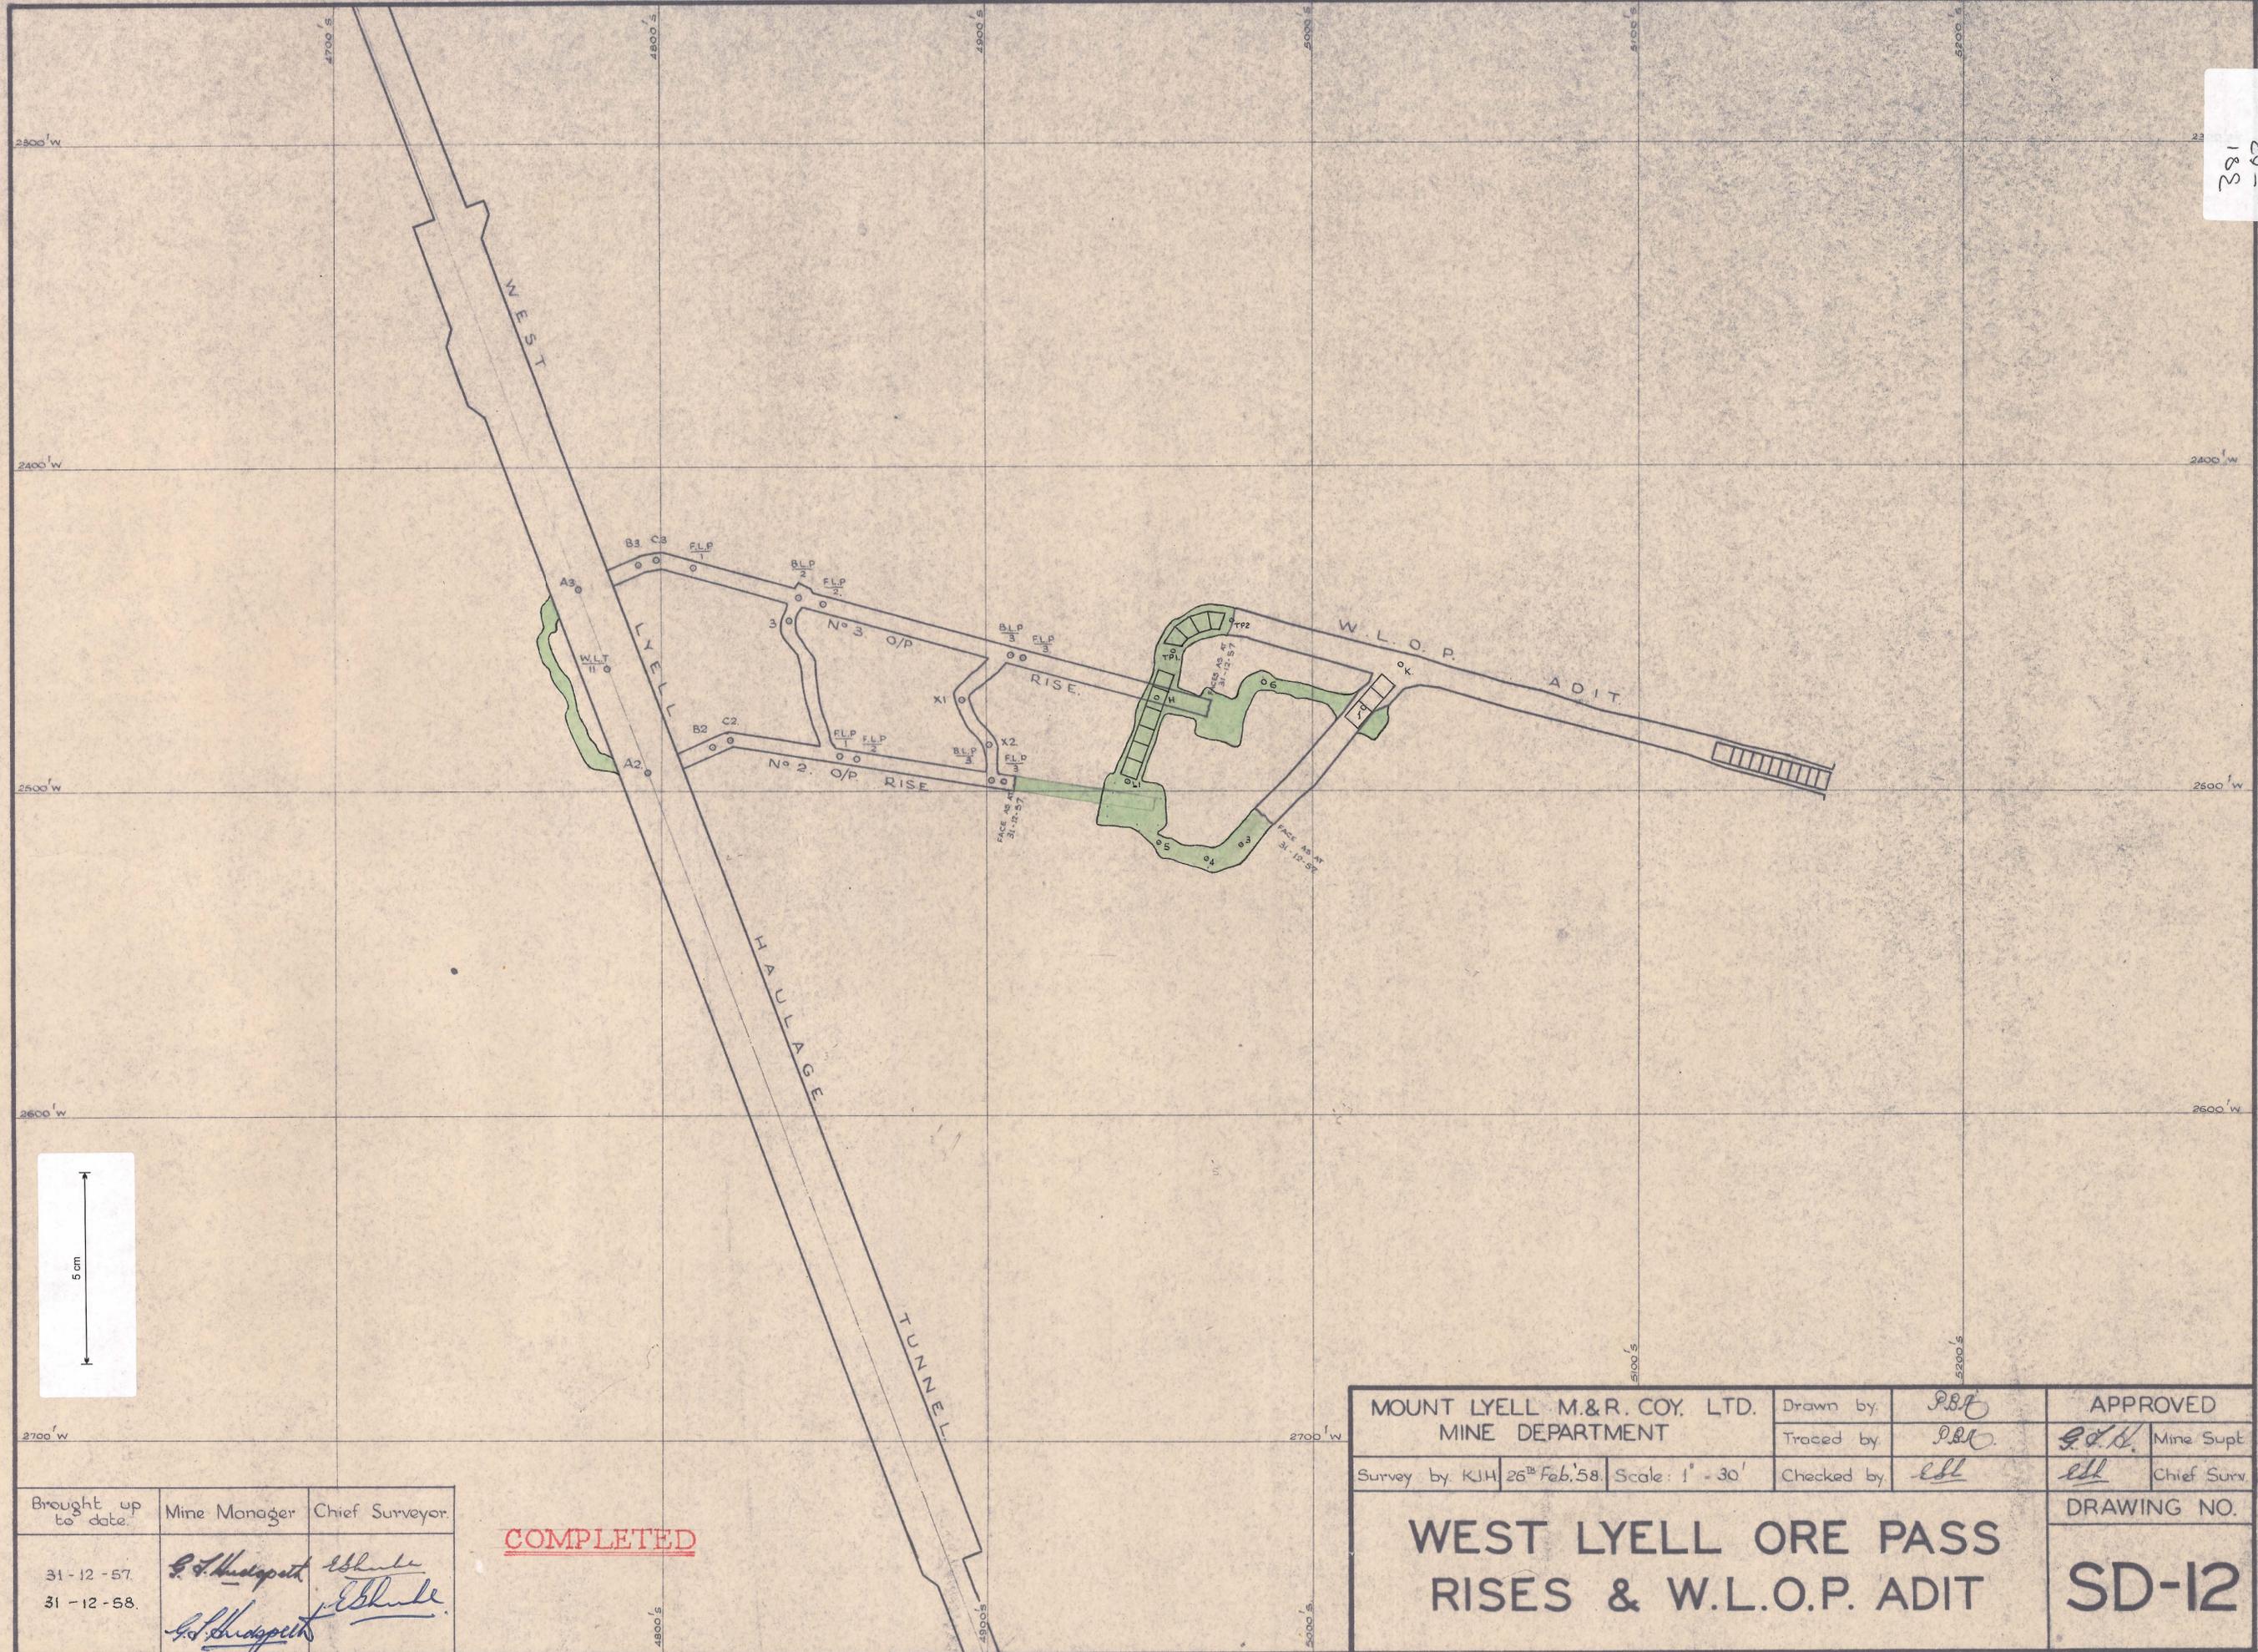

|  |  |                          |                          |
|--|--|--------------------------|--------------------------|
| MOUNT LYELL M.&R. COY. LTD.<br>MINE DEPARTMENT             |  | Drawn by: <i>P.B.F.</i>  | APPROVED                 |
| Survey by: K.H. 26 <sup>th</sup> Feb. '58. Scale: 1" = 30' |  | Traced by: <i>P.B.F.</i> | <i>S.D.D.</i> Mine Supt. |
|  |  | Checked by: <i>ell</i>   | <i>ell</i> Chief Surv.   |

|   |  |              |
|---|--|--------------|
| <p style="text-align: center;"><b>WEST LYELL ORE PASS<br/>RISES &amp; W.L.O.P. ADIT</b></p> |  | DRAWING NO.  |
|   |  | <b>SD-12</b> |

|                     |                     |                 |
|---------------------|---------------------|-----------------|
| Brought up to date: | Mine Manager        | Chief Surveyor. |
| 31-12-57.           | <i>G. S. Hedges</i> | <i>ell</i>      |
| 31-12-58.           | <i>G. S. Hedges</i> | <i>ell</i>      |

COMPLETED