
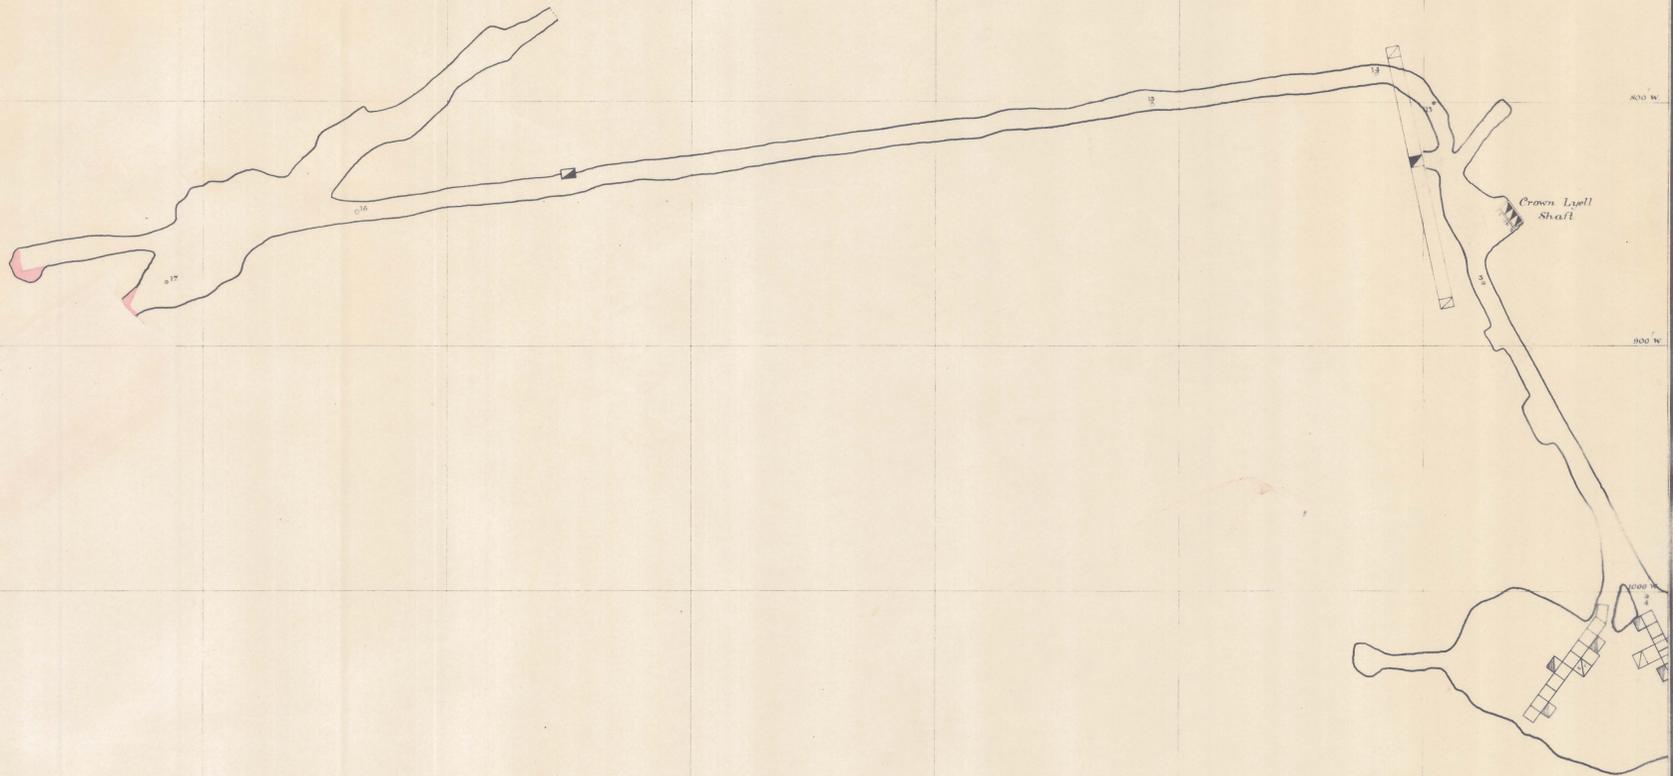


LS-138

LS-138

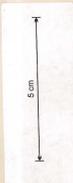

Work for 1959

BROUGHT UP TO DATE.	MINE MANAGER	CHIEF SURVEYOR.
31 st December 1959.	<i>[Signature]</i>	<i>[Signature]</i>

MOUNT LYELL M. & R. COY. LTD.		Drawn by	<i>[Signature]</i>	APPROVED.	
MINE DEPARTMENT		Traced by	<i>[Signature]</i>	Mine Supt.	
Survey by	18 June 1959	Scale	1" = 50ft	Checked by	<i>[Signature]</i>
CROWN LYELL MINE N°6 LEVEL SILL PLAN SHEET 2.				Chief Surv.	
				DRAWING NO.	