


0381-011

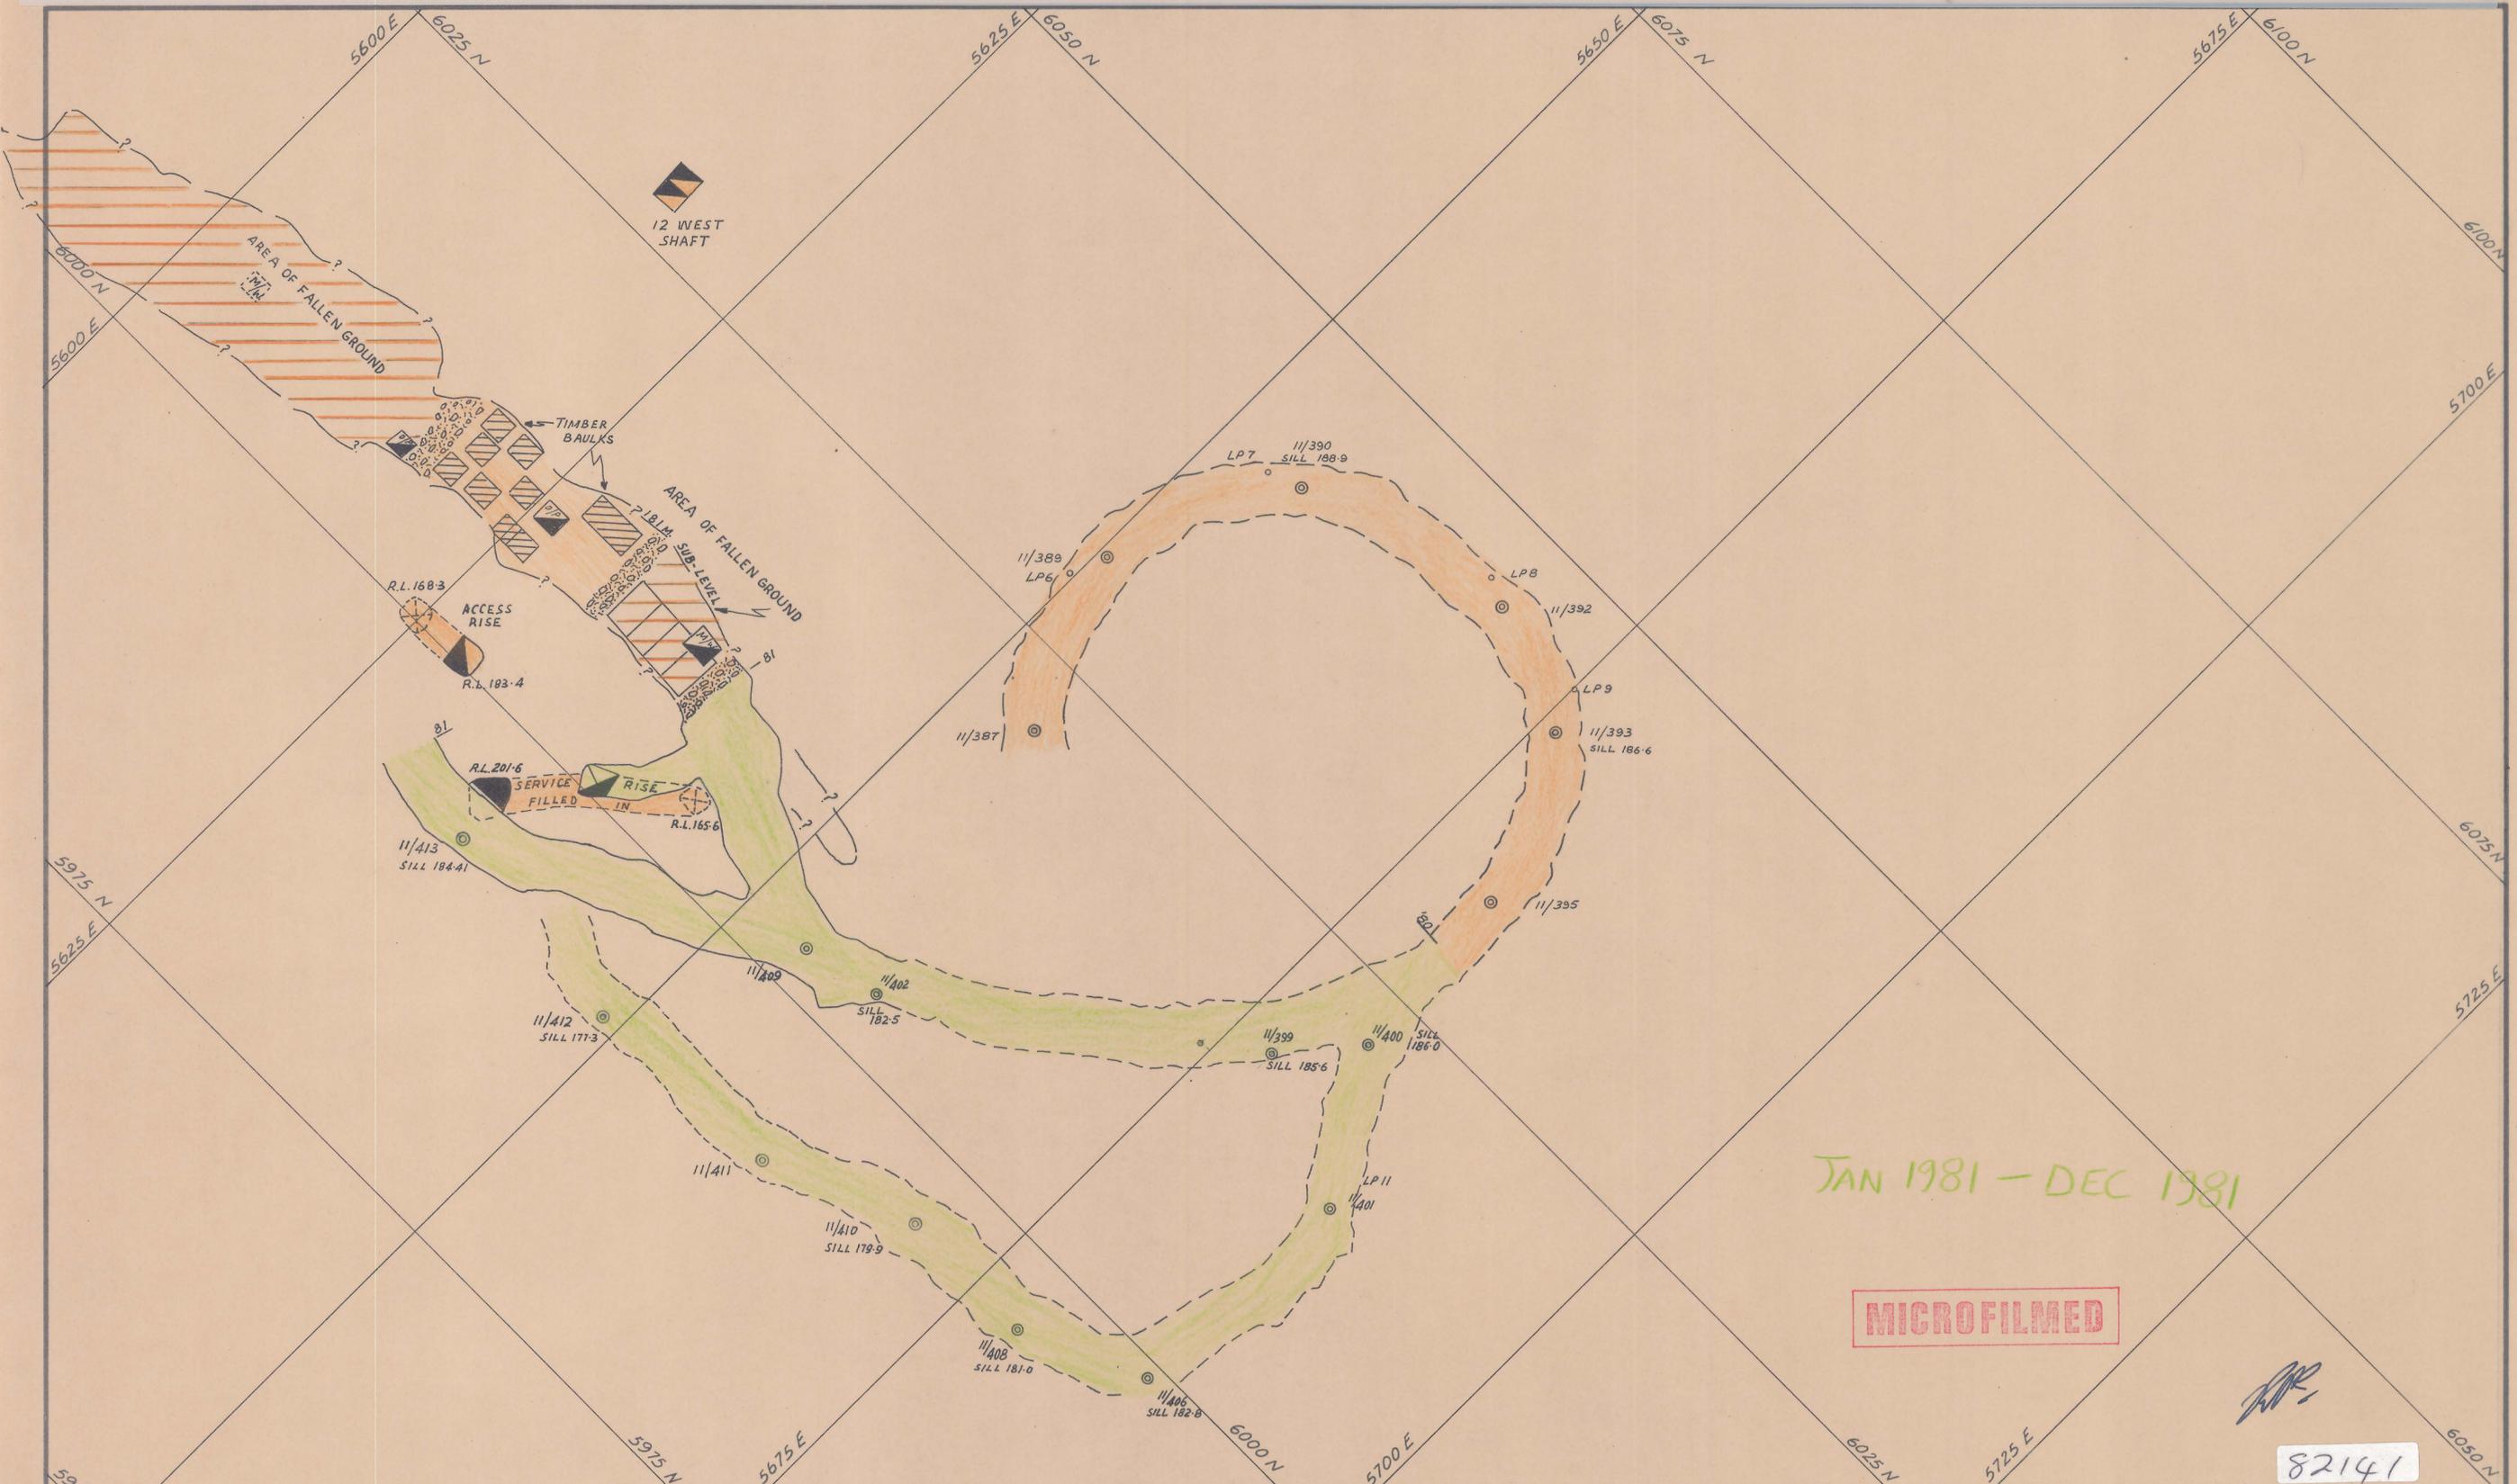

JAN 1981 - DEC 1981

MICROFILMED

*RR*

82141

NO	DATE	APPD	AMENDMENT	MOUNT LYELL M. & R. CO. LTD.		Scale	1:250	Surveyed	APPROVED	DRAWING NO	
				MINE DEPARTMENT		Date	MAY 1980	Designed	U/G Mgr	A2-73	
				12 WEST MINE 182 m., 184 m. LEVELS & DECLINE TO 176 m. LEVEL		Drawn	RR	C/M Eng	SHEET NO		
						Traced	C/Survr	Checked	C/Geol		Indexed
						Checked	Mine Supt	Checked			Drawer NO