


6000N

6000N

5600E

5600E


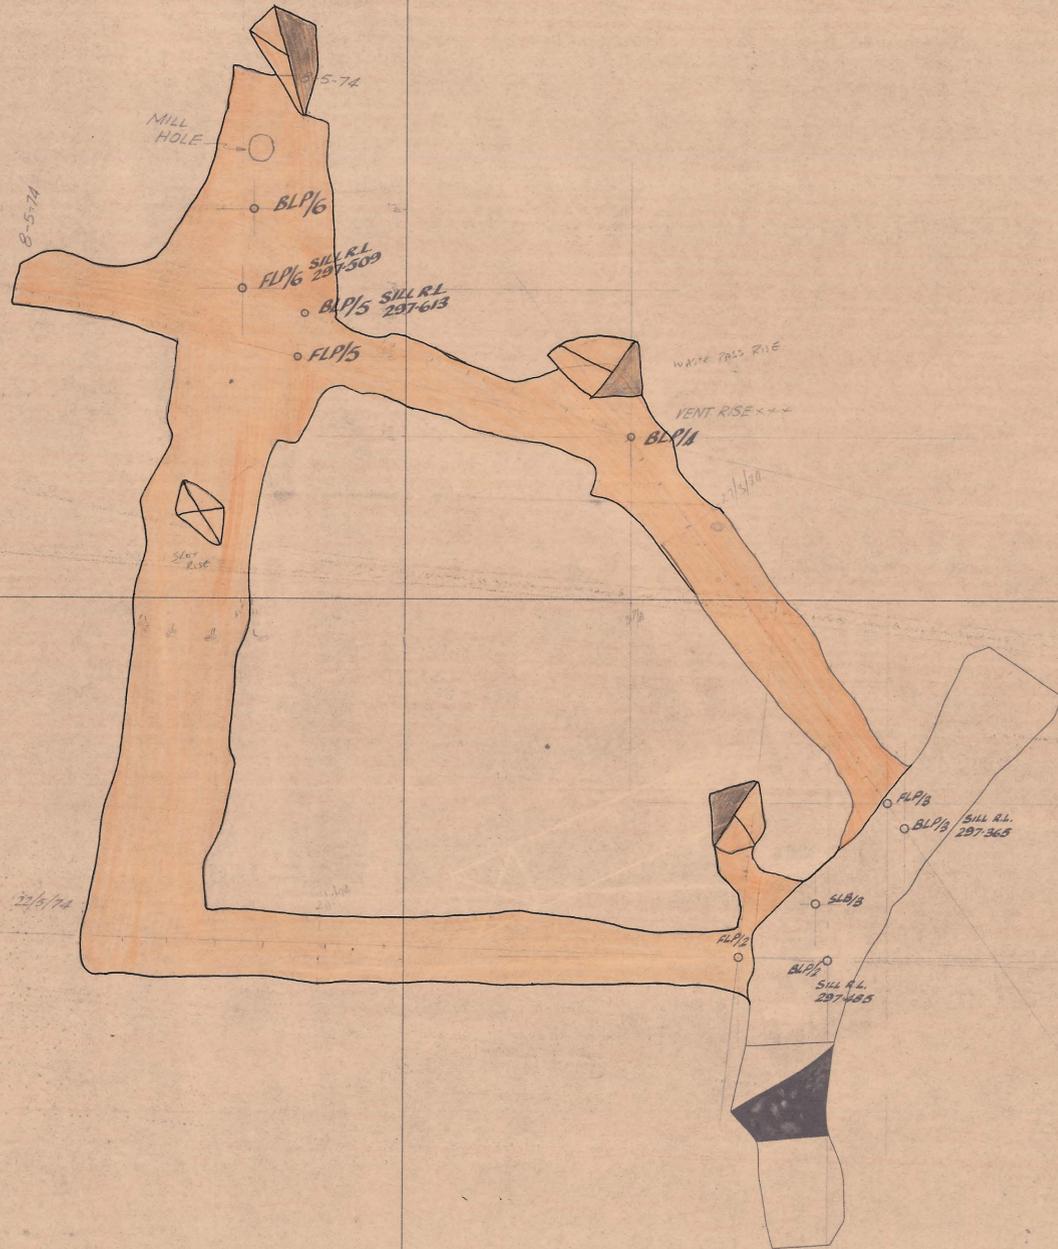


MICROFILMED



NOTE: ALL MEASUREMENTS IN METRES

0381_051

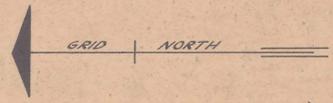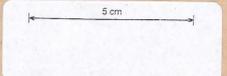

NO	DATE	APPD	APPD	APPD	AMENDMENT

MOUNT LYELL M. & R. CO. LTD.
MINE DEPARTMENT

CROWN LYELL MINE
299m.SUB-LEVEL SILL PLAN

Scale: 1:100
Date: NOVEMBER '73

Surveyed: U/G Mgr.
Designed: C/M Eng.
Drawn: I.R.G.
Traced: J.M.B.
Checked: C/Geol.
Checked: Mine Supt. *[Signature]*

APPROVED

DRAWING N^o
AI-420

SHEET N^o
Indexed
DRAWN BY J.M.B.