


Scale 100' = 1 inch.

Reference.

Heavy Black and dotted lines show boundaries Upper-Lower benches 30/6/26
 Heavy Red and dotted " " " " " " " " 30/6/27
 O Represent BORES put down from 30/6/26 to 30/6/27
 Bore values are shown in Green in lbs per cub. yd.
 Bore depths " " at the right of boreholes.
 Bore numbers " " below boreholes.

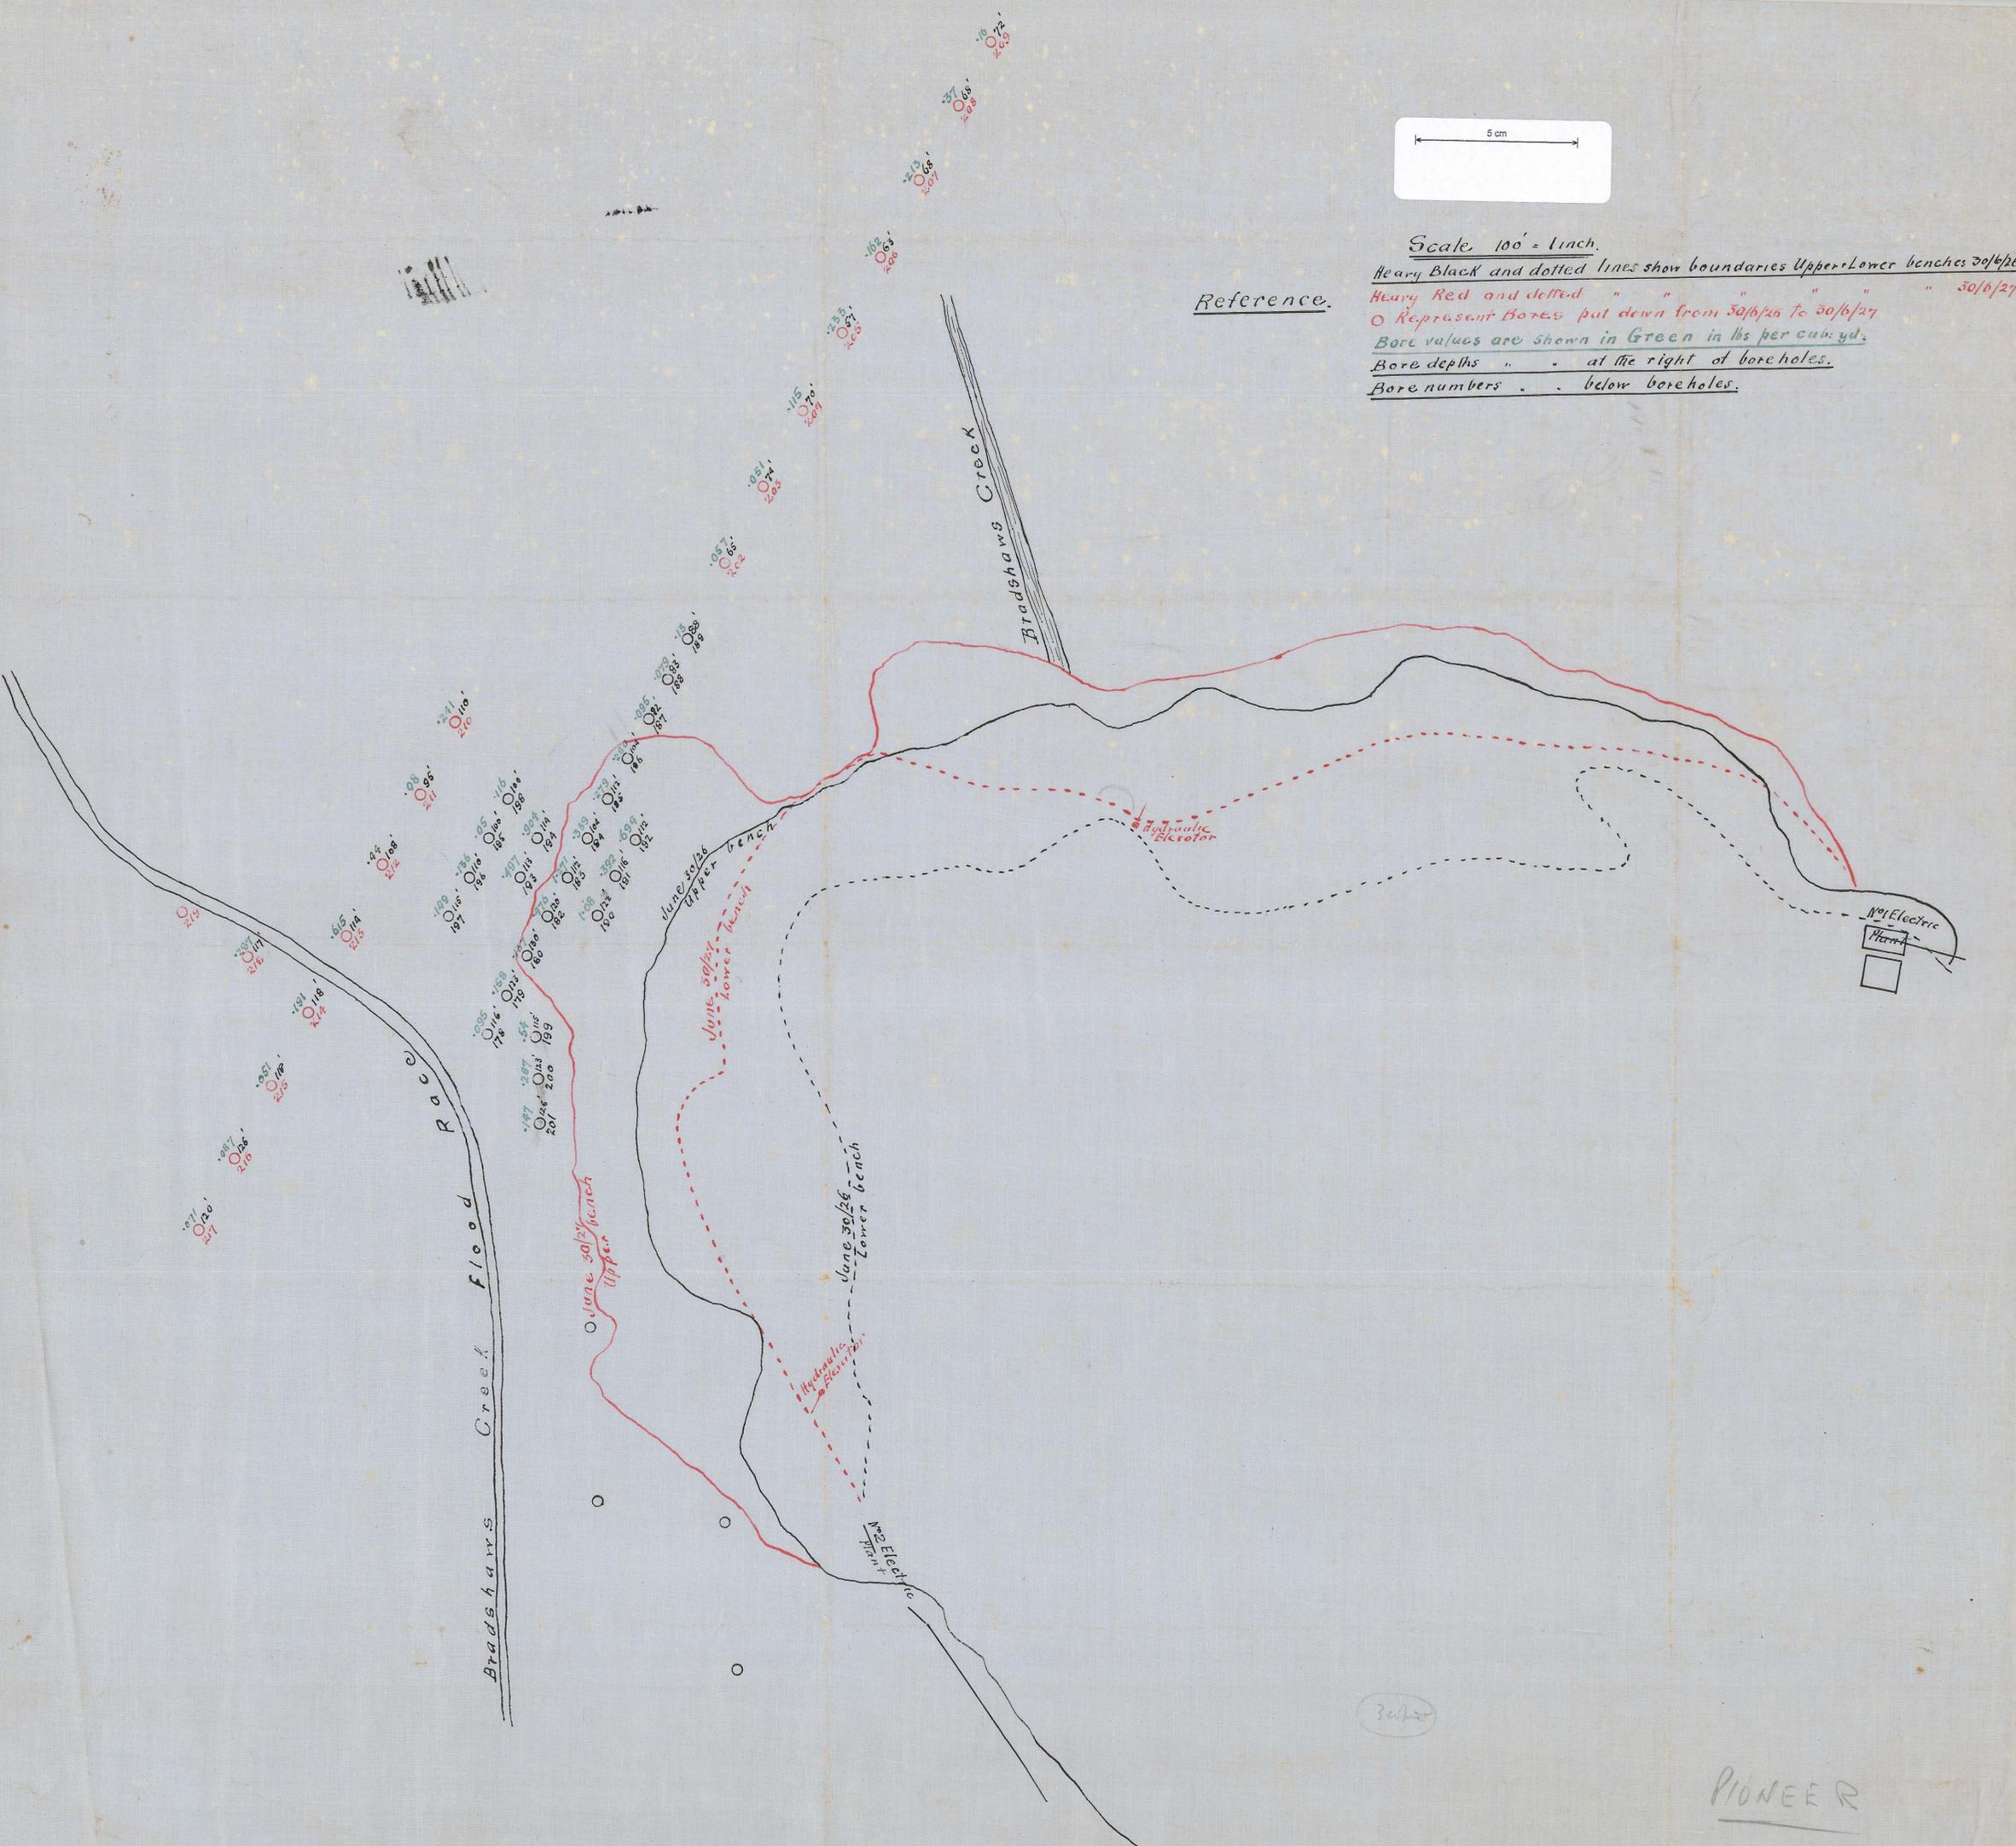

30/6/26

PIONEER