



above 201 g/m³
101-200 g/m³
51-100 g/m³
26-50 g/m³
0-25 g/m³

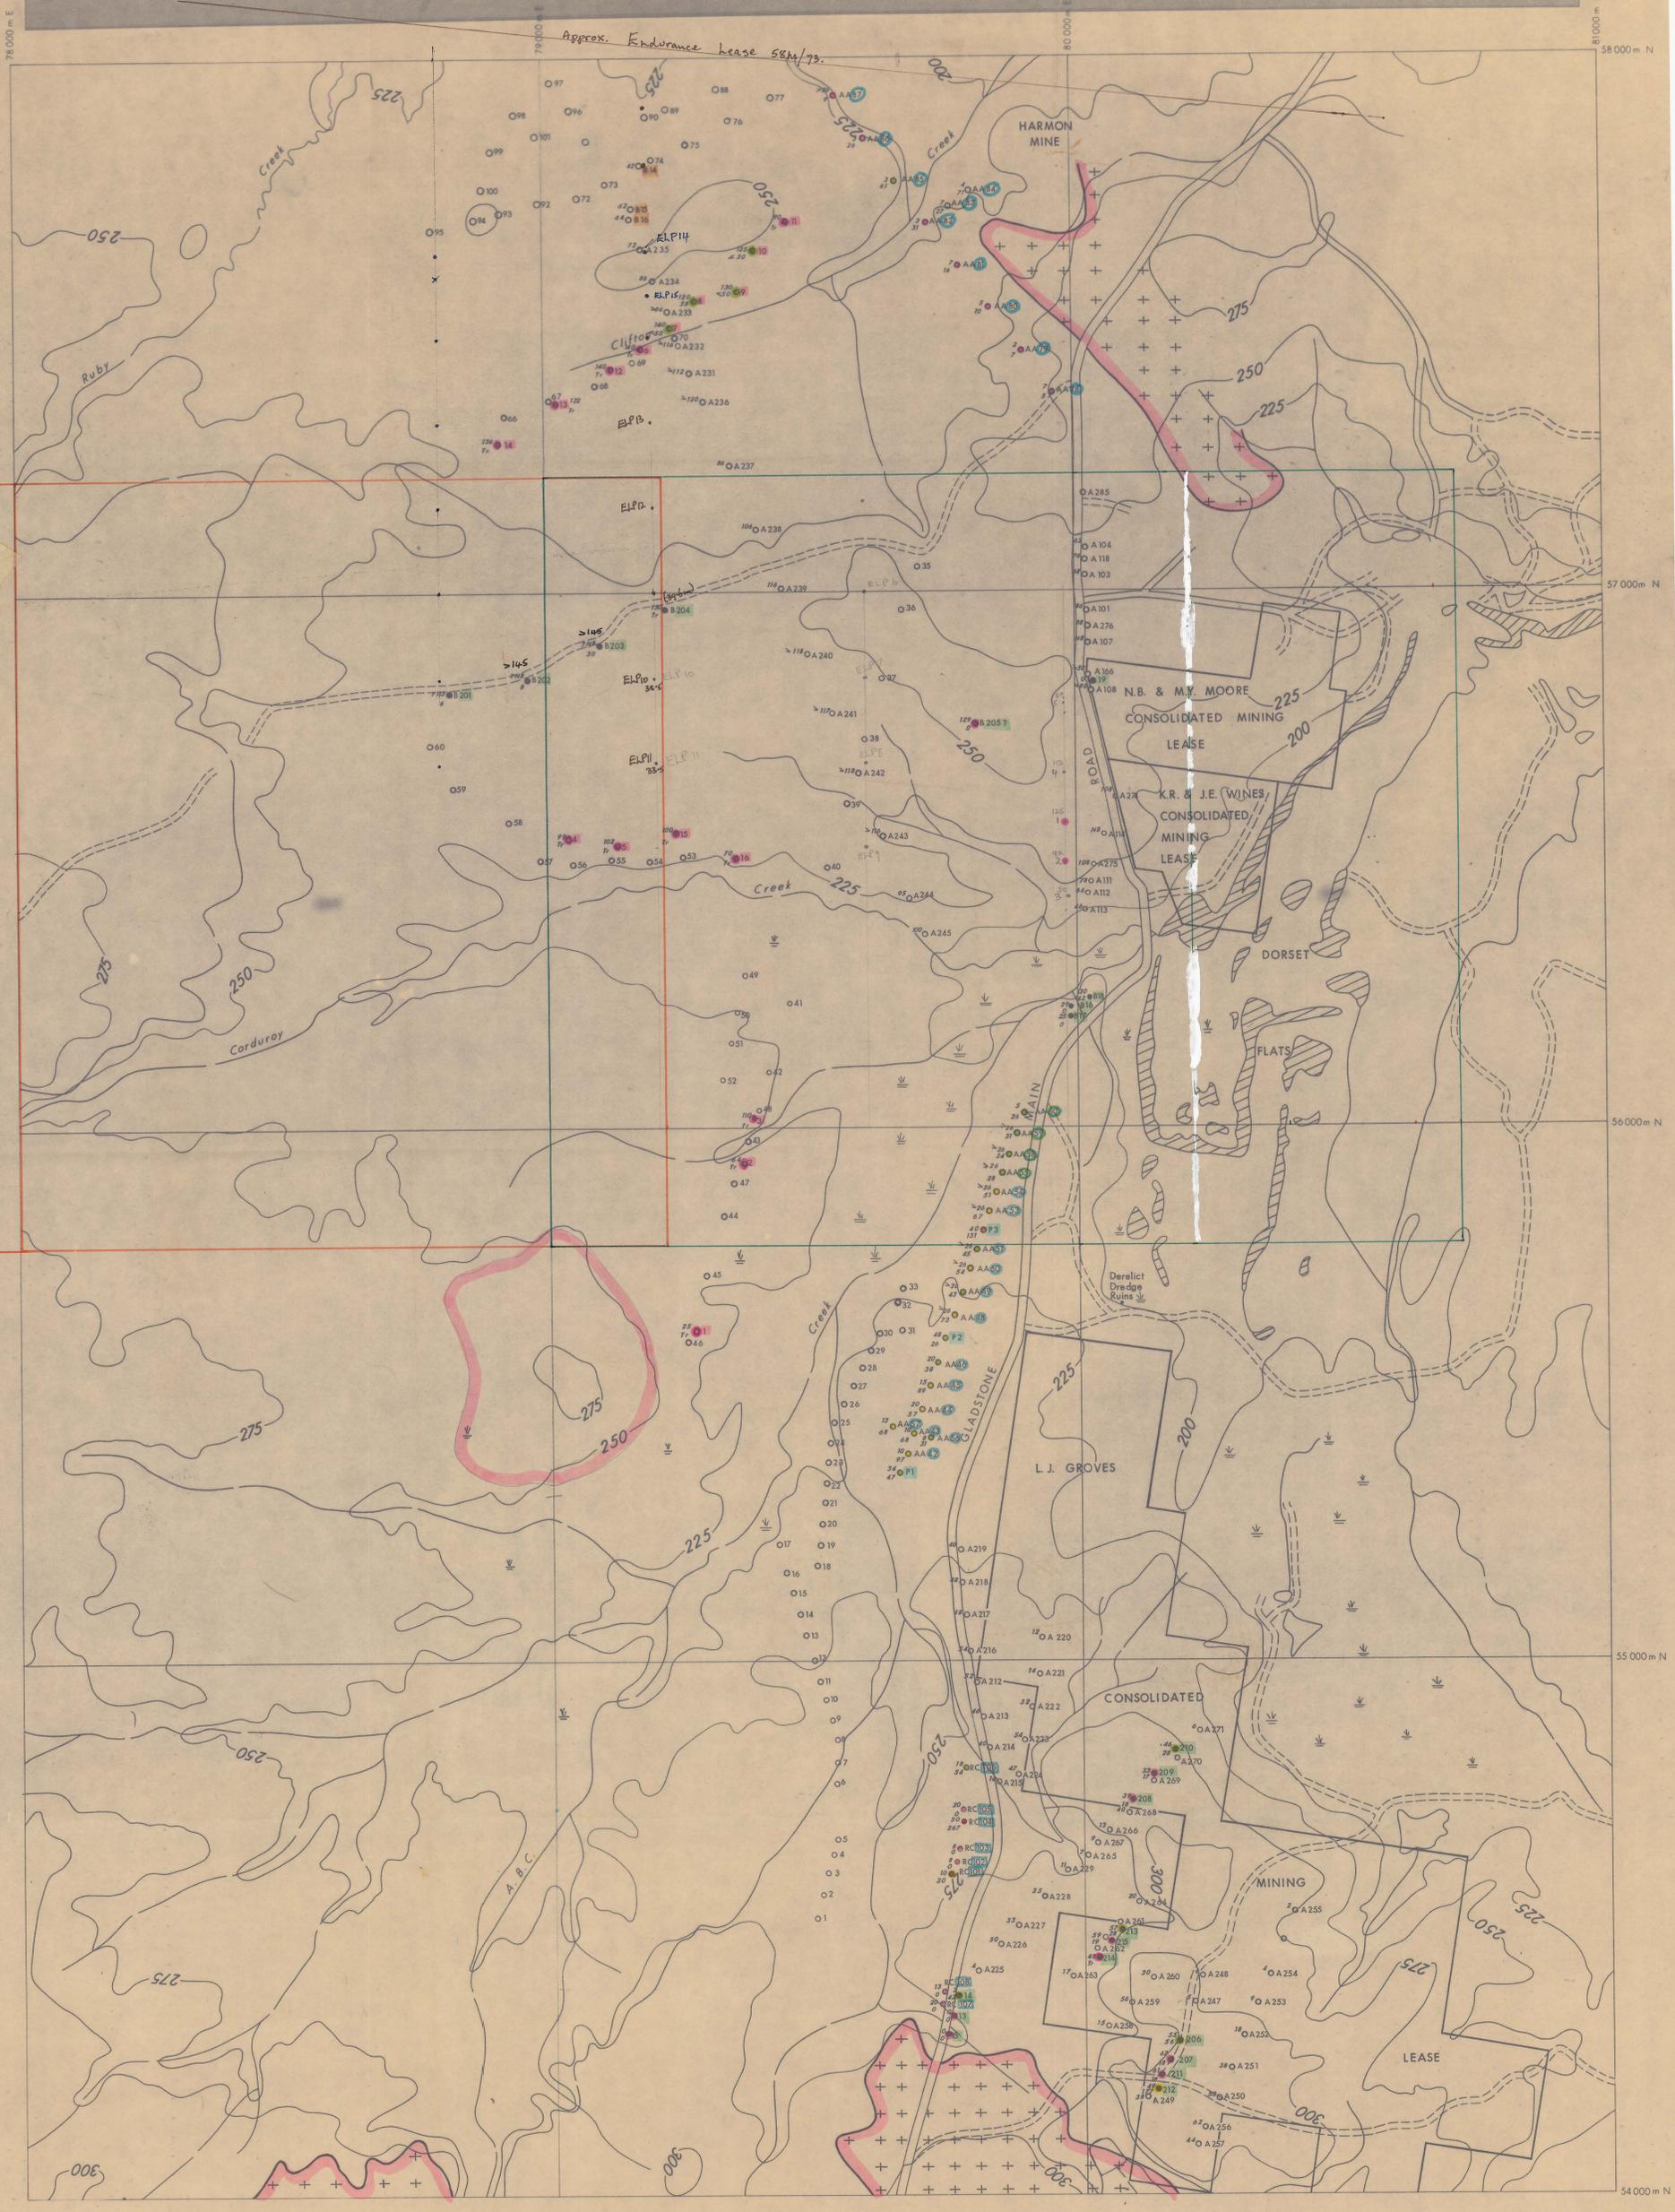

- B15 Mines Dept Drilling
- 212 Utah percussion hole no.
- 5 Geophoto percussion hole no.
- P3 Amdex percussion hole no.
- RC108 Amdex reverse circulation hole no. sample
- A249 Utah auger hole no.
- 12 Geophoto auger hole no.
- AA60 Amdex auger hole no. 5" Sample.
- 18 ○ Depth to basement (feet)
- 54 ○ Overall grade (grams Sn O₂/metre³)
- N.B. Not bottomed
- Tr. Trace
- 250 Surface R.L. (feet)
- Road; track
- ≡ Button grass marsh
- ≡ Shallow water - area worked by dredge
- ++ Granite outcrop

50m
0382-011

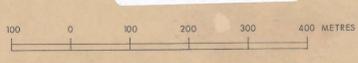

SCALE 1 : 5000

AMDEX MINING LIMITED
E.L. 2/77, TASMANIA

EASTERN LEADS AREA

PREVIOUS DRILLING: AUGUST 1980