

52800 N

52800 N

77100 E

77200 E

77300 E

77400 E

52700 N

52700 N

52600 N


52600 N

77100 E

77200 E

77300 E

77400 E

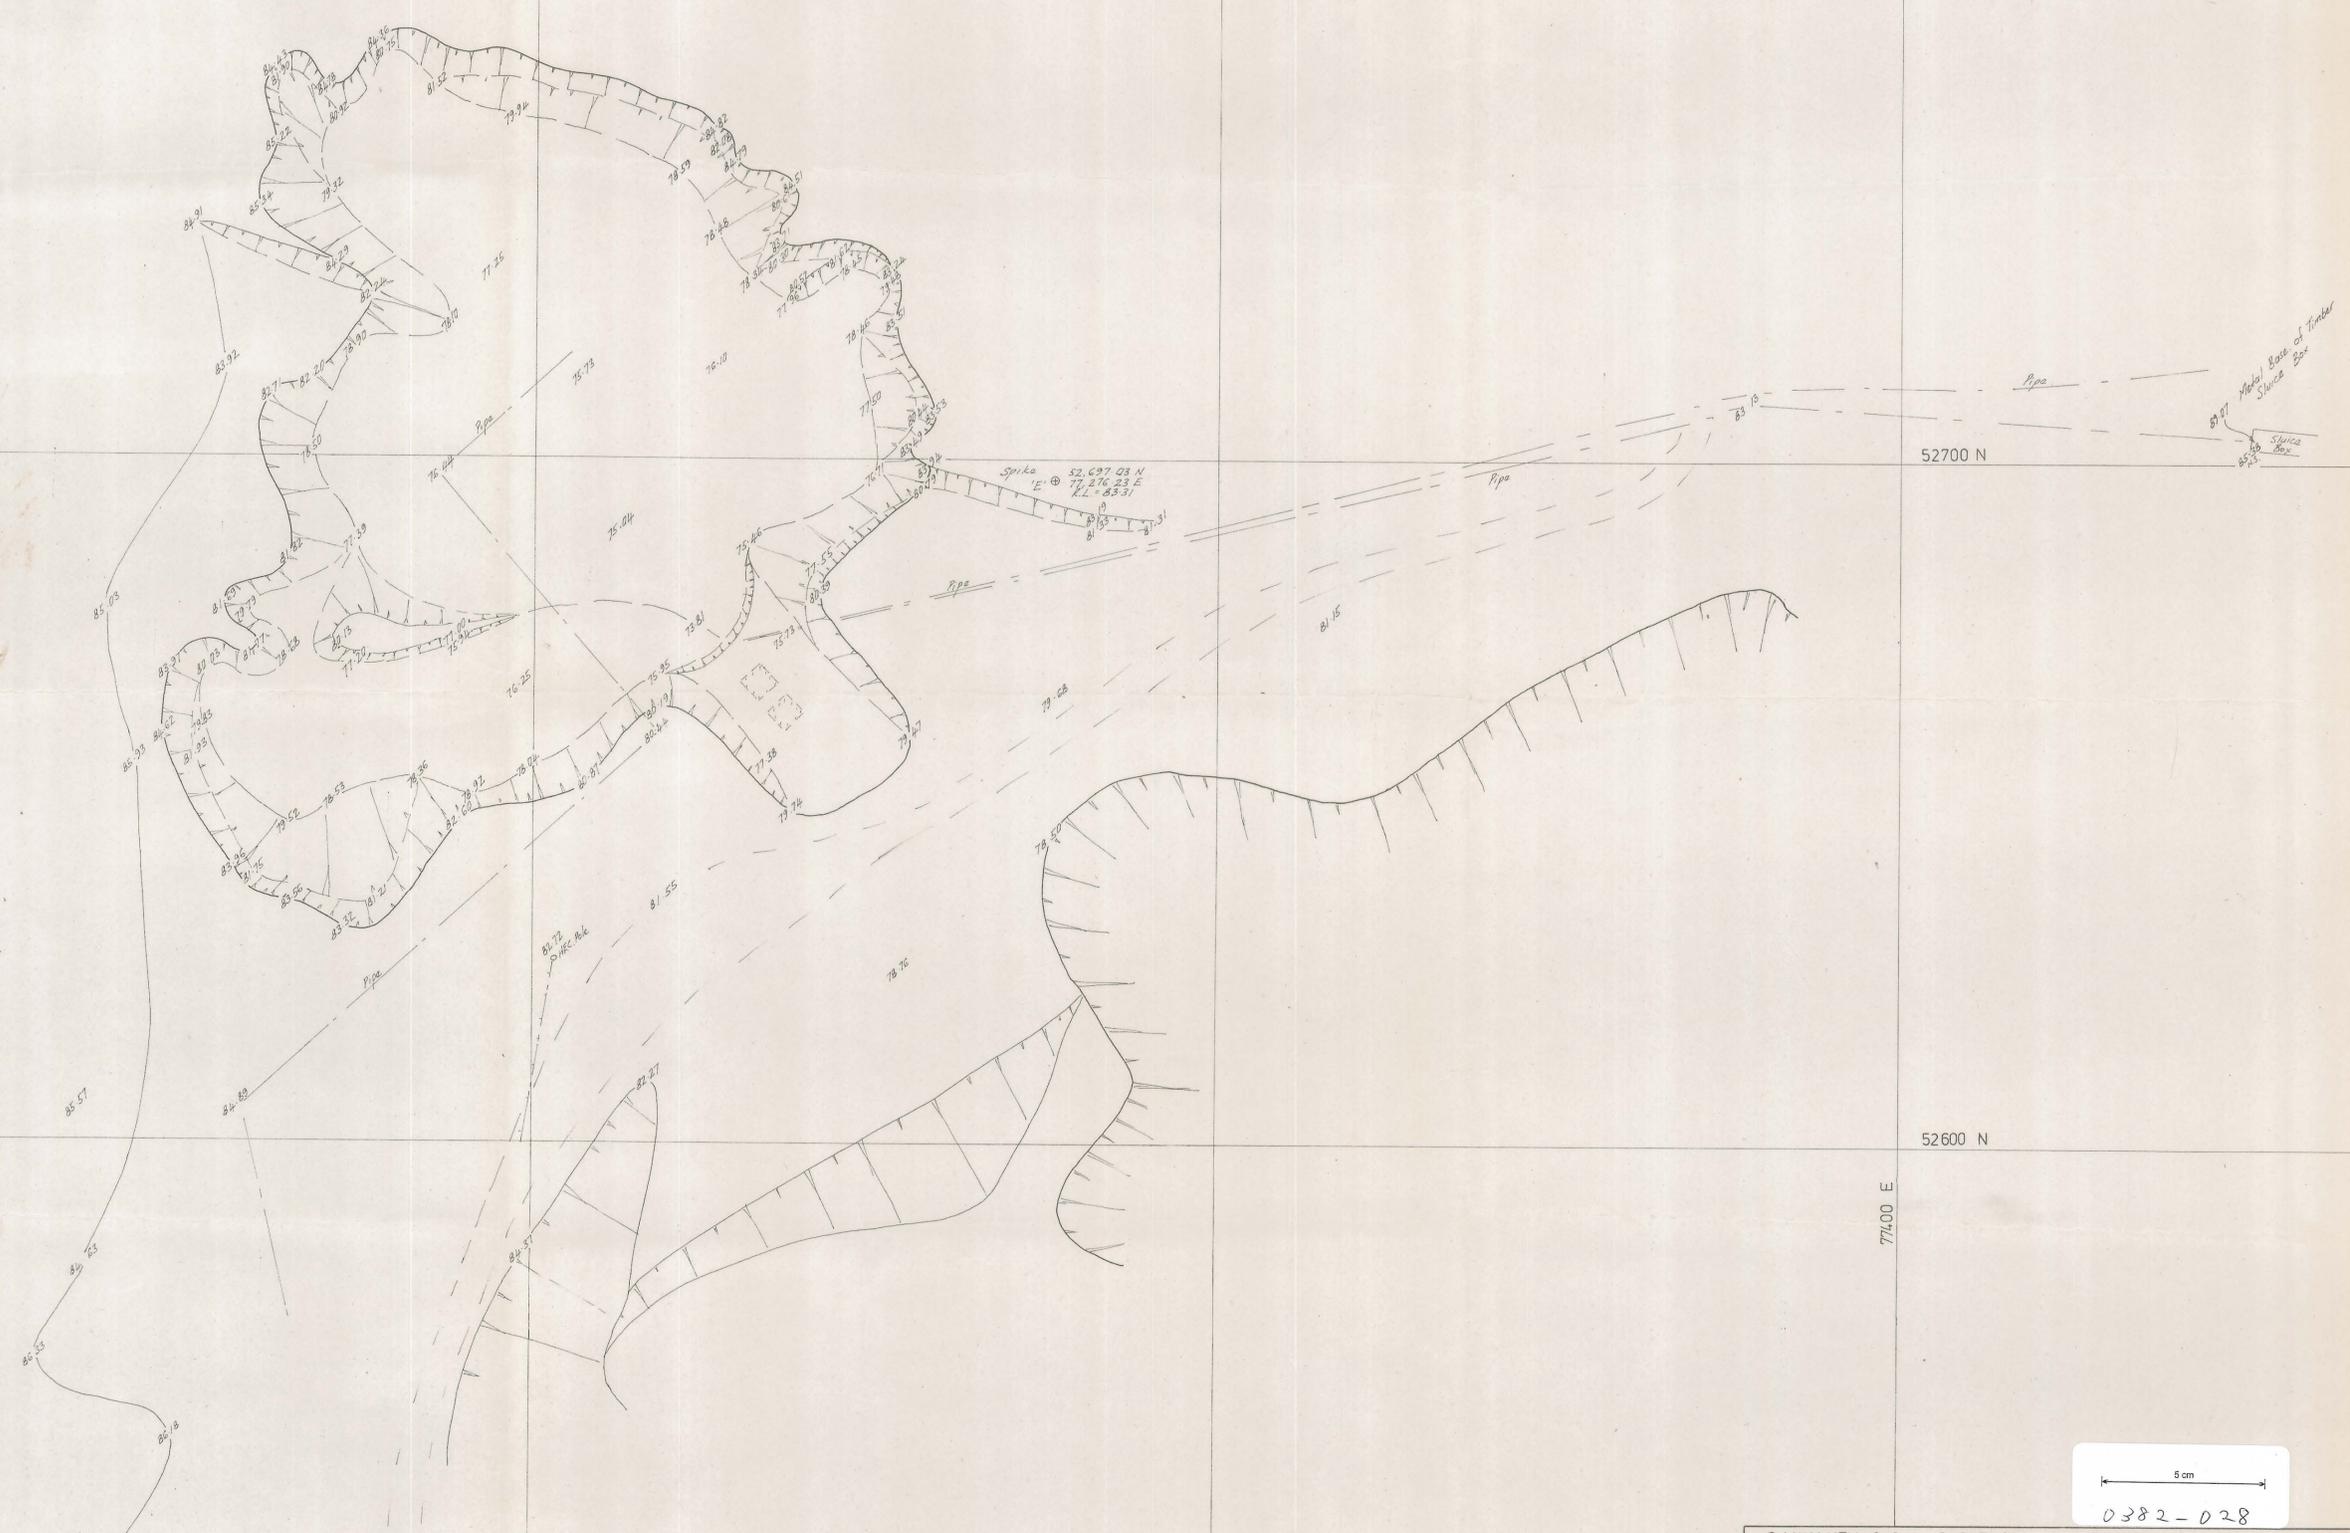

0382-028

G.J. WALKEM & Co, SURVEYORS & PLANNERS	LAUNCESTON 312428
DETAIL PLAN	DATE 7 <sup>th</sup> OCT. 1980
AMDEX MINING LIMITED	SCALE 1:500
PIONEER TIN MINE	DRAWN A.C.C.
	REF. No. 1417/2 D
	REGISTERED SURVEYOR

0382-028

7.10.1980