


SURVEY 1981

0382_040

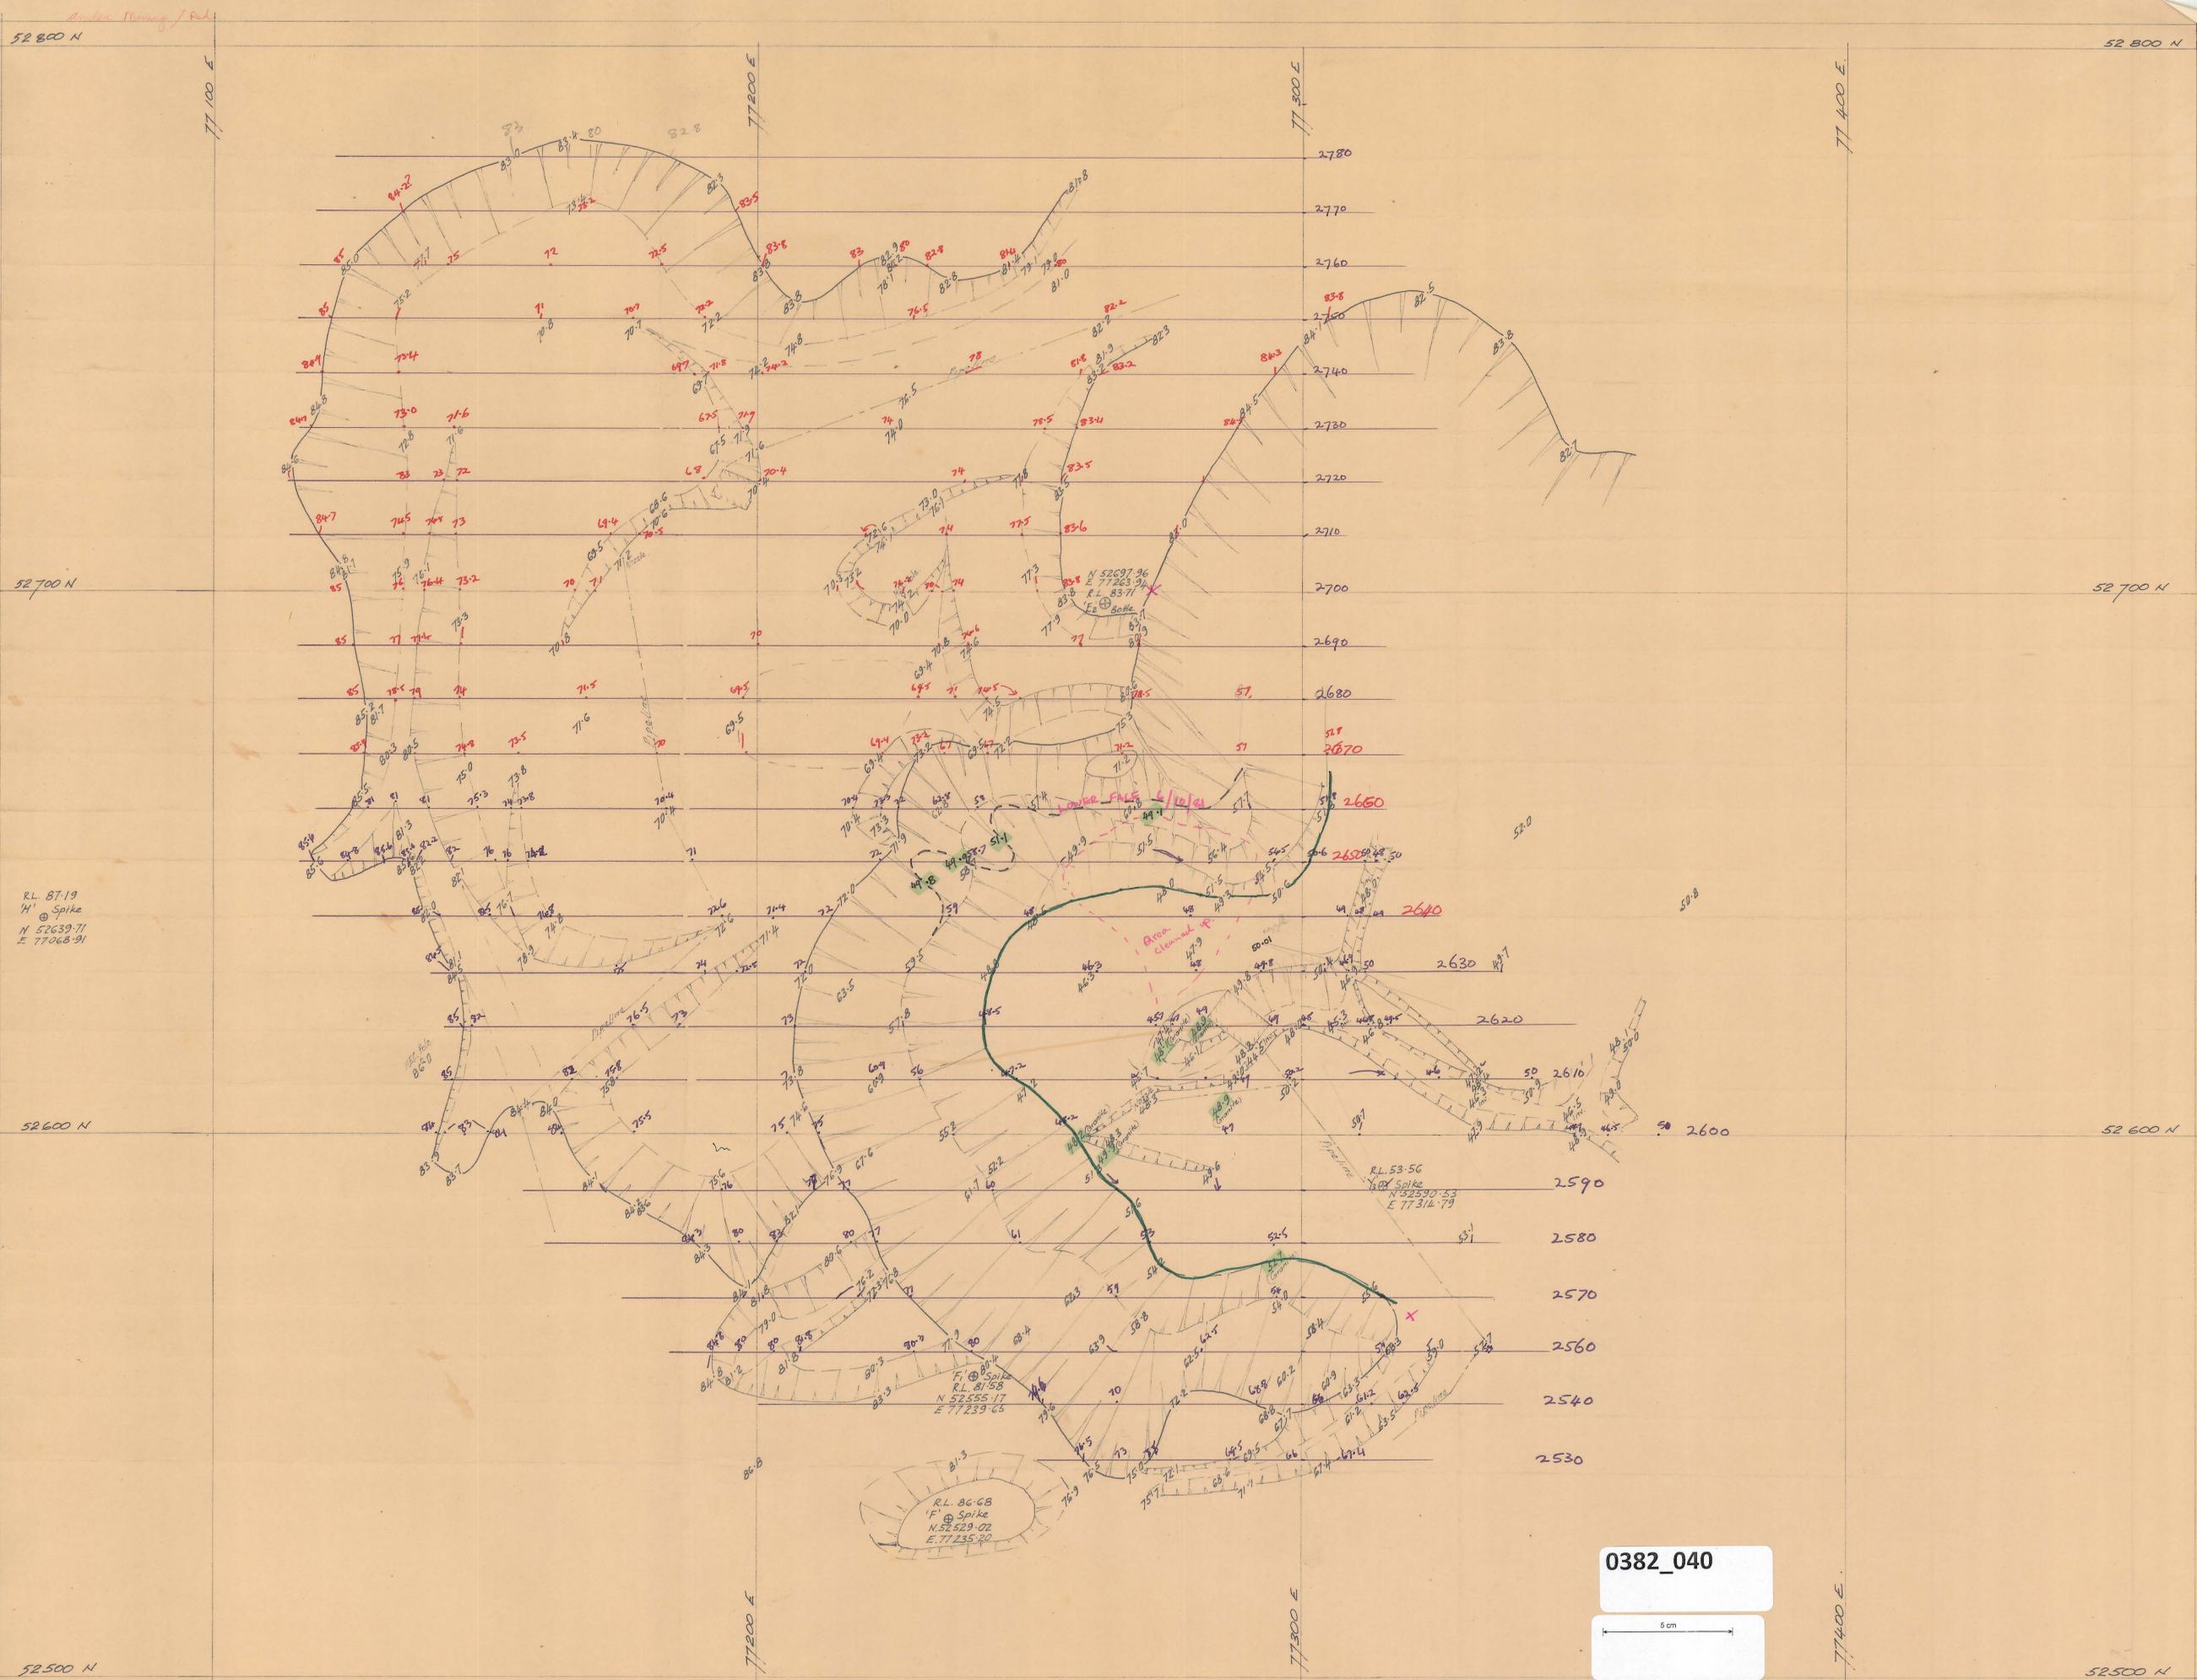

RL 87.19
 'F' @ Spike
 N 52639.71
 E 77268.91

RL 53.56
 'F' @ Spike
 N 52590.53
 E 77312.79

RL 86.68
 'F' @ Spike
 N 52529.02
 E 77235.20

RL 89.35
 @ Lenset in Conc. Step
 N 52488.32
 E 77202.17

0382_040

5 cm

G. J. WALKER & CO SURVEYORS & PLANNERS. 22 ELIZABETH STREET, LAUNCESTON TAS. 7250. PH. 003 31 2428.		
DETAIL & LEVEL SURVEY	DRN A.C.C.	<i>P. J. Gray</i>
PIONEER TILT MINE.	DATE 1.9.1981	REGISTERED SURVEYOR
AMDEX MINING LIMITED.	SCALE 1:500.	REF. L1417/20.

granite outcrop